FILED
RECEIVED
JUN 8 1971
COUNTY SURVEYOR
DOUGLAS COUNTY, ORE.

M 41-66

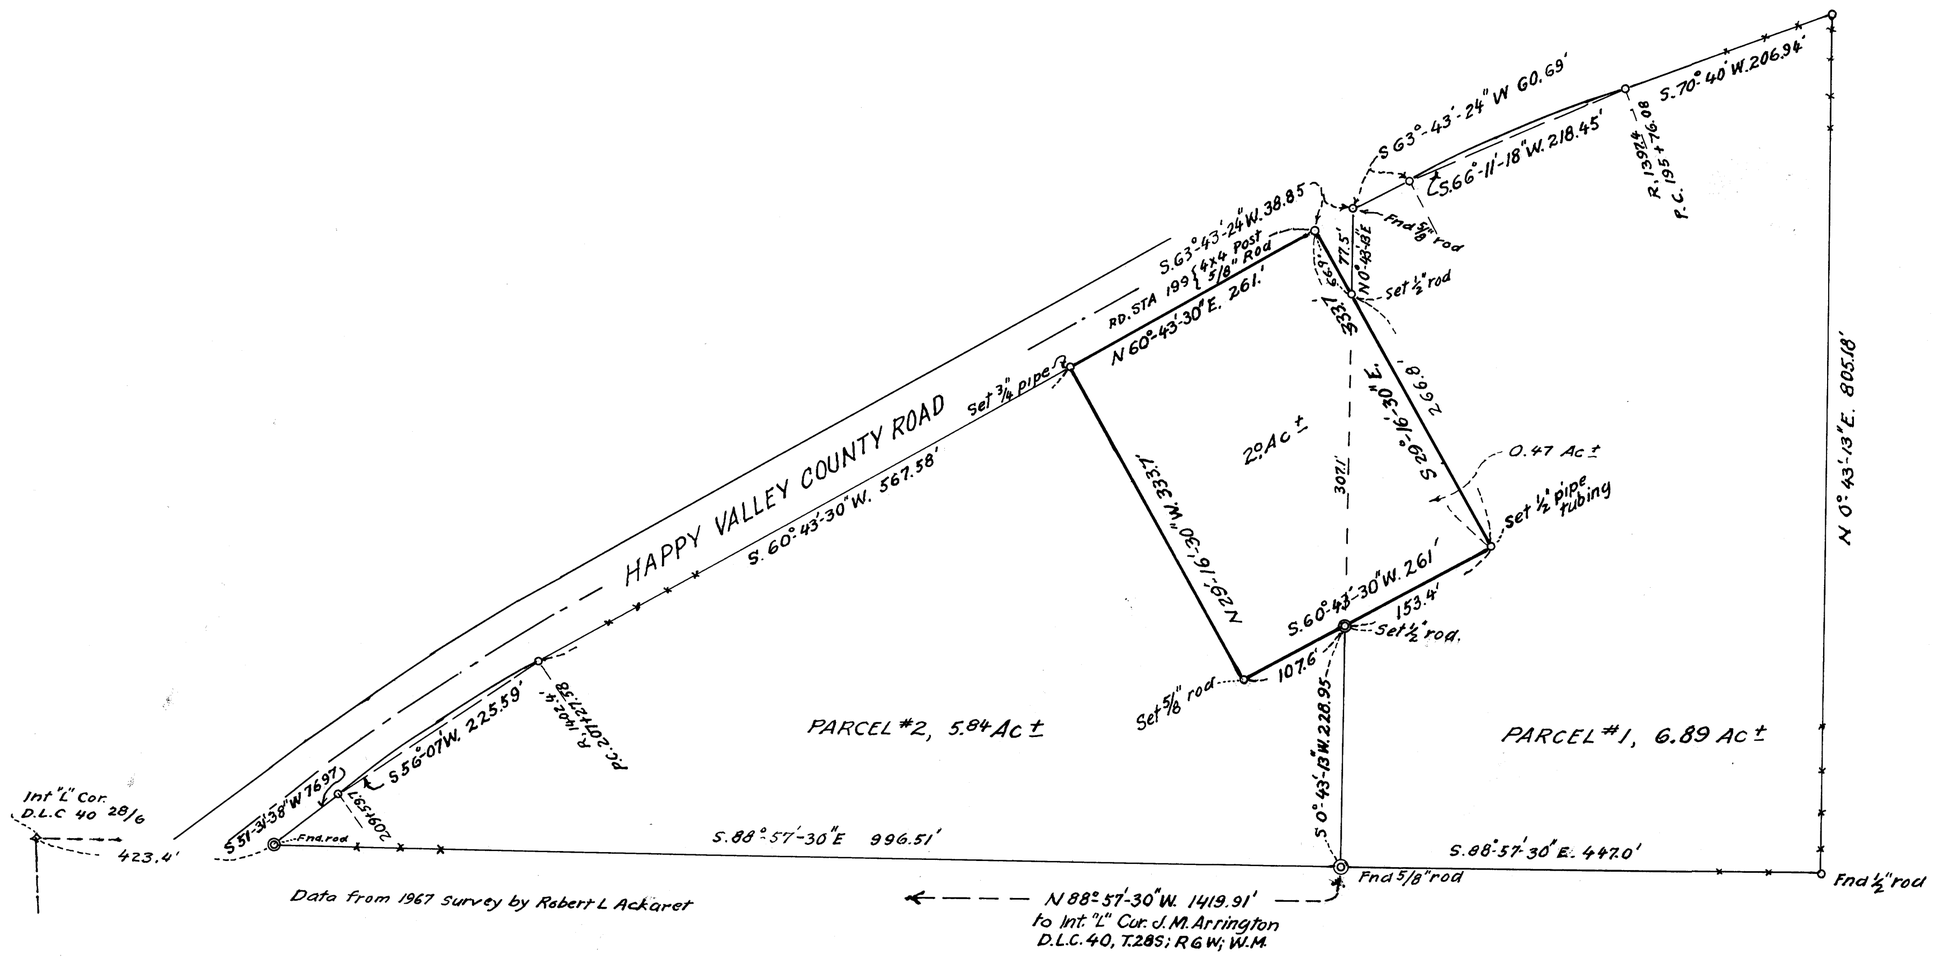

GARY BUCHHOLZ & WF.
RT. 4, BOX 547, ROSEBURG, ORE.

ACREAGES IN SECS. 6 & 7, T.28S; R.6W; W.M;
DOUGLAS COUNTY, ORE.

JUNE, 1971 AB. 1" = 100 ft

COUNTY SURVEYORS FILE
DO NOT REMOVE FROM OFFICE

M 41-66