COUNTY SURVEYORS FILE
DO NOT REMOVE FROM OFFIC

MAP FILE M 41-72

PROPERTY SURVEY FOR RALPH HORN

FROM PROPERTY DESCRIPTION IN
SW 1/4, SEC. 15, T. 22S, R. 9W, W.M.

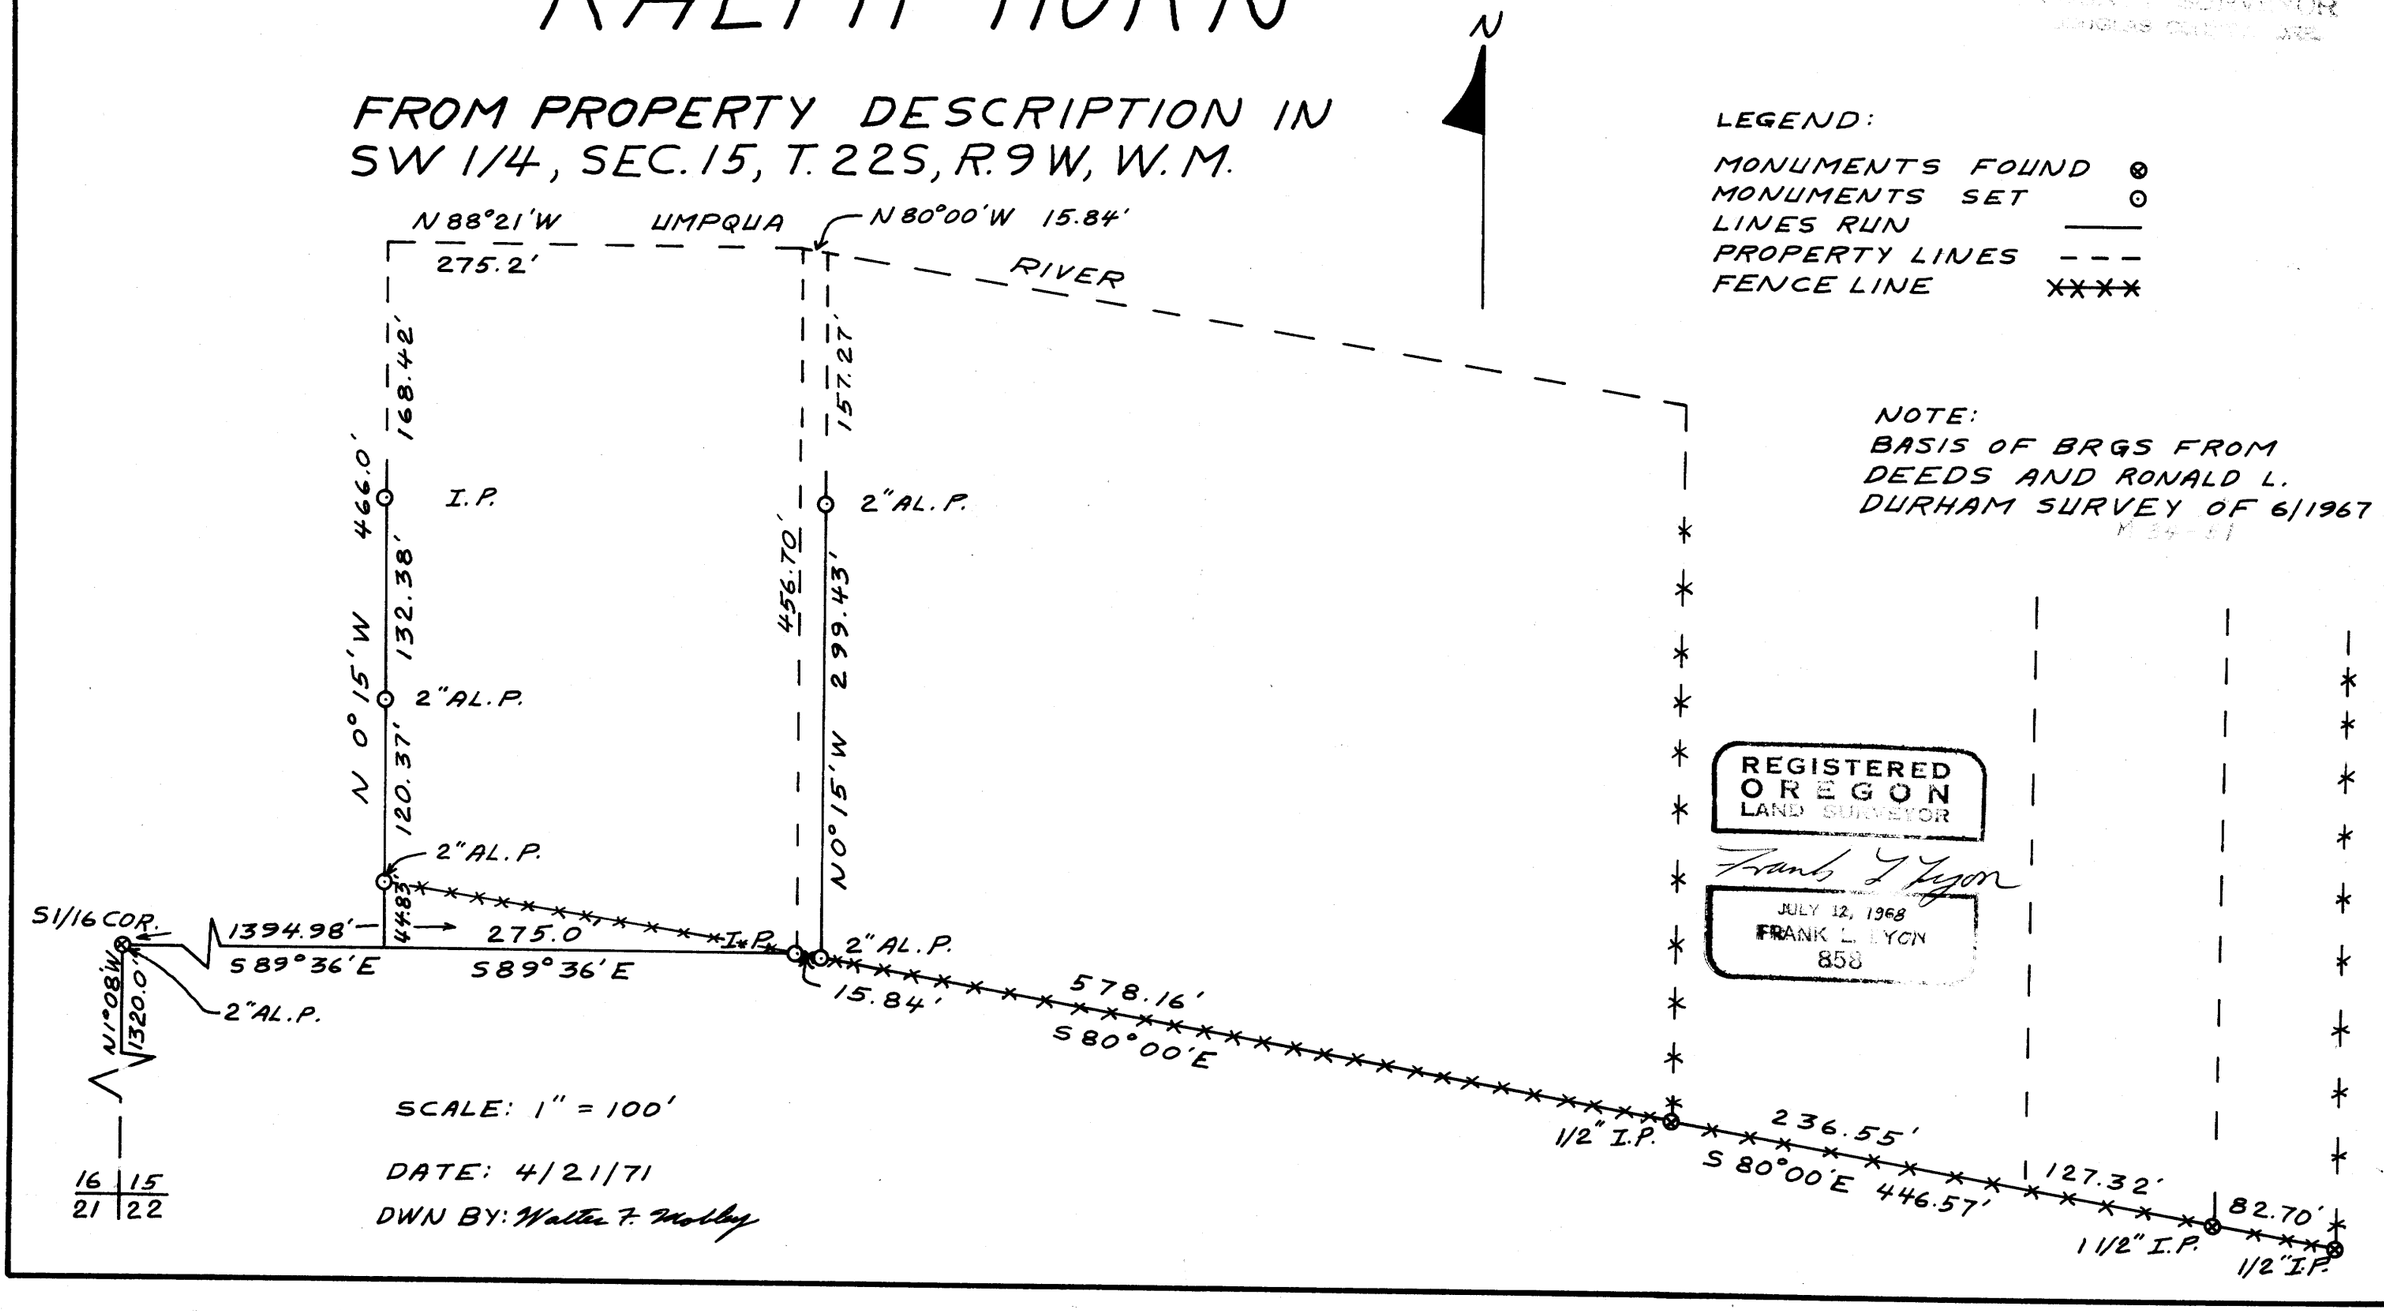

MAP FILE M 41-72