ROAD EASEMENT SURVEY IN SECTIONS 9, 10, 15, & 16, T29S, R6W, W.M., DOUGLAS COUNTY, ORE.

Surveyed for Willis Creek Properties, Inc. by Victor M. McLind

June 1971

COUNTY SURVEYORS FILE DATA
DO NOT REMOVE FROM OFFICE

Scale : 1" = 300'

Bearings based on Solar Observation April 1, 1971

o Indicates Set 5/8" Iron Rod

FILED
RECEIVED
JUN 22 1971
COUNTY SURVEYOR
DOUGLAS COUNTY, ORE.

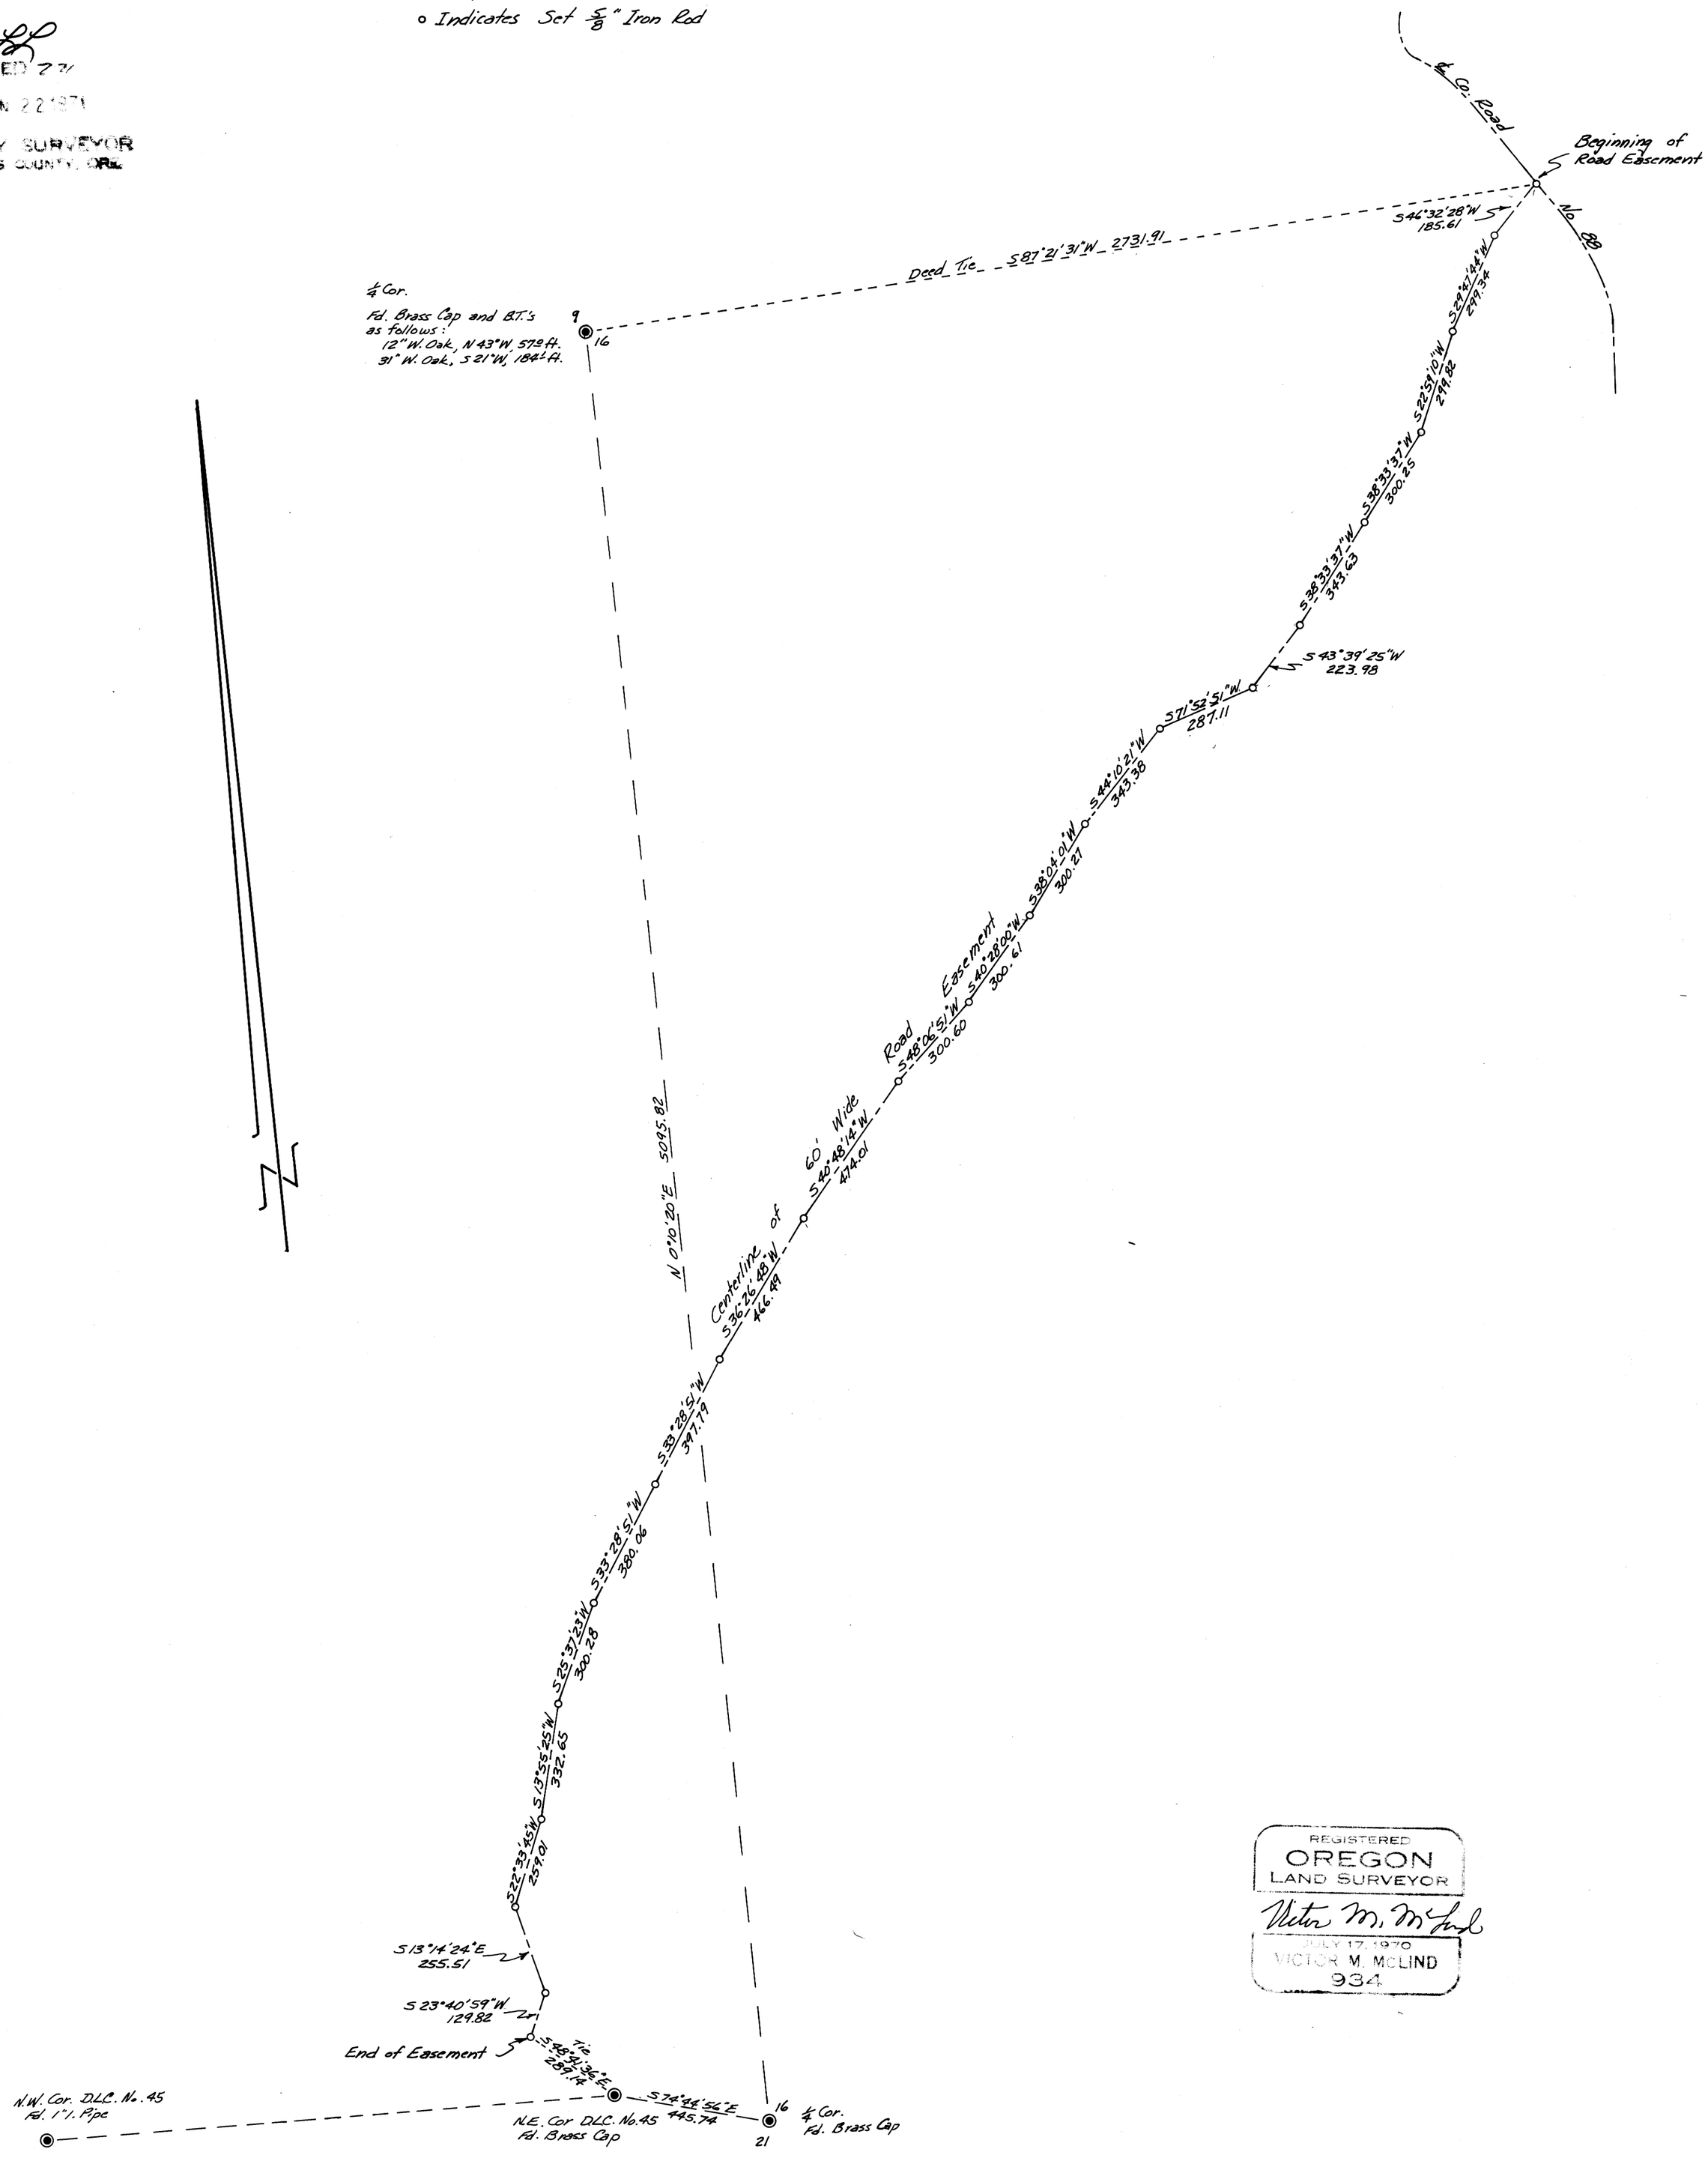

REGISTERED
OREGON
LAND SURVEYOR
Victor M. McLind
JULY 17, 1970
VICTOR M. MCLIND
934

SEE VACATION PART OF ROAD 7/26/72 - RALEIGH DRIVE
CLERK'S OFFICE