SURVEY FOR DEED DESCRIPTION
IN SECTIONS 20, 29 & 30, T.24S., R.6 W.W.M.
FOR BOWLES REALTY
by BRUCE ROGERS
JAN, 1971
1" = 300'

FILED
RECEIVED
JAN 27 1971
COUNTY SURVEYOR
DOUGLAS COUNTY, ORE.

M 41-9

REGISTERED
OREGON
LAND SURVEYOR
Bruce R. Rogers
JULY 10, 1964
BRUCE R. ROGERS
660

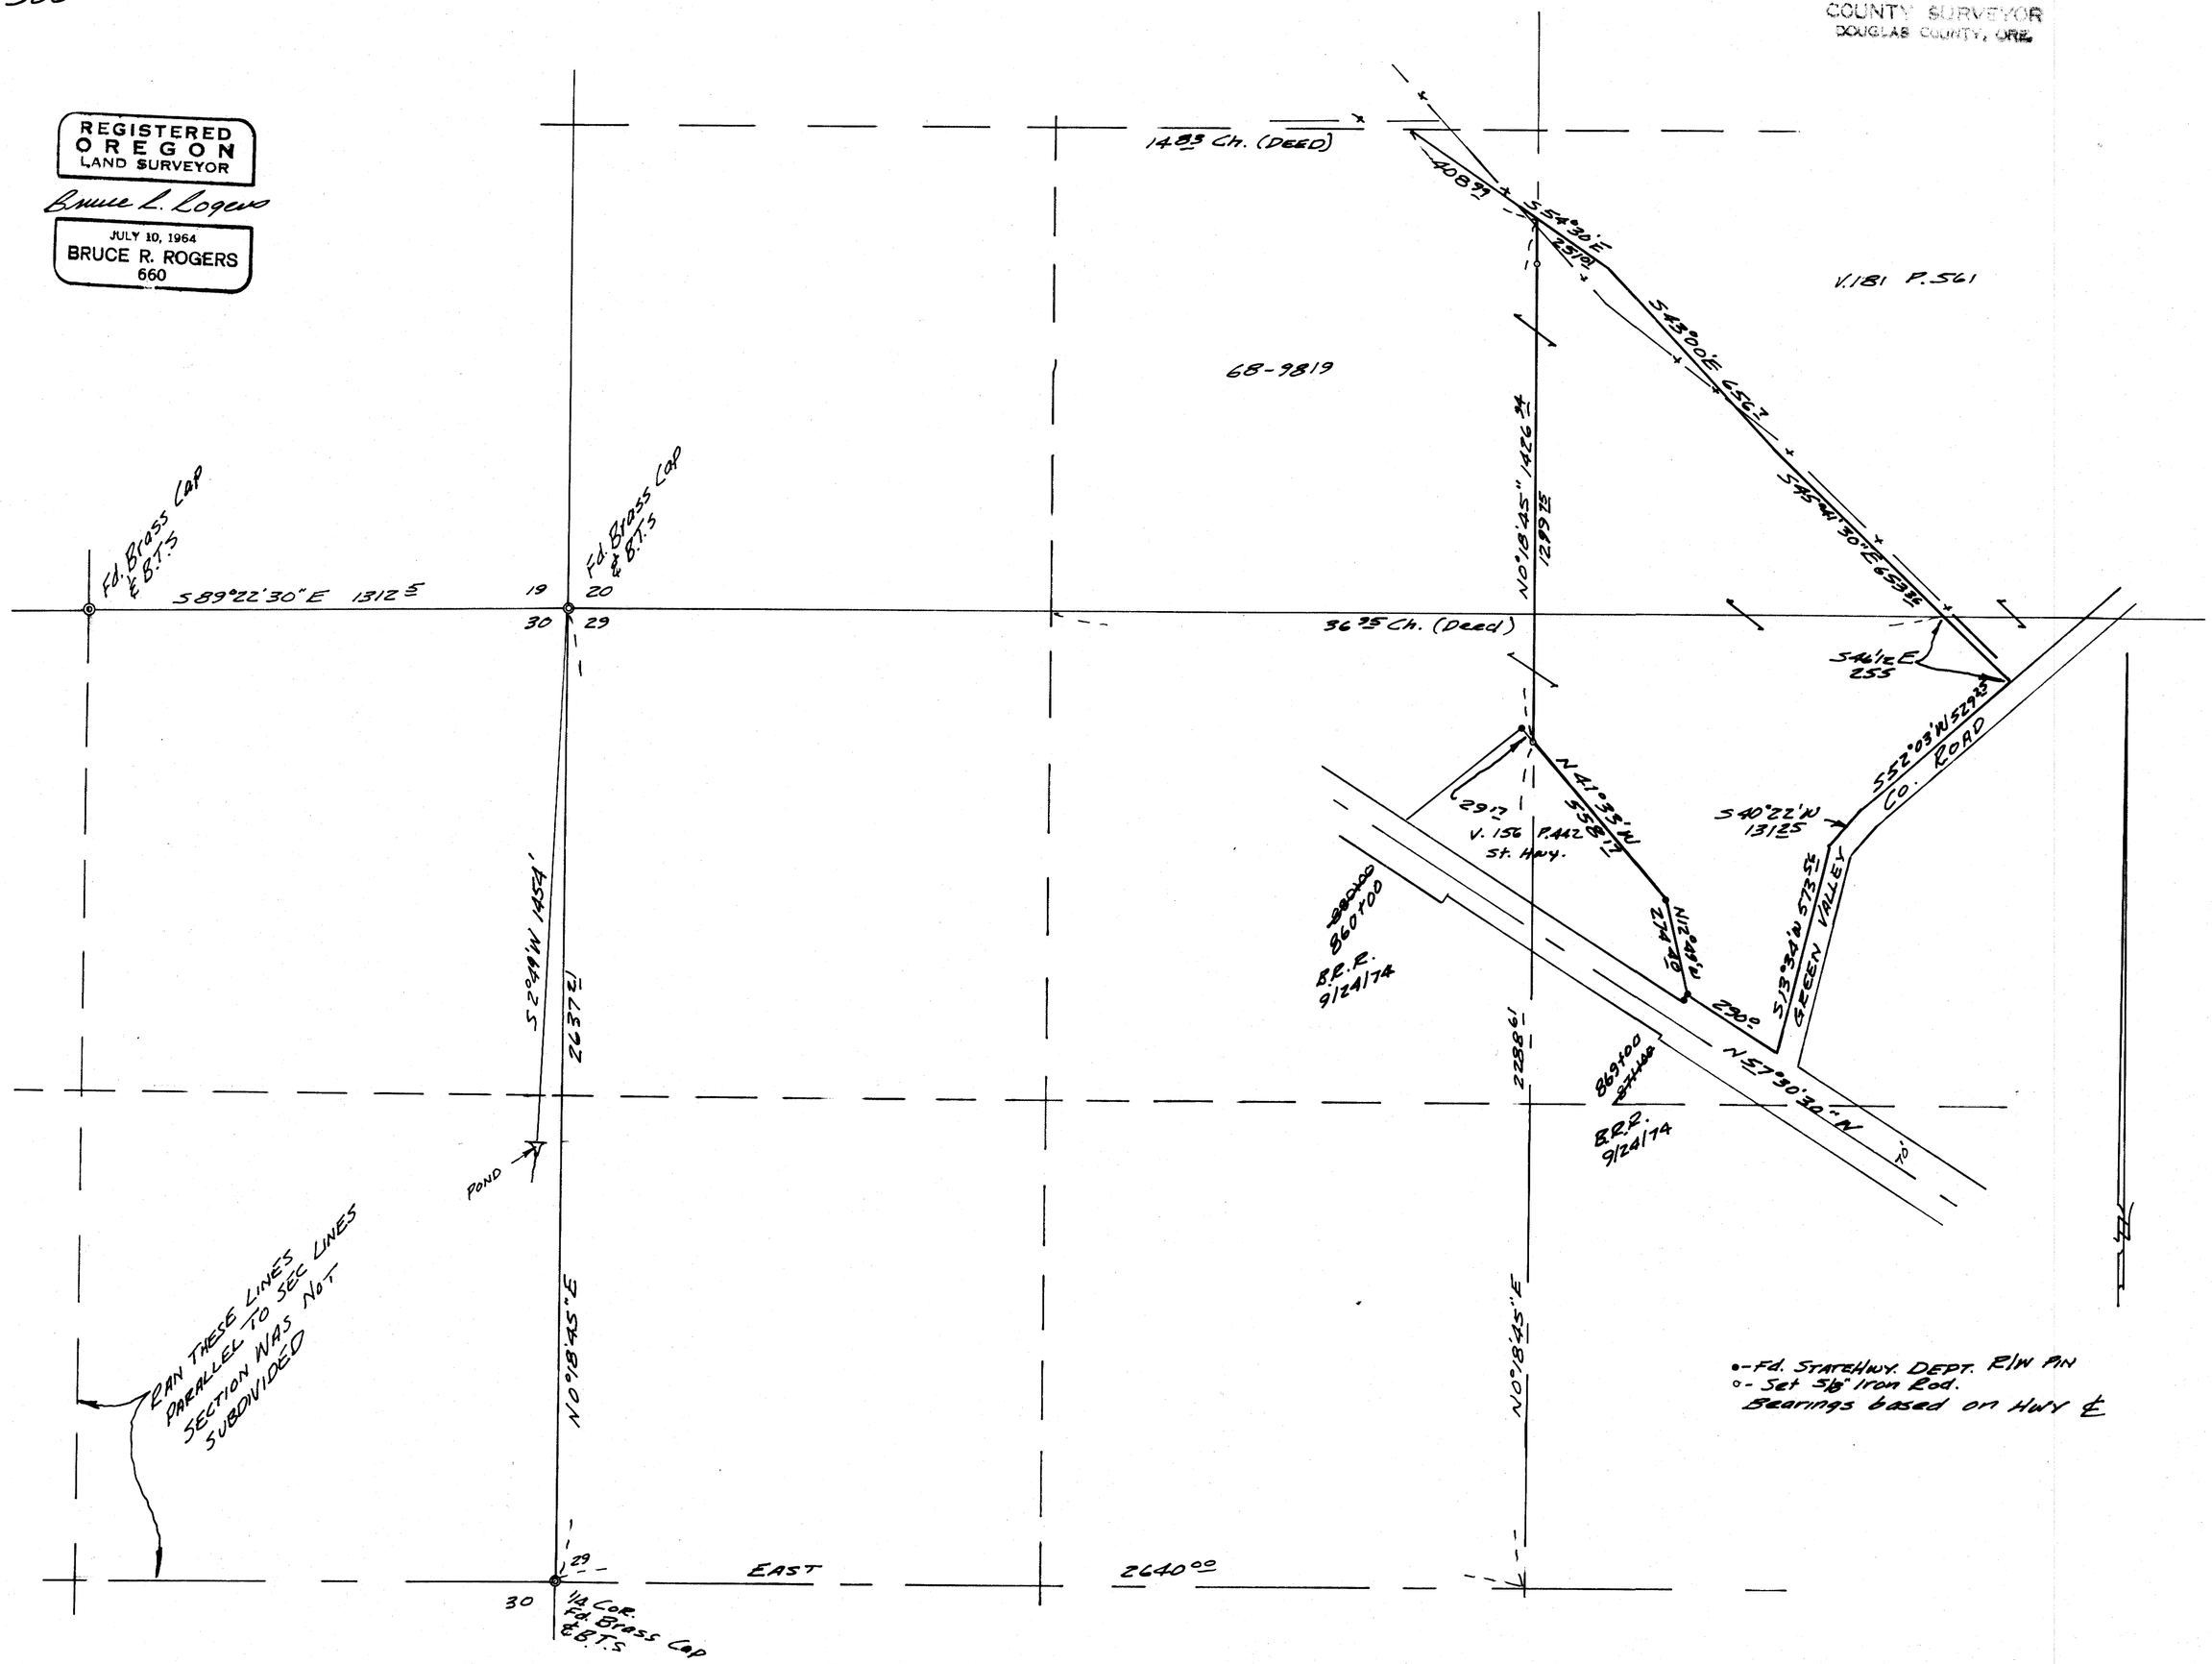

M 41-9