M 42 - 15

COUNTY SURVEYORS FILE DATA
DO NOT REMOVE FROM OFFICE

PLAT OF TRACTS
SEC.S 3 & 10, T 23 S, R 5 W.W.M.

DOUGLAS COUNTY, OREGON.

SURVEYED FOR – FORREST BETHEL
SURVEYED BY – W. S. BARNES

FEB. 1971
SCALE 1" = 200'

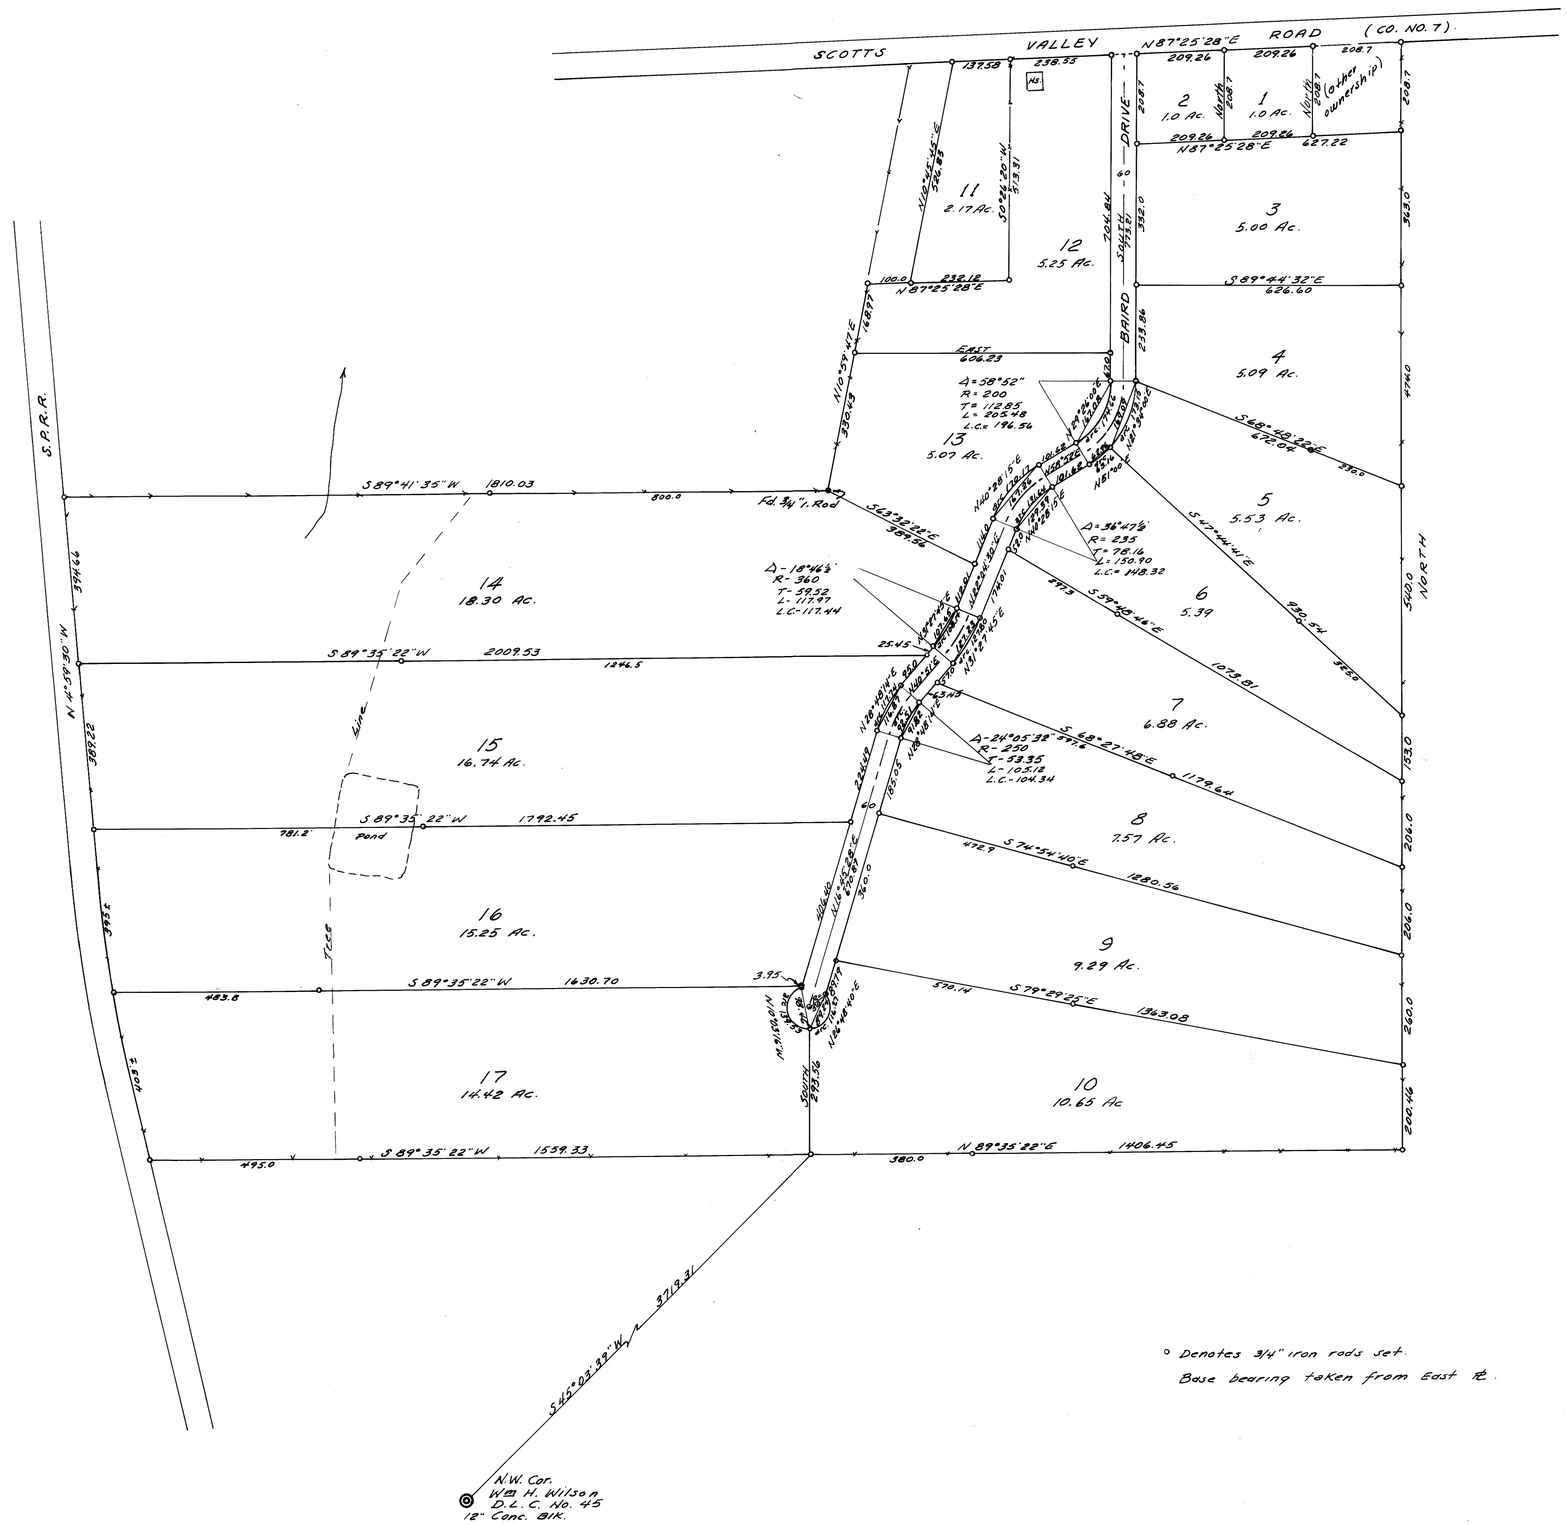

○ Denotes 3/4" iron rods set.
Base bearing taken from East ℄.

COUNTY SURVEYORS FILE DATA
DO NOT REMOVE FROM OFFICE

M 42 - 15