91-42 W

COUNTY SURVEYORS FILE DATA
DO NOT REMOVE FROM OFFICE

SURVEY TO ESTABLISH PROPERTY CORNERS

IN LOTS 2, 12, 13, 14, & 15 BLOCK 13 ROSEBURG HOME ORCHARD TRACTS

DOUGLAS COUNTY, OREGON

SURVEYED BY N.H. HOOVER FEB. 1971 SCALE 1"=100'

SURVEYED FOR GEORGINE KOHLHAGEN & ROBERT SINCLAIR

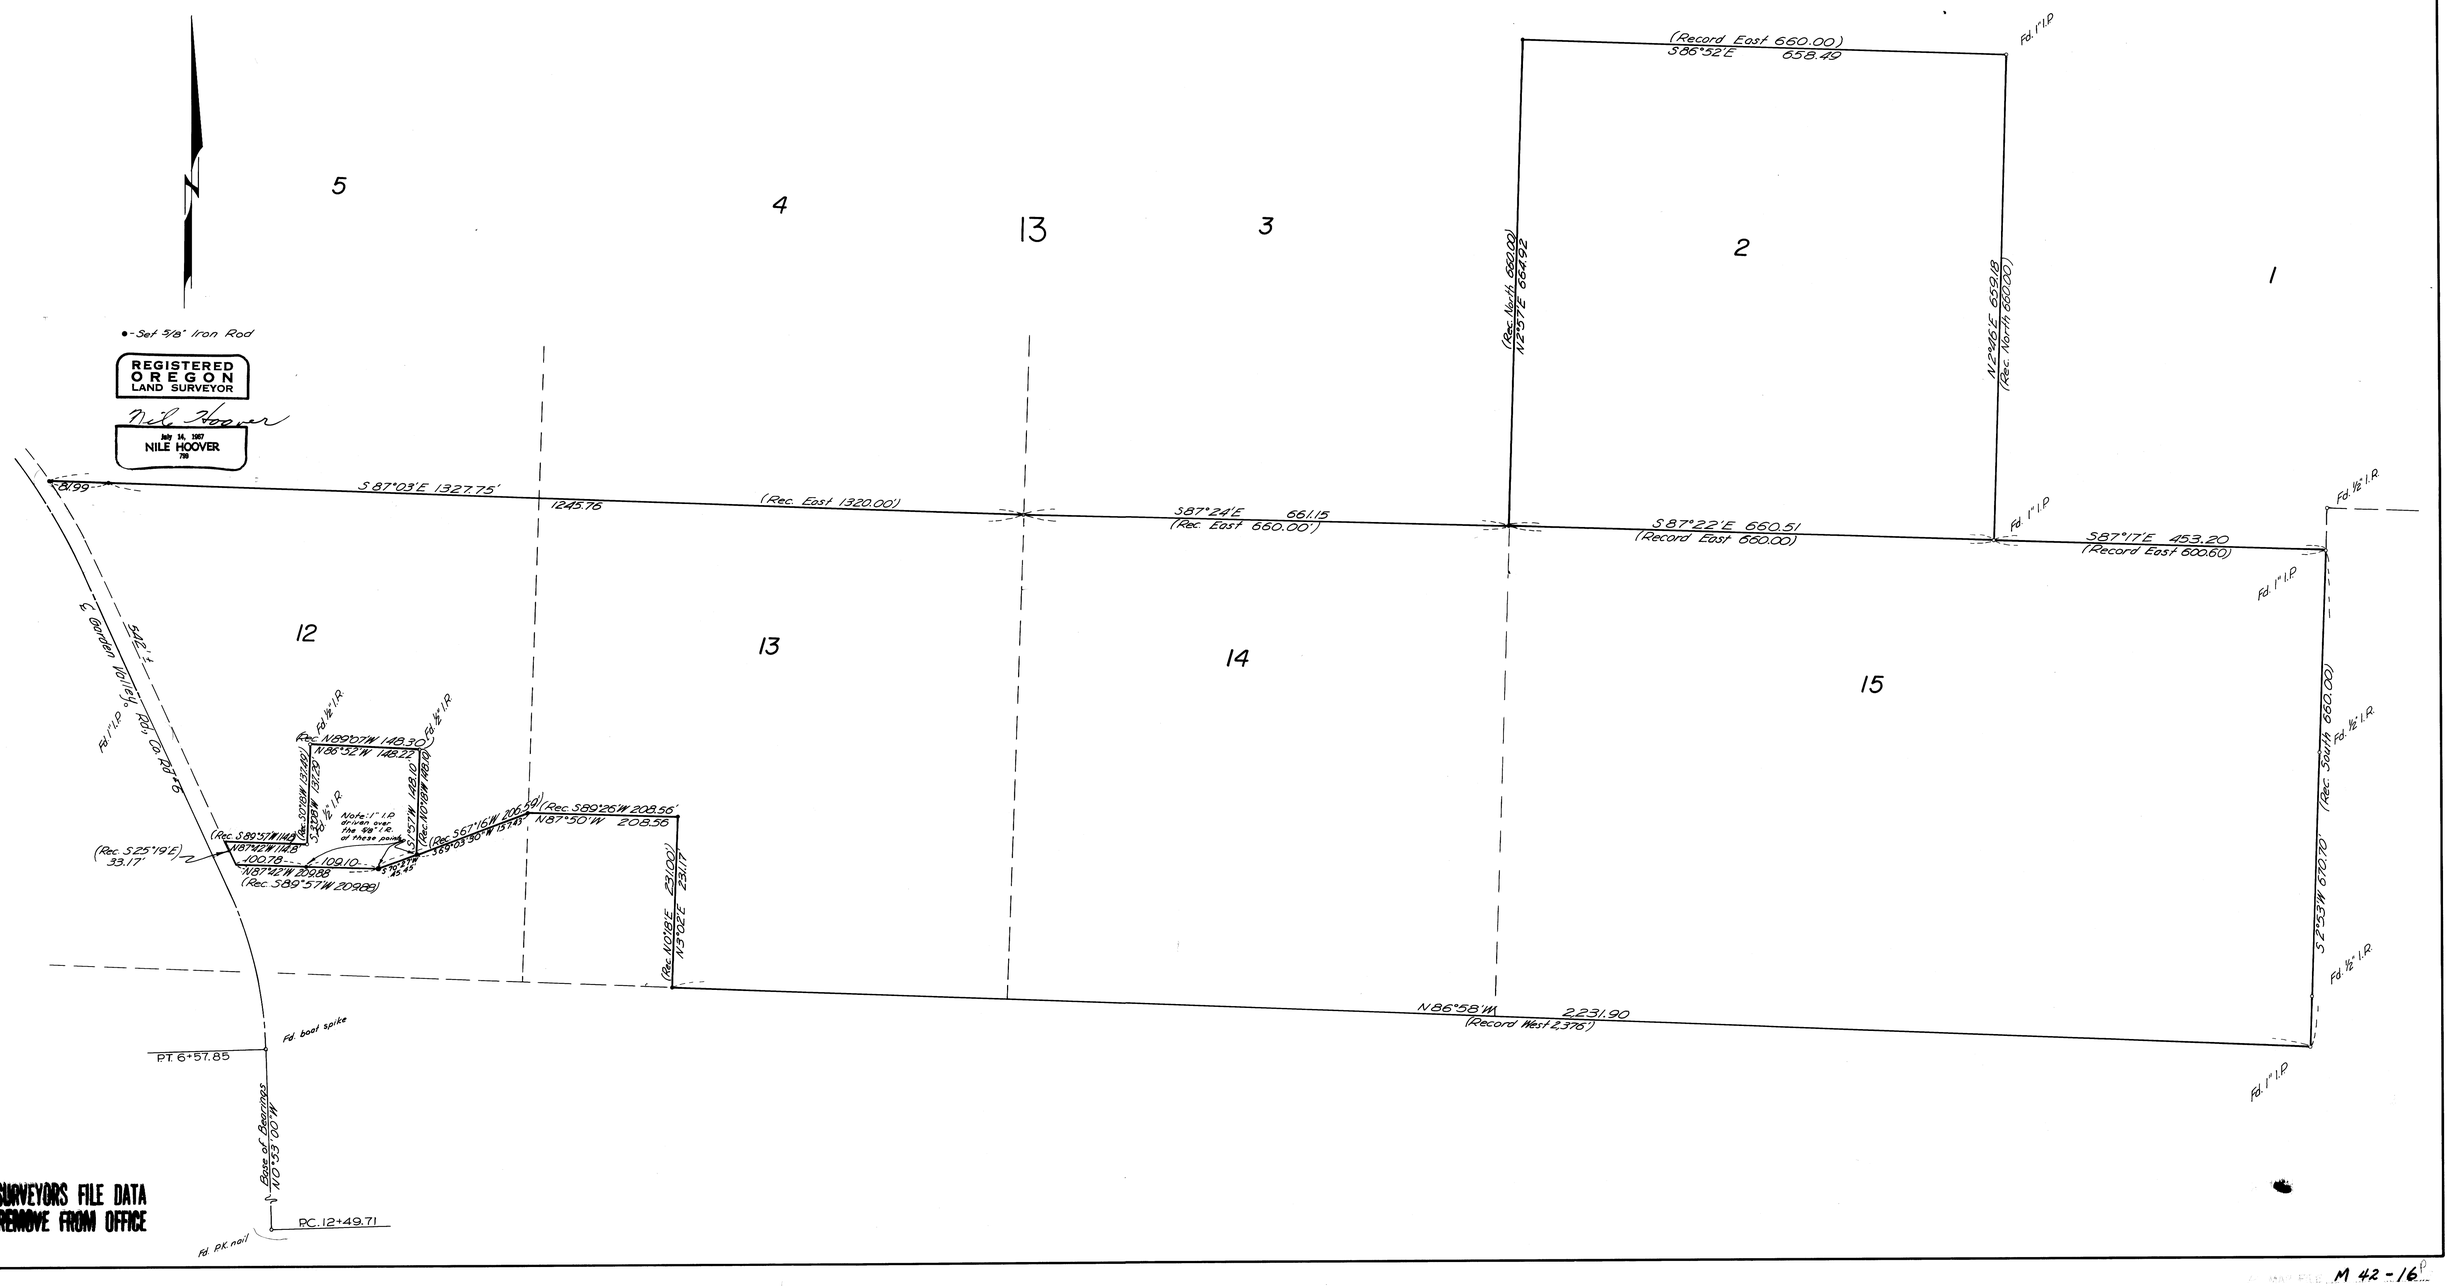

COUNTY SURVEYORS FILE DATA
DO NOT REMOVE FROM OFFICE

M 42-16