MAP FILE M 42-4

COUNTY SURVEYORS FILE DATA
DO NOT REMOVE FROM OFFICE

FILED
RECEIVED
SEP 30 1970
COUNTY SURVEYOR
DOUGLAS COUNTY, OREG.

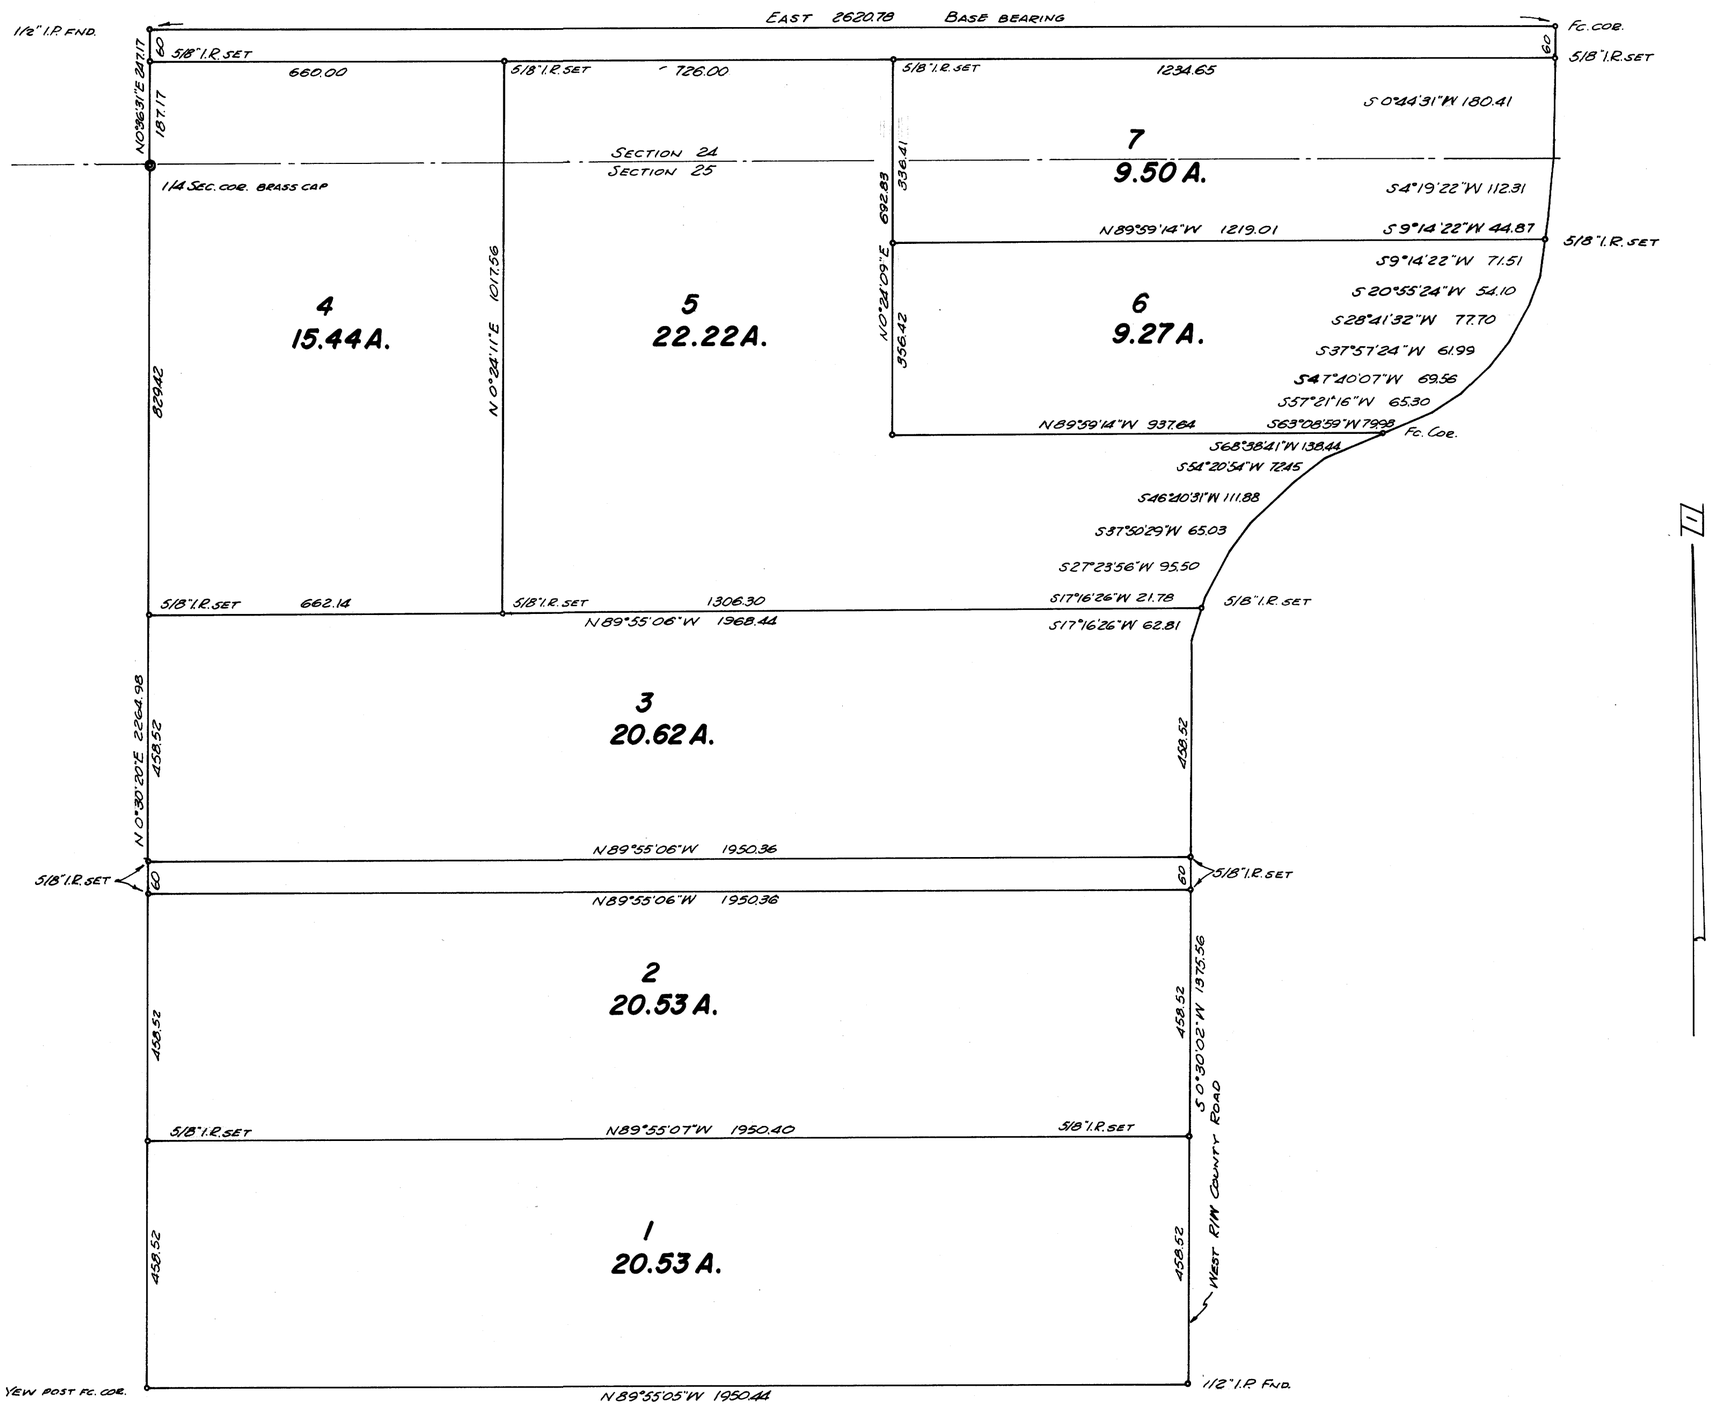

SURVEY IN SECTIONS 24 AND 25, T. 29 S., R. 9 W., W.M.
SURVEYED FOR JAMES C. ATTEBERRY, JR.
SURVEYED BY R. H. GEE — SEPTEMBER, 1970
SCALE 1" = 200'

REGISTERED PROFESSIONAL ENGINEER 3723 OREGON OCT. 23, 1964 R. H. GEE

COUNTY SURVEYORS FILE DATA
DO NOT REMOVE FROM OFFICE

MAP FILE M 42-4