COUNTY SURVEYORS FILE DATA
DO NOT REMOVE FROM OFFICE

FILED
RECEIVED
MAY 12 1972
COUNTY SURVEYOR
DOUGLAS COUNTY, OREGON

MAP FILE M42-59

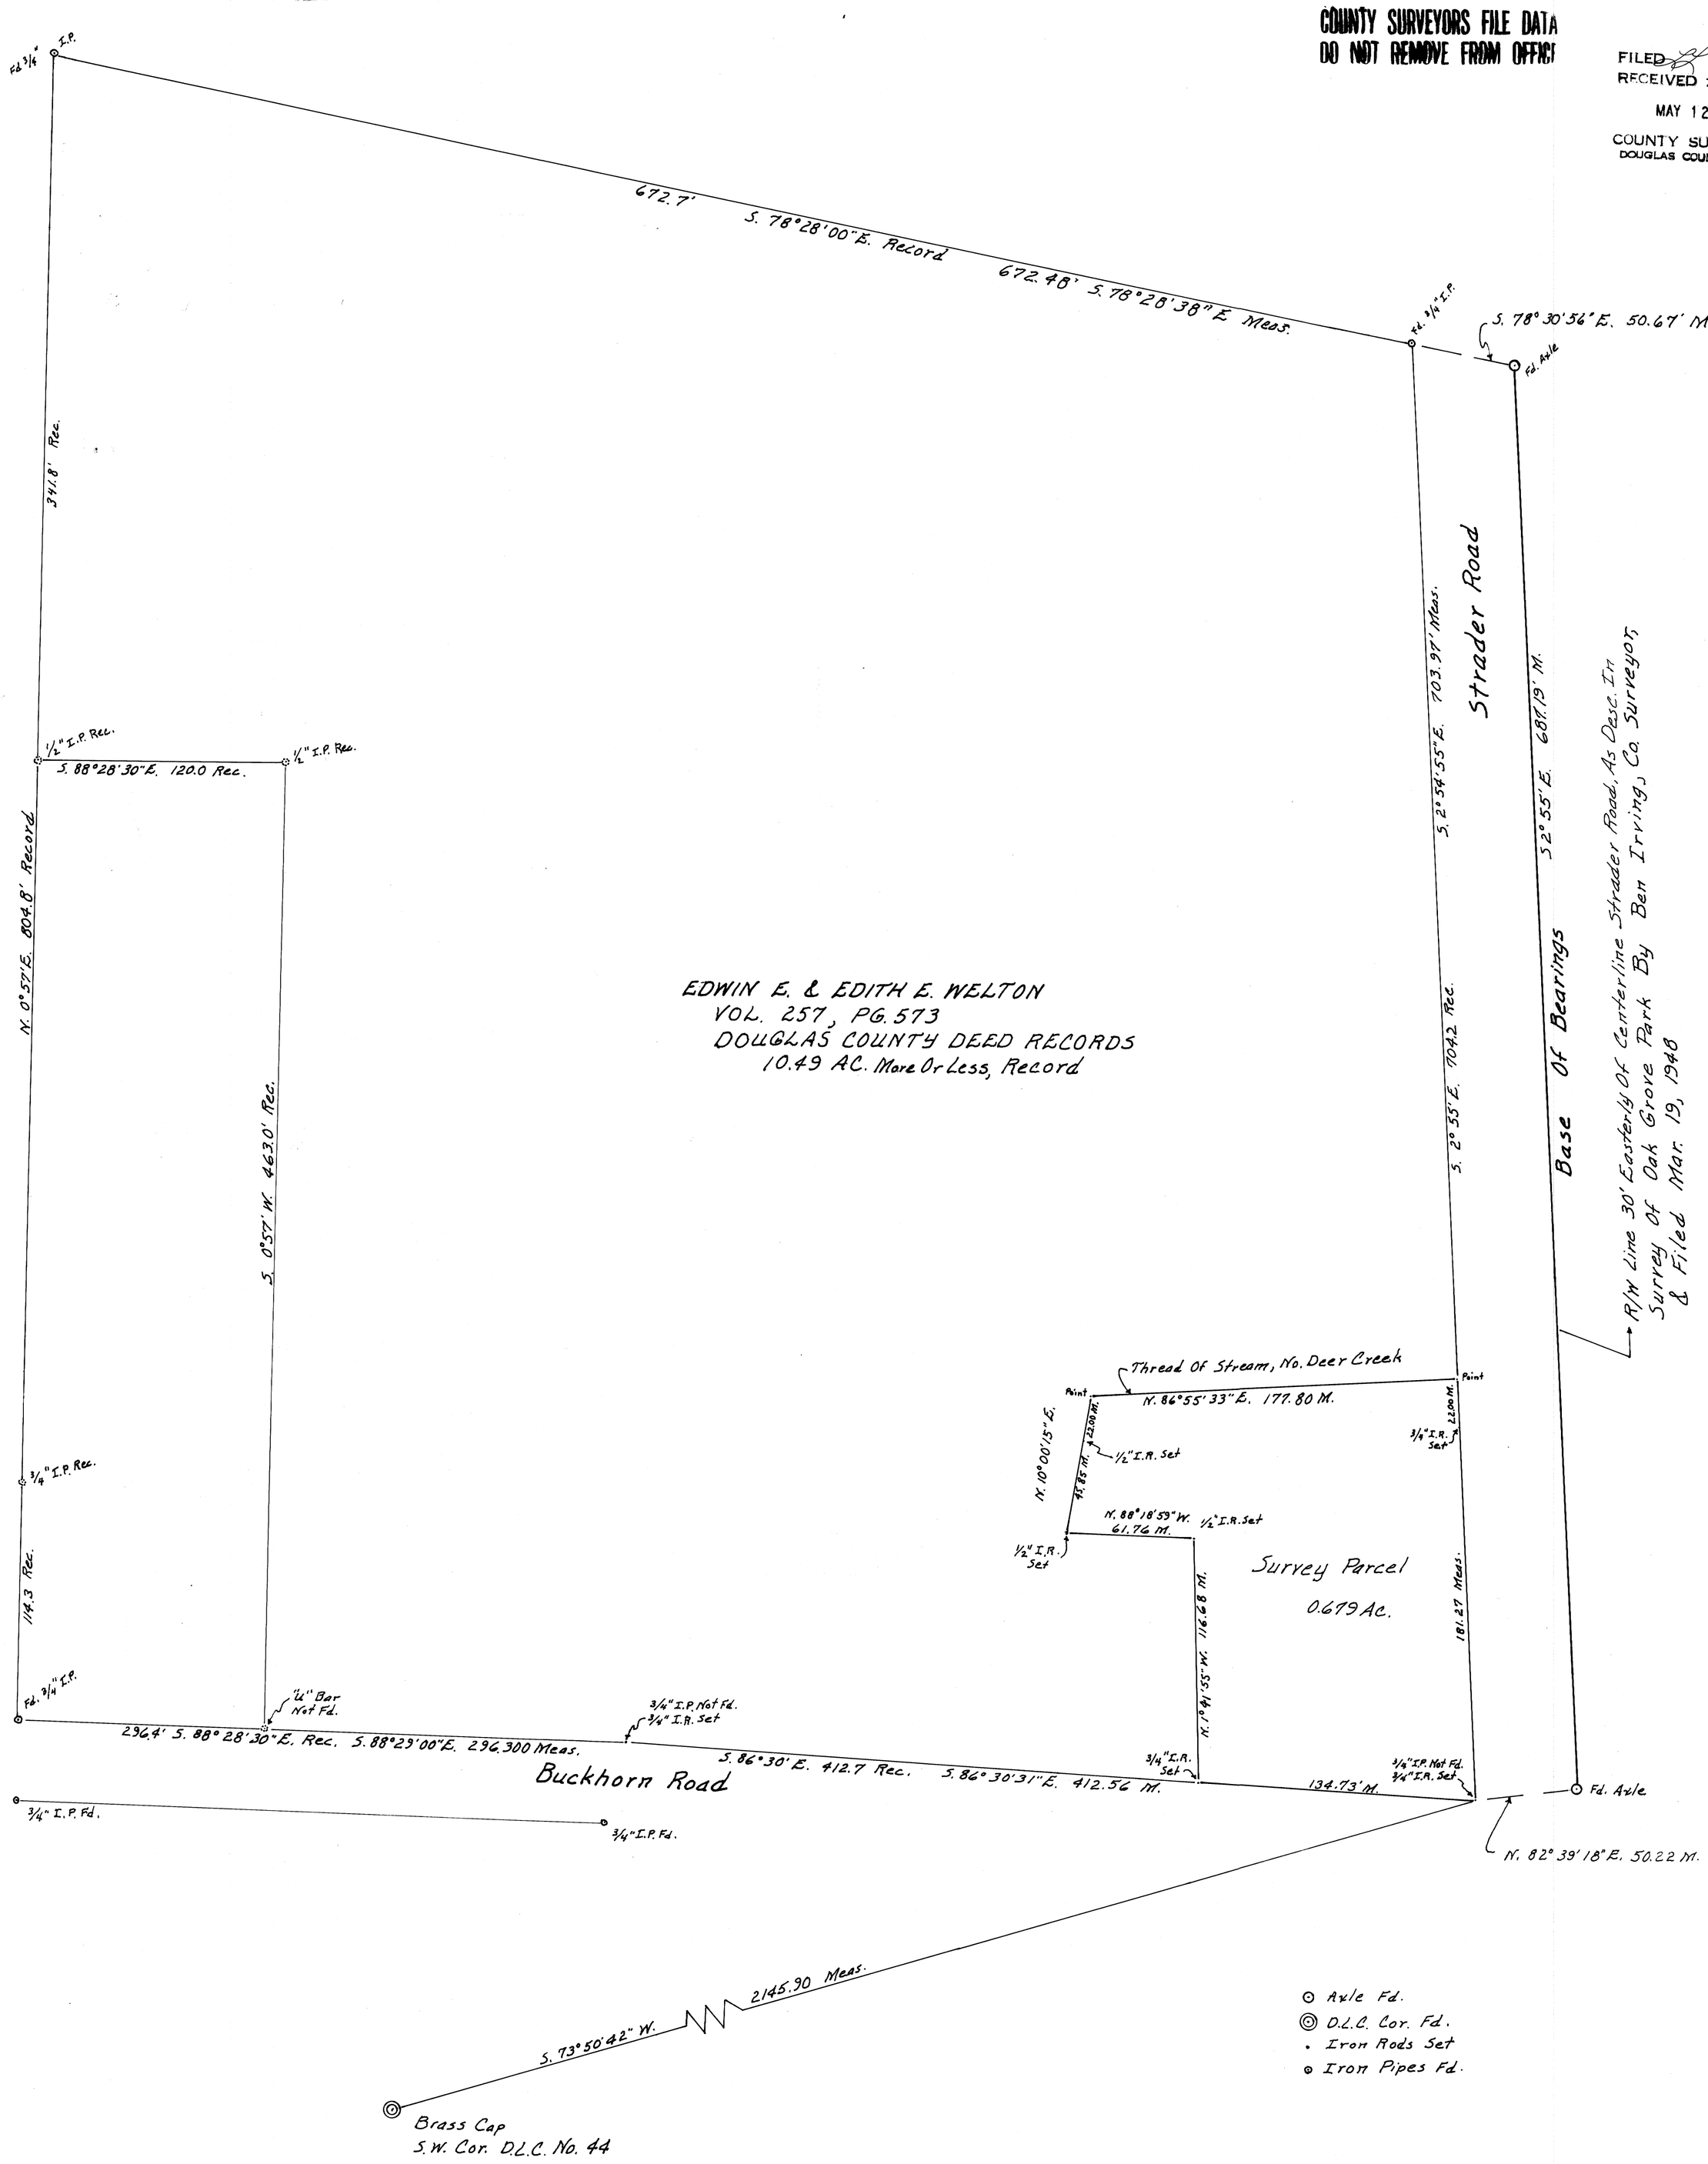

N

SURVEY FOR DEED DESCRIPTION
OF PARCEL IN JAMES COX D.L.C. NO. 44
SECS. 20 & ~~21~~ T. 27 S., R. 4 W., W.M.

SCALE: 1" = 40'

Earl T. Clark Reg. Prof. Land Surveyor
Survey Completed May 12, 1972

REGISTERED
PROFESSIONAL
LAND SURVEYOR
Earl T. Clark
OREGON
JULY 12, 1968
EARL T. CLARK
843

MAP FILE M42-59

COUNTY SURVEYORS FILE DATA
DO NOT REMOVE FROM OFFICE