M 42-69
MAP FILE M42 - 69

DESCRIPTION OF MONUMENTS AND ACCESSORY TIES

COUNTY SURVEYORS FILE DATA
DO NOT REMOVE FROM OFFICE

FILED & RECEIVED
SEP 2 2 1972
COUNTY SURVEYOR
DOUGLAS COUNTY, ORE.

(1) SURVEYORS OFFICE COUNTY — T31S R2W — S23 | S24 / S26 | S25 — 1966

Section Corner common to Sections 23, 24, 25 & 26.
Found 1" iron pipe with 2½" brass cap
stamped as shown
From which bears:
5" D.Fir N31°W 13.8' scribes visible
13" Madrone N78°E 29.5' scribes visible
10" D.Fir S61°E 41.3' scribes visible
13" D.Fir S62½°W 34.5' scribes visible

(2) SURVEYORS OFFICE COUNTY — T31S R2W — ¼ S23 — 1966

South ¼ Corner Section 23 only
Found 1" iron pipe with 2½" brass cap.
Stamped as shown
From which bears:
8" Inc. Cedar N48°E 14.0' scribes visible
7" Inc. Cedar N42½°W 7.9' scribes visible.

(3) SURVEYORS OFFICE COUNTY — T31S R2W — S23 / S27 | S26 — 1966

Corner to Sections 26 & 27 only on South line of Section 23.
Found 1" iron pipe with 2½" brass cap
stamped as shown
From which bears:
36" D.Fir stump, original BT, S73°E 17.2'
36" D.Fir stump, original BT, S25½°W 33.8'
20" W.Fir S77W 33.2' visible scribe

(4) SURVEYORS OFFICE COUNTY — T31S R2W — S22 | S23 / S27 — 1966

Corner to Sections 22 & 23 only on North line of Section 27.
Found 1" iron pipe with 2½" brass cap
stamped as shown
From which bears:
10" W.Fir S89°E 48.0' scribes visible
11" Inc. Cedar N46°E 27.7' " "

(5) T31S R2W — N 1/16 — S27 | S26 — 1972 — R.E. 2128

N 1/16 Corner between Sections 26 & 27
Set 2" iron pipe with 3" brass cap
stamped as shown
From which bears:
16" W. Oak N51°E 43.3' Scribed N1/16 S26 BT RE 2128
14" D. Fir S81½°E 40.0' Scribed N1/16 S26 BT RE 2128

(6) SURVEYORS OFFICE COUNTY — T31S R2W — ¼ — S27 | S26 — 1966

¼ Corner between Sections 26 & 27
Found 1" iron pipe with brass cap stamped as shown
From which bears:
24" D.Fir S22°W 3.9' scribes visible
30" D. Fir N74°E 4.0', Original BT.

(7) SURVEYORS OFFICE COUNTY — T31S R2W — S27 | S26 / S34 | S35 — 1966

Section Corner common to Sections 26, 27, 34 & 35
Found 1" iron pipe with 2½" brass cap
stamped as shown
From which bears:
40" P.Pine, Original BT, N63W 10.3'
10" D. Fir N86°E 15.6' scribes visible
10" Madrone S33½°E 7.3' " "
12" D.Fir S32°W 31.0' " "

(8) T31S R2W — W 1/16 — S26 / S35 — 1972 — RE 2128

W 1/16 corner between Sections 26 & 35
Set 2" iron pipe with 3" brass cap stamped as shown.
From which bears:
21" W.Fir N2°W 21.9' Scribed W1/16 S 26 BT RE 2128
13" W.Fir S18°W 18.8 Scribed W1/16 S35 BT RE 2128

(9) SURVEYORS OFFICE COUNTY — T31S R2W — ¼ — S26 / S35 — 1966

¼ Corner between Sections 26 & 35
Found 1" iron pipe with 2½" brass cap
stamped as shown
From which bears:
14" Inc. Cedar N4½°E 47.3' Scribed ¼ S26 CS BT
15" D. Fir S39°E 32.0' scribed ¼ S35 CS BT.

(10) SURVEYORS OFFICE COUNTY — T31S R2W — S26 | S25 / S35 | S36 — 1966

Section corner common to Sections 25, 26, 35 & 36
Found 1" iron pipe with 2½" brass cap stamped as shown
From which bears:
7" D.Fir N29E 27.0' scribes visible.
6" W. Fir N52E 38.8' " " .
19" Inc. Cedar, original BT, S60E 13.9'

(11) T31S R2W — S 1/16 — S26 | S25 — 1972 — R.E. 2128

S 1/16 Corner between Sections 25 & 26
Set 2" iron pipe with 3" brass cap stamped as shown
From which bears:
9" W. Fir N71½°E 12.9' Scribed S1/16 S25 BT RE 2128
18" D. Fir S43½°W 40.3' Scribed S1/16 S26 BT RE 2128

(12) SURVEYORS OFFICE COUNTY — T31S R2W — ¼ — S26 | S25 — 1966

¼ Corner between Sections 25 & 26
Found 1" iron pipe with 2½" brass cap stamped as shown
From which bears:
12" D.Fir N88W 55.2' scribes visible.
10" D.Fir N11E 25.5' " " .

(13) T31S R2W — N 1/16 — S26 | S25 — 1972 — R.E. 2128

N 1/16 Corner between Sections 25 & 26.
Set 2" iron pipe with 3" brass cap. stamped as shown
From which bears:
15" Madrone S51½°E 147.9' Scribed N1/16 S25 BT RE 2128
9" Madrone S57 W 17.0' Scribed N 1/16 S26 BT RE 2128

(14) T31S R2W — NW 1/16 S26 — 1972 — RE 2128

NW 1/16 Corner Section 26
Set 2" iron pipe with 3" brass cap stamped as shown
From which bears:
24" W. Oak N66½°E 87.9' Scribed NW 1/16 S26 BT RE 2128
8" Pine S1½°W 30.9' Scribed NW 1/16 S26 BT RE 2128

(15) T31S R2W — C W 1/16 C — S26 — 1972 — RE 2128

CW 1/16 Corner Section 26
Set 2" iron pipe with 3" brass cap stamped as shown
From which bears:
16" D.Fir N13°W 51.8' Scribed CW 1/16 S 26 BT RE 2128
16" Inc. Cedar S85½°E 6.2' Scribed CW 1/16 S26 BT RE 2128

(16) T31S R2W — SW 1/16 S26 — 1972 — RE 2128

SW 1/16 Corner S 26
Set 2" iron pipe with 3" brass cap stamped as shown
From which bears:
15" D.Fir N88½°E 22.6' Scribed SW 1/16 S26 BT RE 2128
12" Madrone N6½W 15.4' Scribed SW 1/16 S26 BT RE 2128

(17) T31S R2W — C — S 1/16 | S26 — C — 1972 — RE 2128

CS 1/16 Corner Section 26
Set 2" iron pipe with 3" brass cap stamped as shown
From which bears:
14" D Fir S69½ W 38.0' Scribed CS 1/16 S26 BT RE 2128
10" Madrone N78E 26.7' Scribed CS 1/16 S26 BT RE 2128

(18) T31S R2W — C 1/4 S26 — 1972 — RE 2128

C 1/4 corner Section 26
Set 2" iron pipe with 3" brass cap stamped as shown
From which bears:
12" D. Fir N32W 21.5 Scribed C1/4 S26 BT RE 2128
12" D. Fir S18½°E 10.6 scribed C1/4 S26 BT RE 2128

(19) T31S R2W — C — N 1/16 | S26 — C — 1972 — RE 2128

CN 1/16 Corner Section 26
Set 2" iron pipe with 3" brass cap stamped as shown
From which bears:
20" Inc. Cedar N61½°E 25.5' Scribed CN 1/16 S26 BT RE 2128
18" Inc. Cedar N84½°W 37.8' Scribed CN 1/16 S26 BT RE 2128

(20) T31S R2W — ¼ — S 26 — 1972 — RE 2128

North ¼ corner Section 26 only
Set 2" iron pipe with 3" brass cap stamped as shown
From which bears:
17" Inc. Cedar South 39½' Scribed ¼ S26 BT RE 2128
12" D. Fir N50°E 18.5' Scribed ¼ S26 BT RE 2128

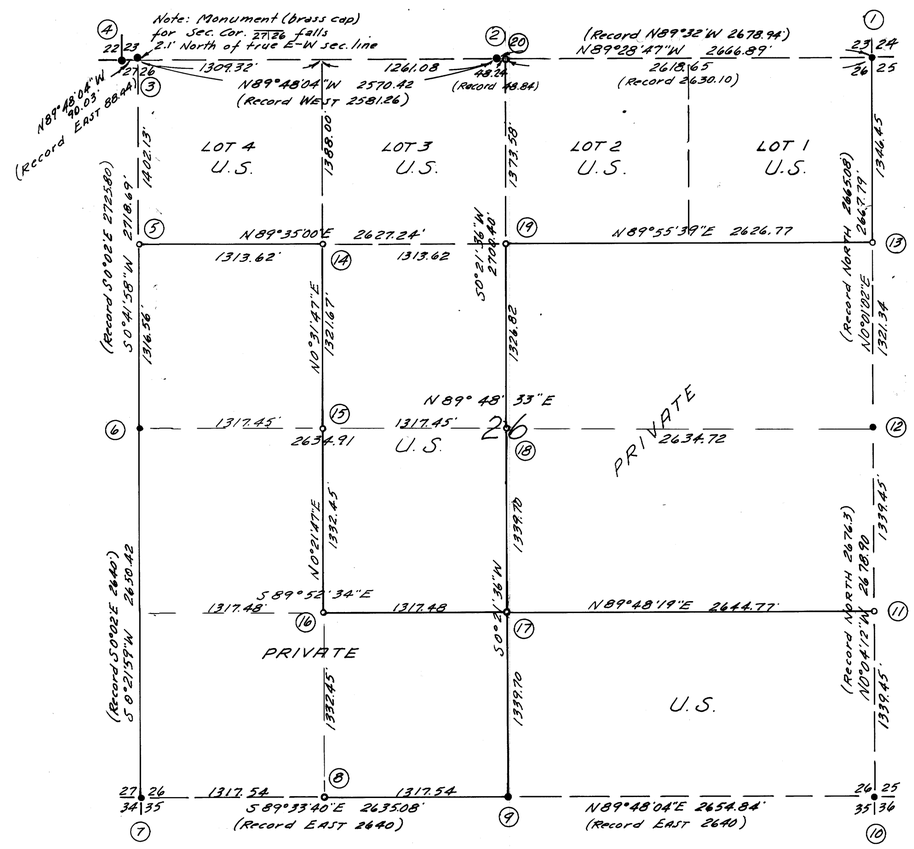

Declination 20° East

Bearings based on Solar Observation

Note: Reference field notes for this plat are in Contract No. 003658N
Books No. 1 through 4.

LEGEND.

Solid lines indicate National Forest Property Lines.
Dashed lines indicate section lines or sectional subdivision lines.

● Indicates 1" iron pipe with 2½" brass cap found.
○ Indicates 2" iron pipe with 3" brass cap set.

"I, William S. Barnes, a registered Engineer in the State of Oregon, hereby certify that this plat and the notes hereon, or attached, are a correct representation of the survey I preformed during June, July, August and September, 1972, for the U.S. Forest Service, in accordance with the statutes of the State of Oregon and with the Articles of my contract."

William S. Barnes
William S. Barnes
Registered Professional Engineer
Oregon License 2128

REGISTERED PROFESSIONAL ENGINEER 2128 OREGON SEPT. 9, 1941 William S. Barnes

PLAT OF CADASTRAL SURVEY
UMPQUA NATIONAL FOREST
TILLER LAND SURVEY NO. 10
CONTRACT NO. 003658N
IN SEC. 26 T 31 S, R 2 W. W. M.
DOUGLAS COUNTY, OREGON

ENGINEER – W. S. BARNES ENGINEERING SERVICE,
ROSEBURG, OREGON.
SCALE 8" = 1 MILE AUGUST, 1972.
M 42-69

MAP FILE M 42 - 69