M #3-18

SURVEY FOR PROPERTY DESCRIPTION

SITUATED IN SEC. 30, T.26S., R6.5, W.W.M.

SURVEY FOR MRS. RUTH BRADLEY

BAUGHMAN SURVEYING SERVICE

FILED
RECEIVED
JUL 30 1971
COUNTY SURVEYOR
DOUGLAS COUNTY, ORE.

SCALE 1"=20' JULY 1971

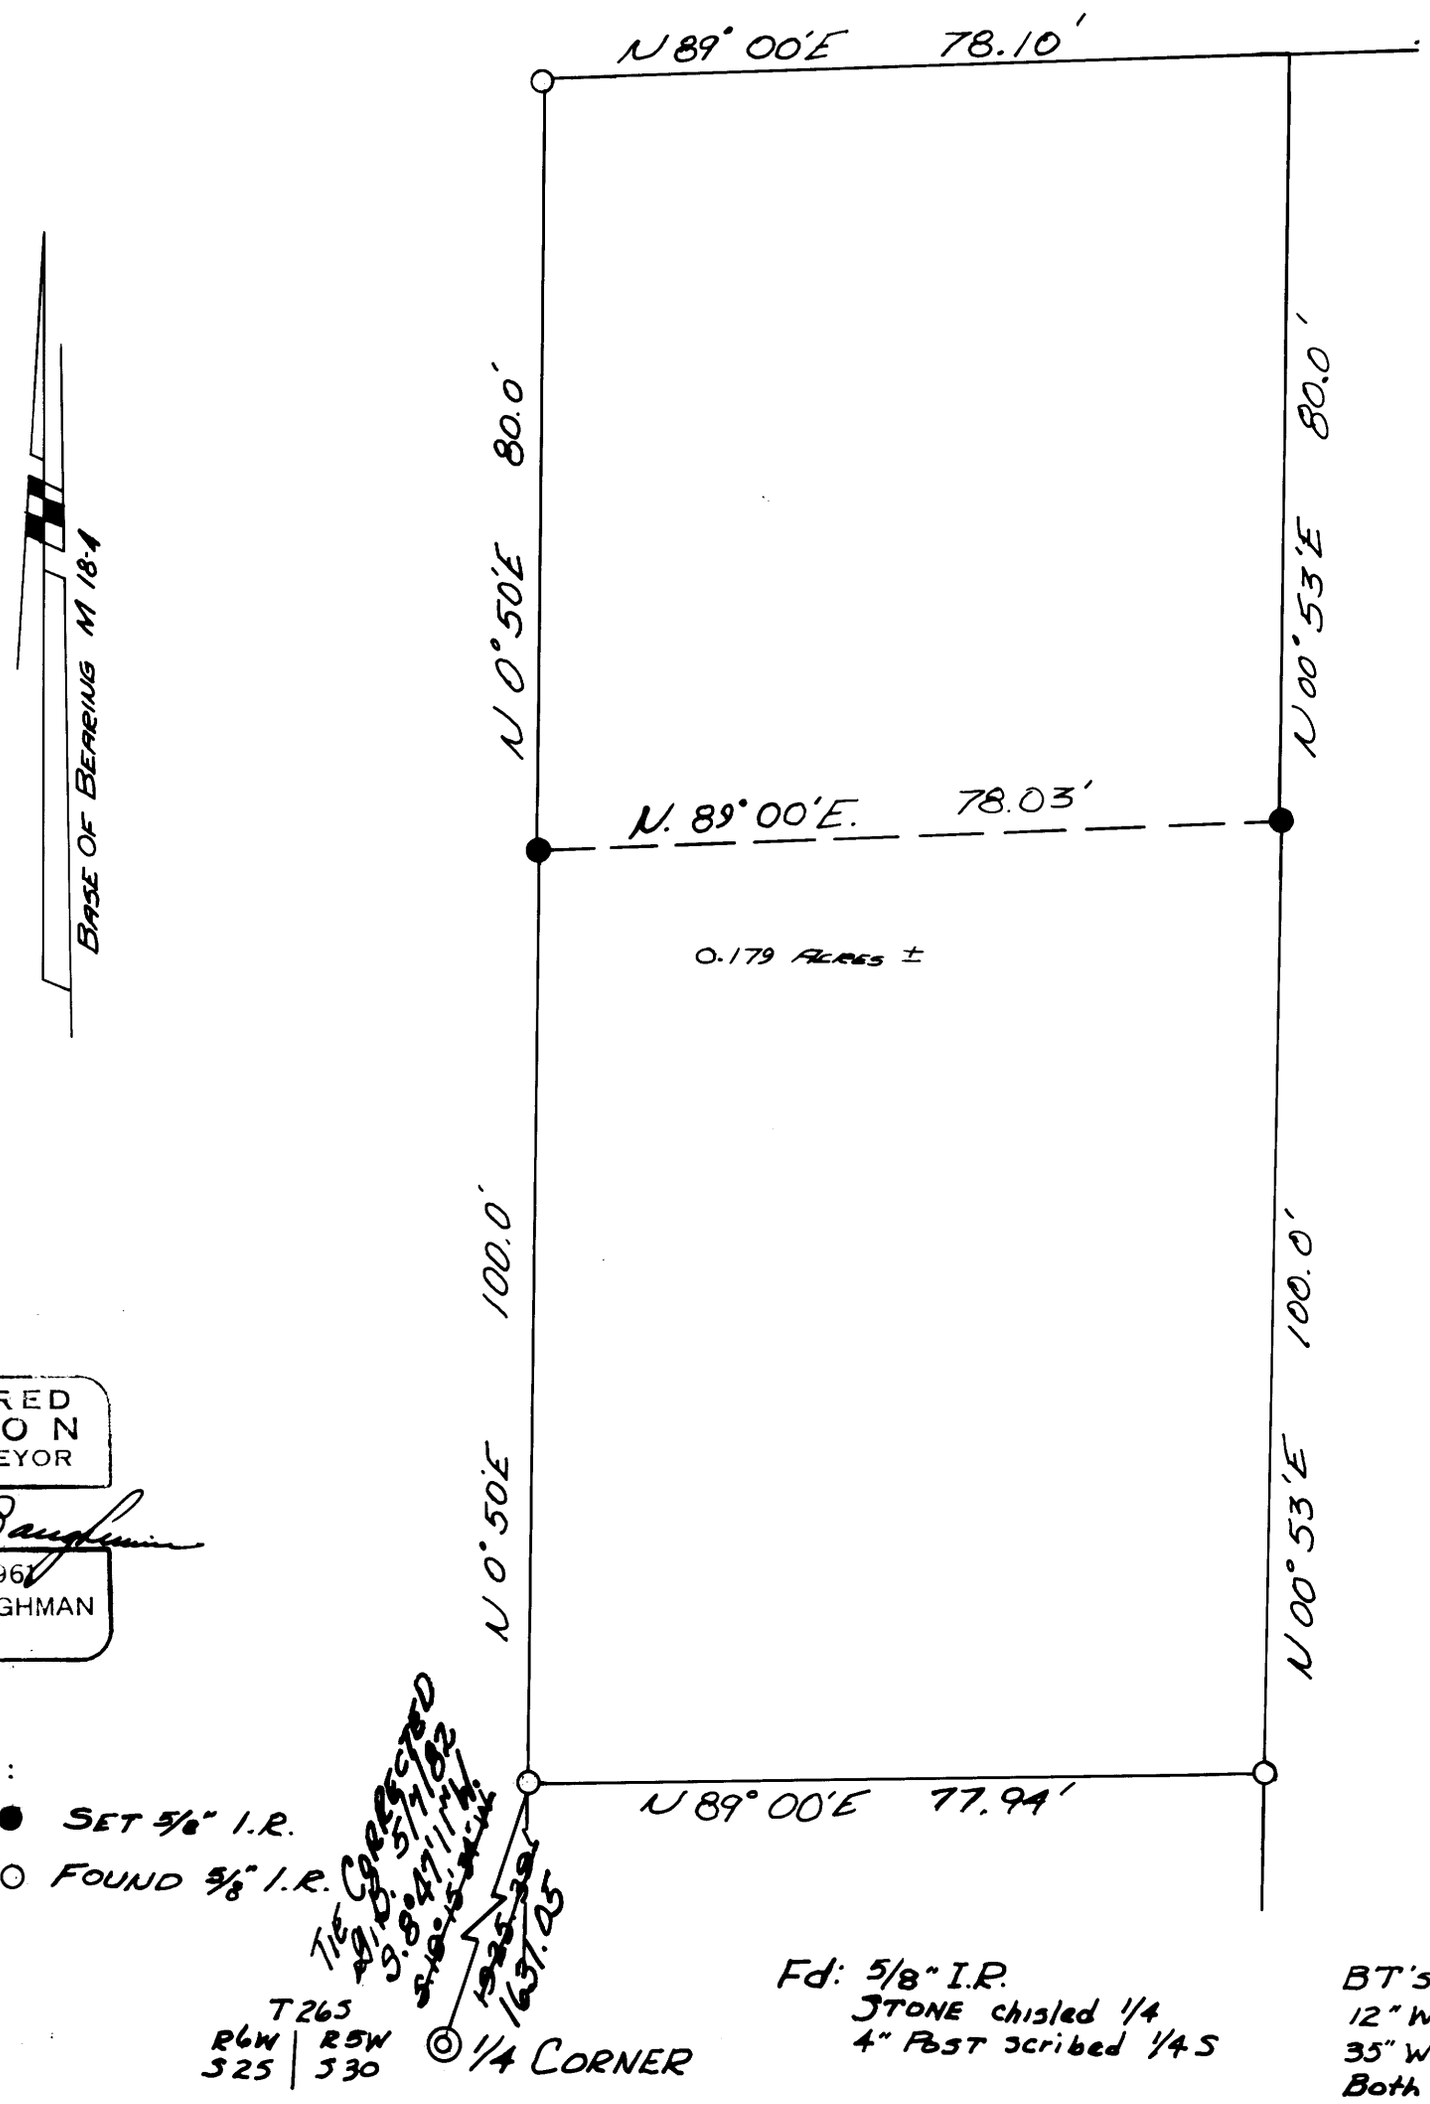

REGISTERED
OREGON
LAND SURVEYOR
Glenn S. Baughman
JULY 14, 1961
GLENN S. BAUGHMAN
536

LEGEND:
● SET 5/8" I.R.
○ FOUND 5/8" I.R.

Fd: 5/8" I.R.
STONE chisled 1/4
4" POST scribed 1/4 S

BT's:
12" W. Oak bears S 66°30'E 483.50'
35" W. Oak bears S 64°30'E 741.20'
Both have good scribes + BT tags

COUNTY SURVEYORS FILE DATA
DO NOT REMOVE FROM OFFICE

M 43-18