SURVEY TO SET PROPERTY CORNERS
IN LOTS 10, 11, 12 & 13, BLOCK 6
SUTHERLIN LAND & WATER CO. PL. "M"
DOUGLAS COUNTY, ORE.
SURVEYED FOR BENNETT REALTY
by BRUCE ROGERS
JULY, 1971
1" = 100'
Changes Made [redacted]

FILED
RECEIVED
AUG 3 1971
COUNTY SURVEYOR
DOUGLAS COUNTY, ORE.

M43-21

REGISTERED
OREGON
LAND SURVEYOR
Bruce R. Rogers
JULY 10, 1964
BRUCE R. ROGERS
660

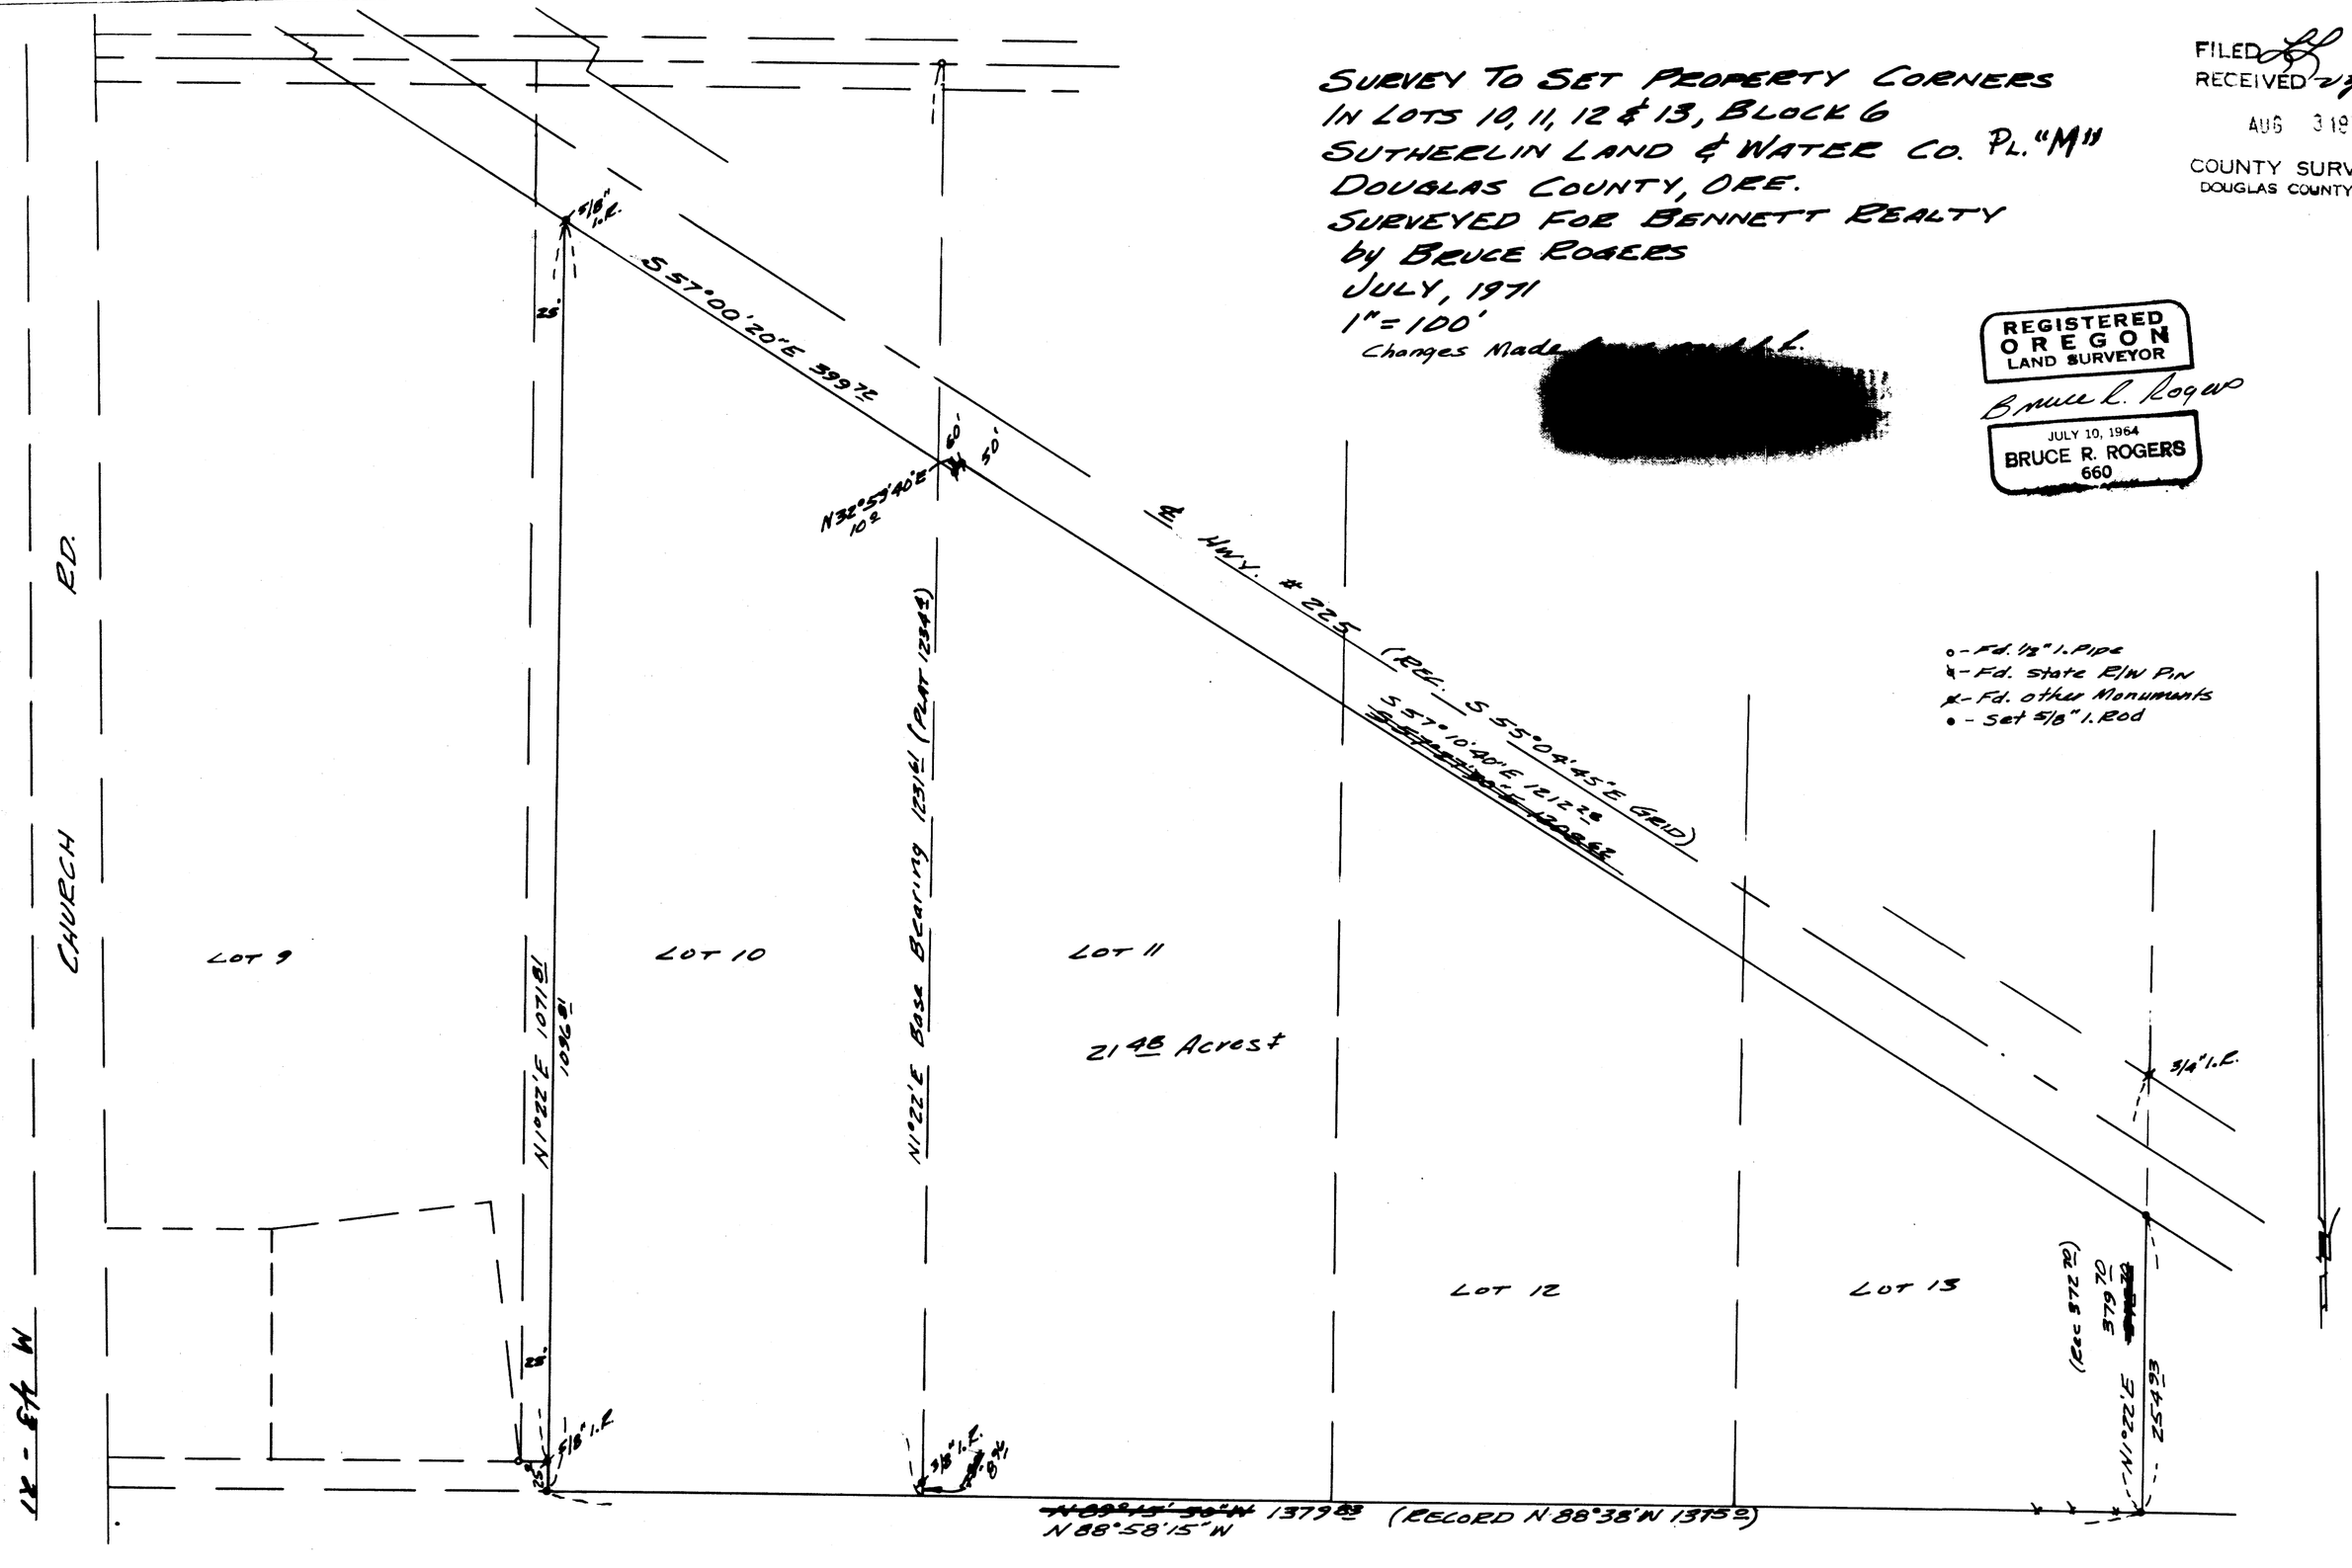

o - Fd. 1/2" I. Pipe
⊗ - Fd. State R/W Pin
x - Fd. other Monuments
• - Set 5/8" I. Rod