SURVEY IN SECTIONS 9 & 10, T29S, R6W, W.M., DOUGLAS COUNTY, OREGON

Surveyed for Willis Creek Properties Inc. by Victor M. McLind

July 1971

Scale : 1" = 200'

Bearings Based on Solar Observation April 1, 1971

• Indicates Fd. 5/8" I. Rod - See C.S. 55/195

○ Indicates Set 5/8" I. Rod

COUNTY SURVEYORS FILE DATA
DO NOT REMOVE FROM OFFICE

FILED
RECEIVED
AUG 9 1971
COUNTY SURVEYOR
DOUGLAS COUNTY, ORE.

M 43 - 25

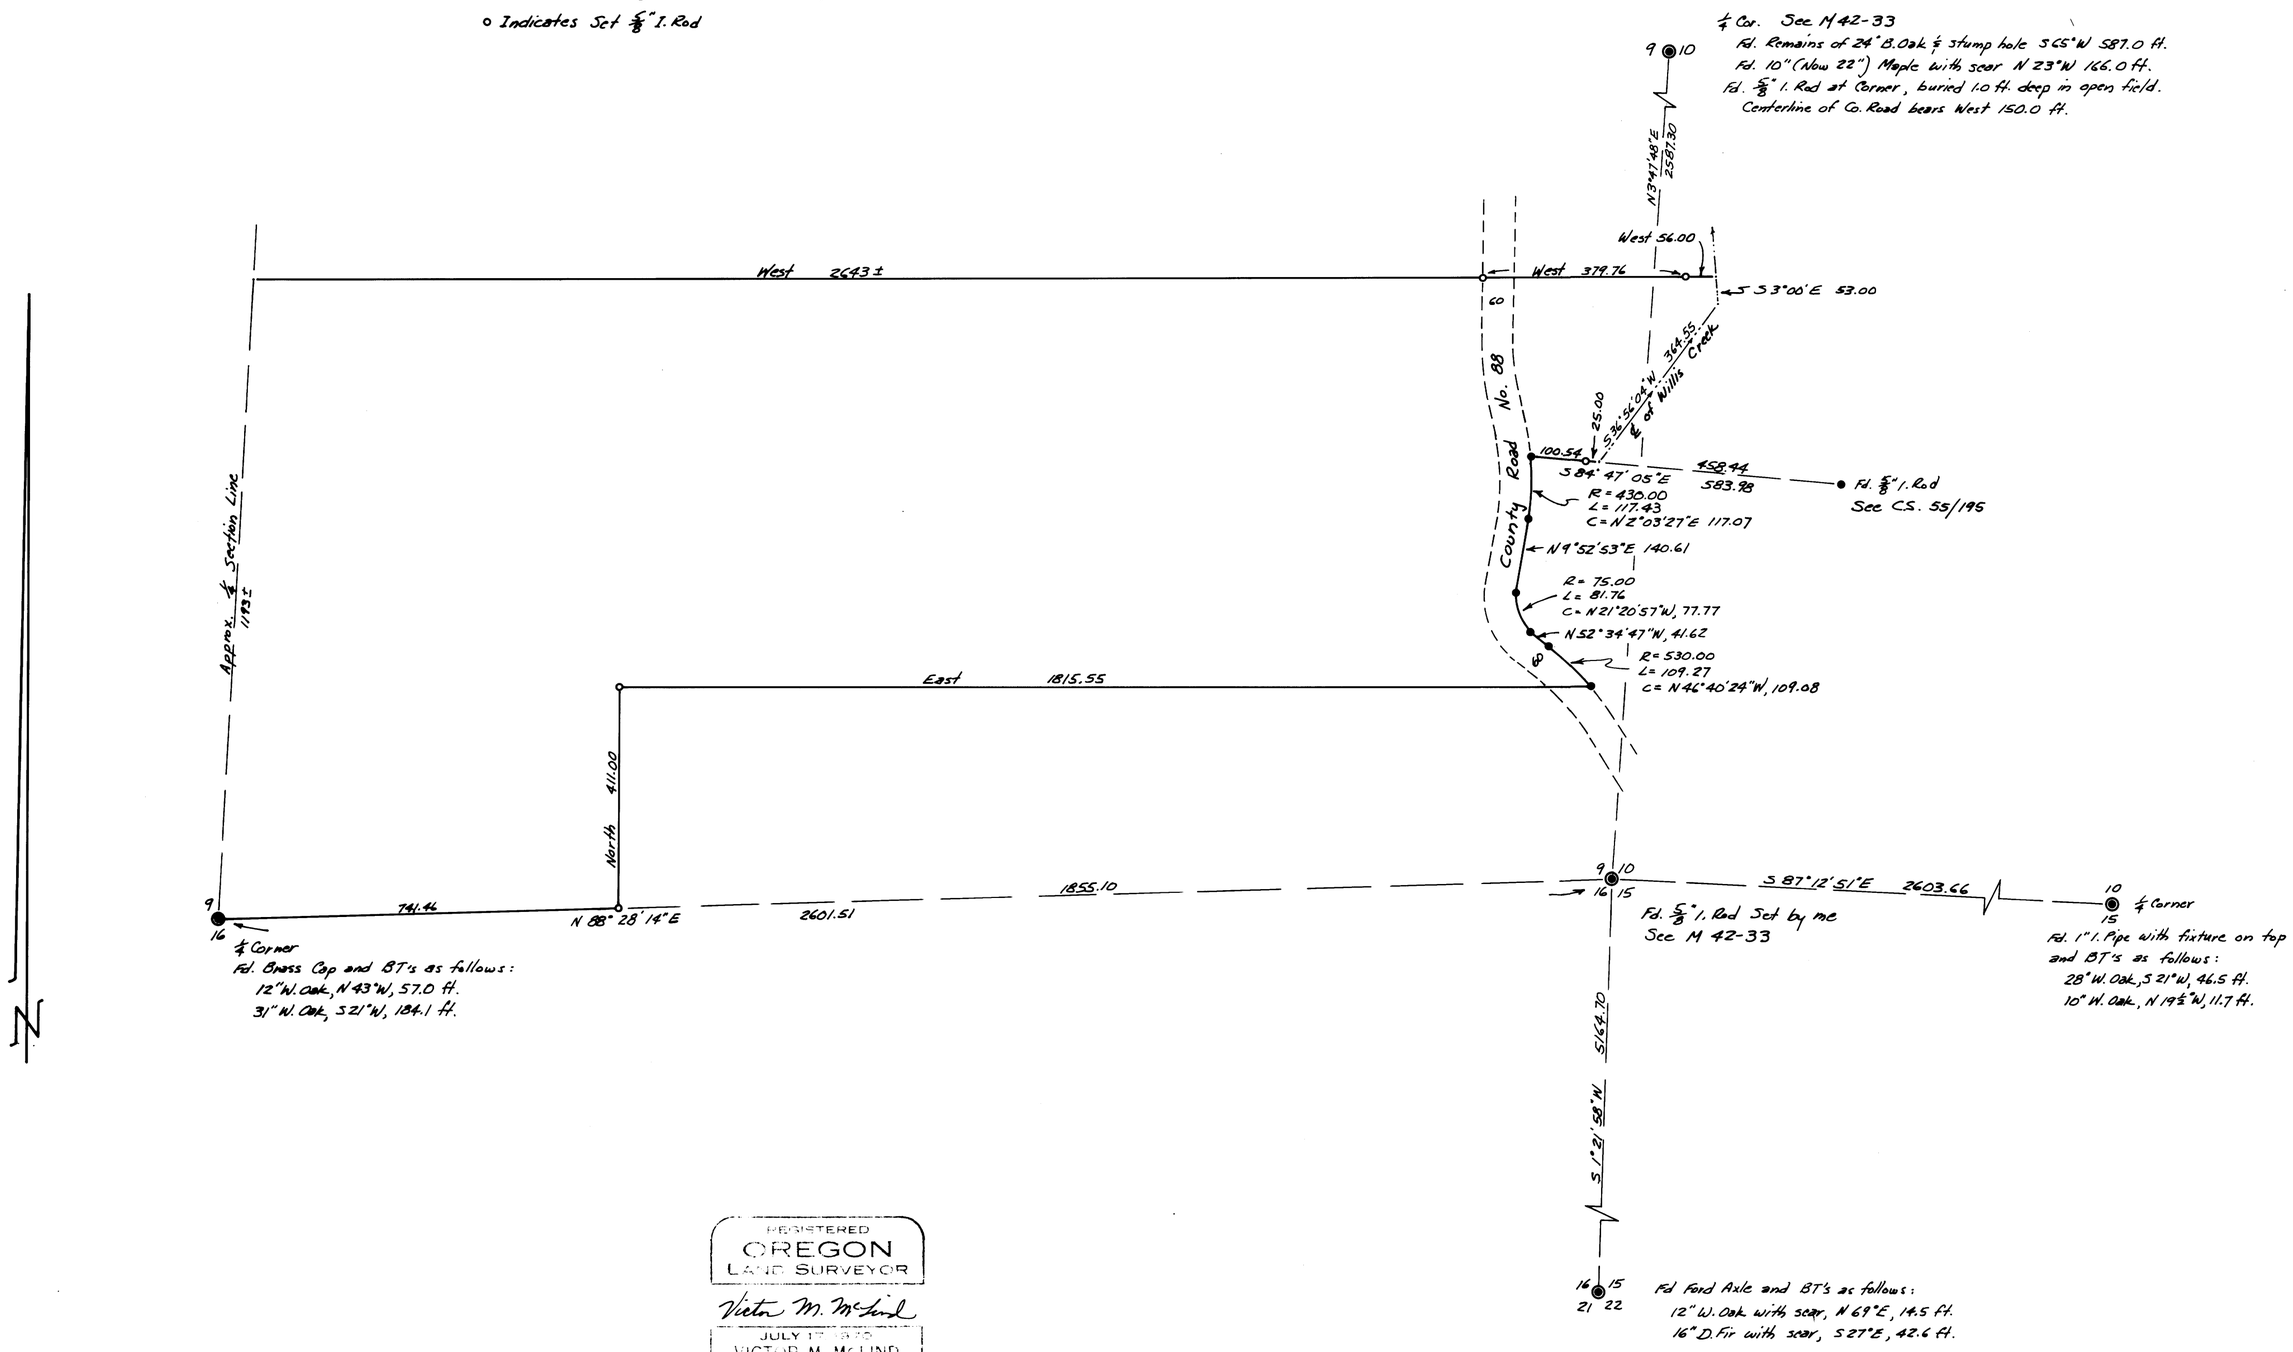

REGISTERED
OREGON
LAND SURVEYOR
Victor M. McLind
JULY 17, 1970
VICTOR M. McLIND
934

P FILE M 43 - 25