M 43-30

COUNTY SURVEYORS FILE DATA
DO NOT REMOVE FROM OFFICE

FILED
RECEIVED
AUG 13 1971
COUNTY SURVEYOR
DOUGLAS COUNTY, ORE.

SURVEY FOR DEED DESCRIPTION
SITUATED IN SEC. 10, T.26S., R.6 W.W.M.
T.28 S

SURVEY FOR PINGLETON

SURVEY BY BAUGHMAN SURVEYING SERVICE

SCALE 1"=40'

JULY 1971

REGISTERED
OREGON
LAND SURVEYOR
JULY 14, 1961
GLENN S BAUGHMAN
536

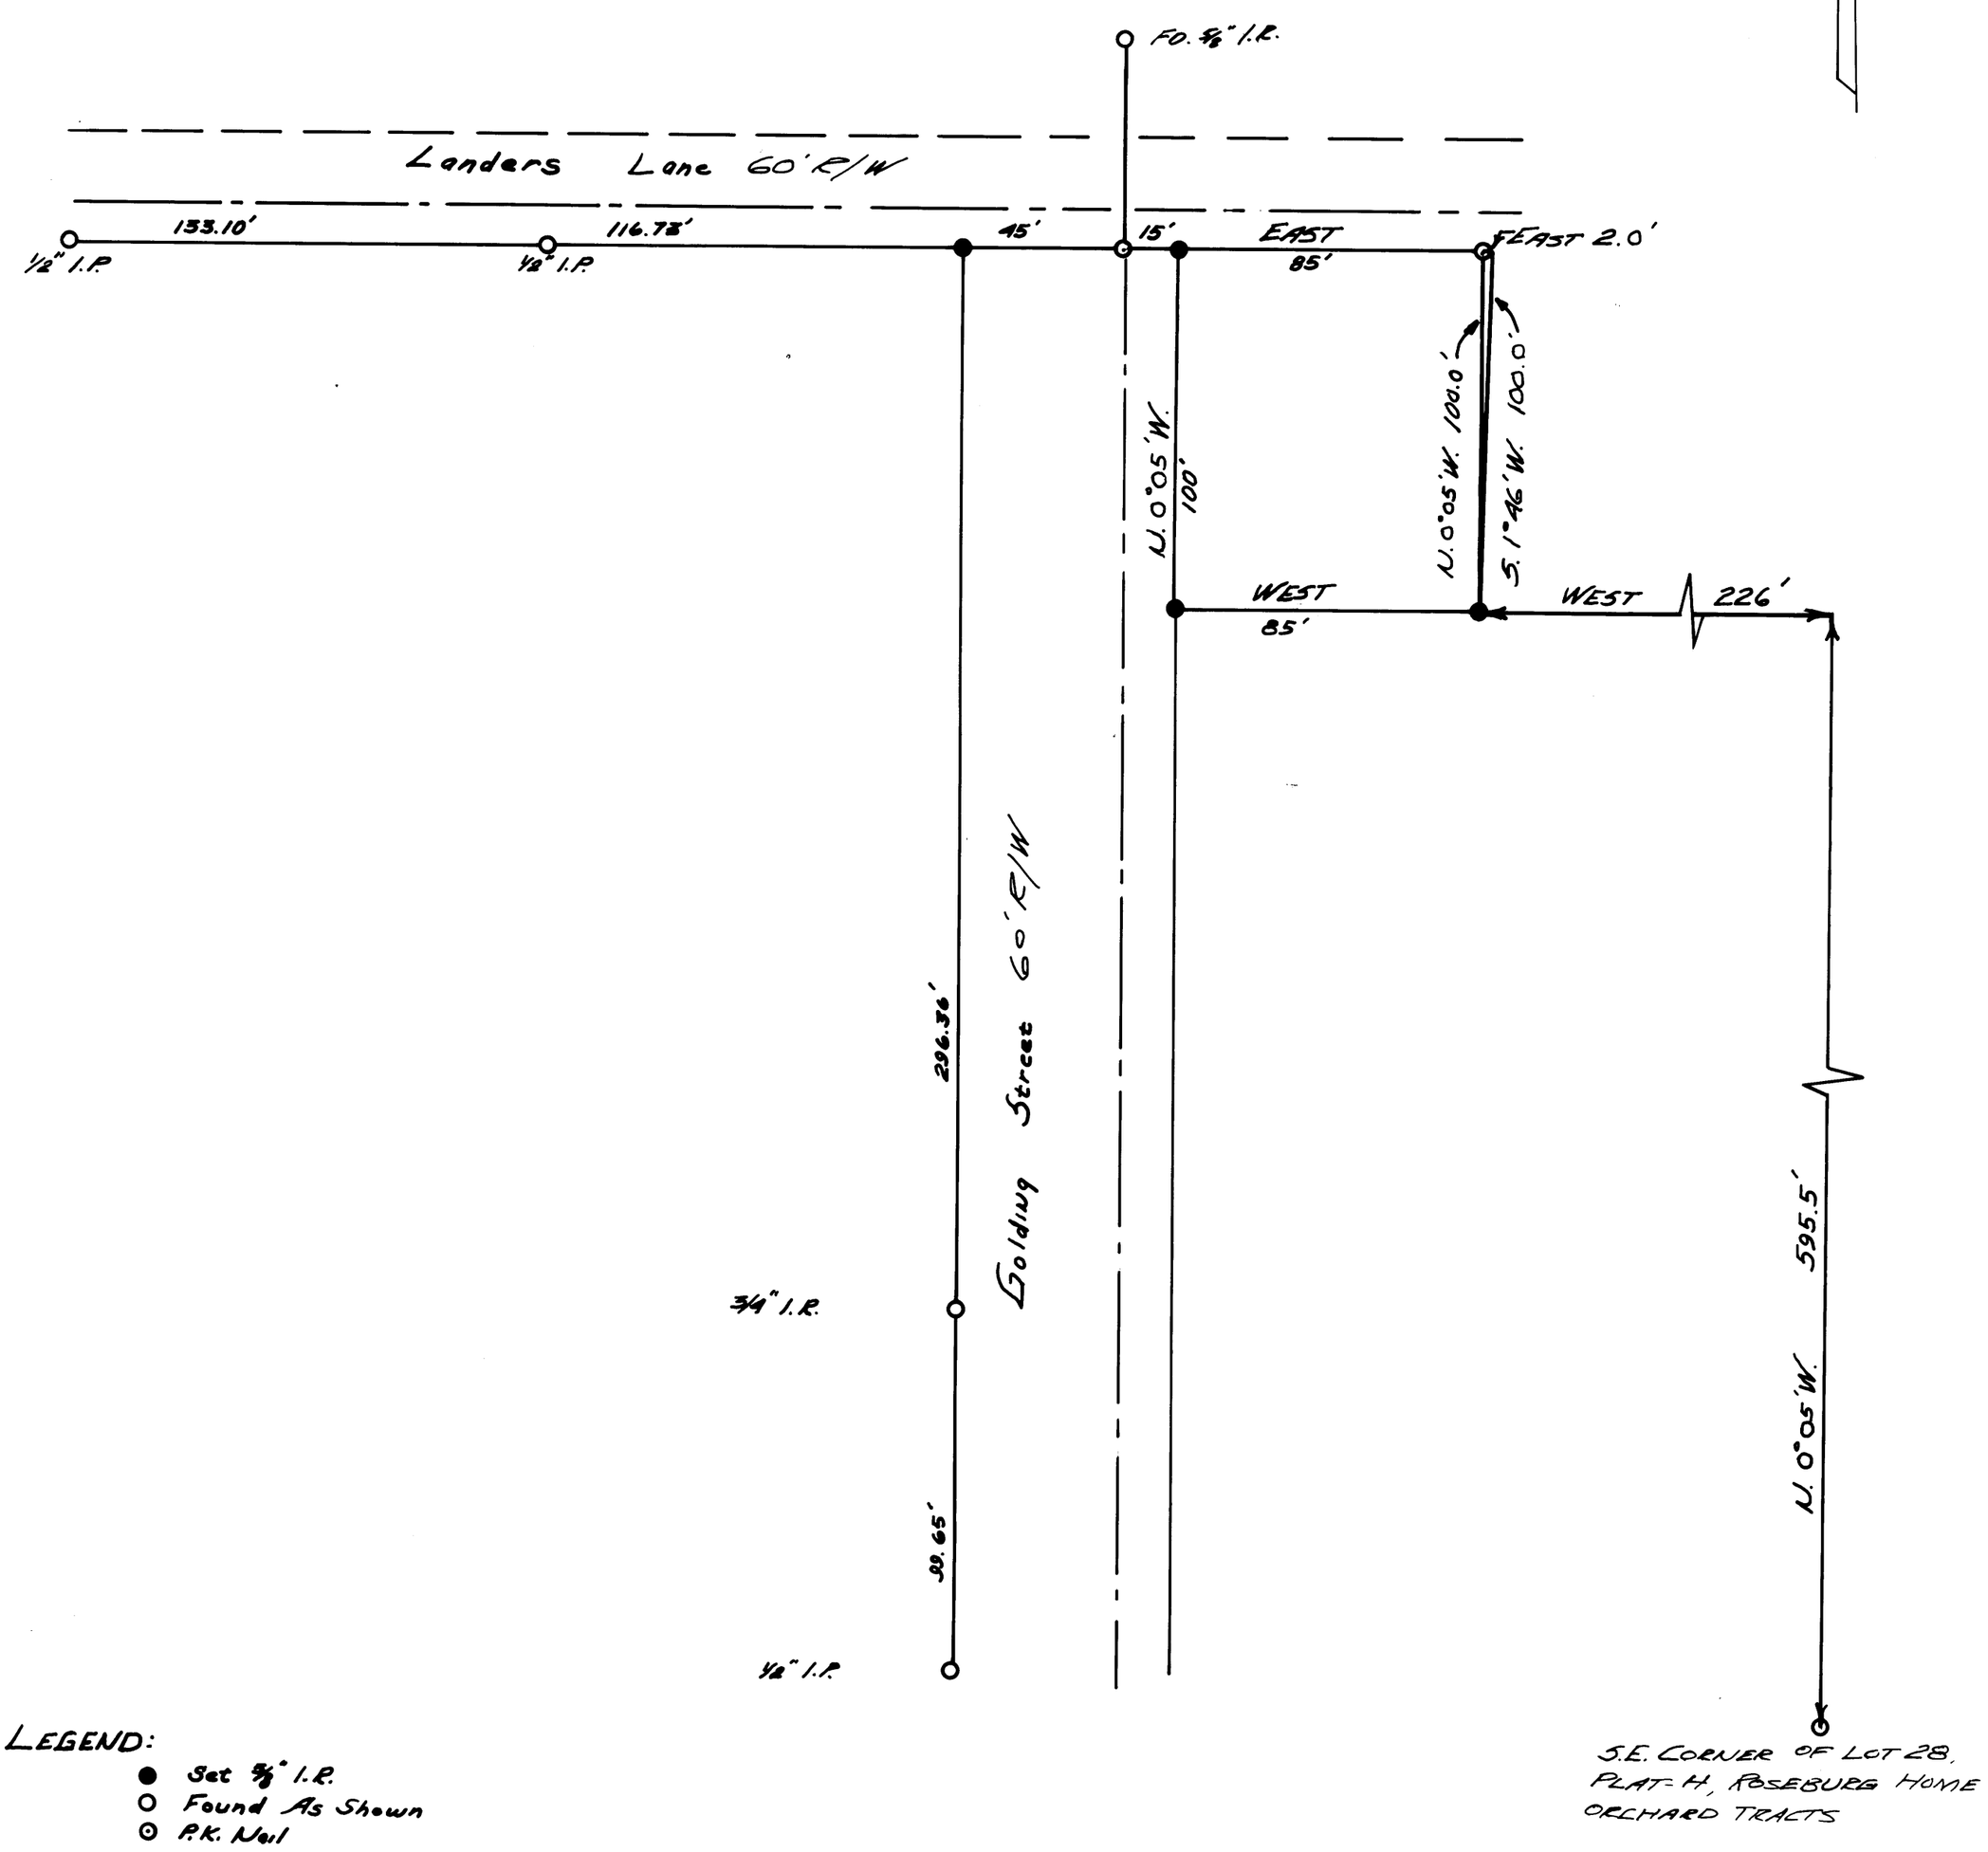

LEGEND:
- ● Set 5/8" I.R.
- ○ Found As Shown
- ⊙ P.K. Nail

M 43-30