M43-33

COUNTY SURVEYORS FILE DATA
DO NOT REMOVE FROM OFFICE

SURVEY FOR PROPERTY CORNERS IN SEC. 14, T.26S., R.4 W.W.M.

SURVEY FOR MR. A.J. UPDEGRAVE

SURVEY BY BAUGHMAN SURVEYING SERVICE

SCALE 1" = 50'

AUGUST 1971

REGISTERED
OREGON
LAND SURVEYOR
Glenn S. Baughman
JULY 14, 1961
GLENN S. BAUGHMAN
536

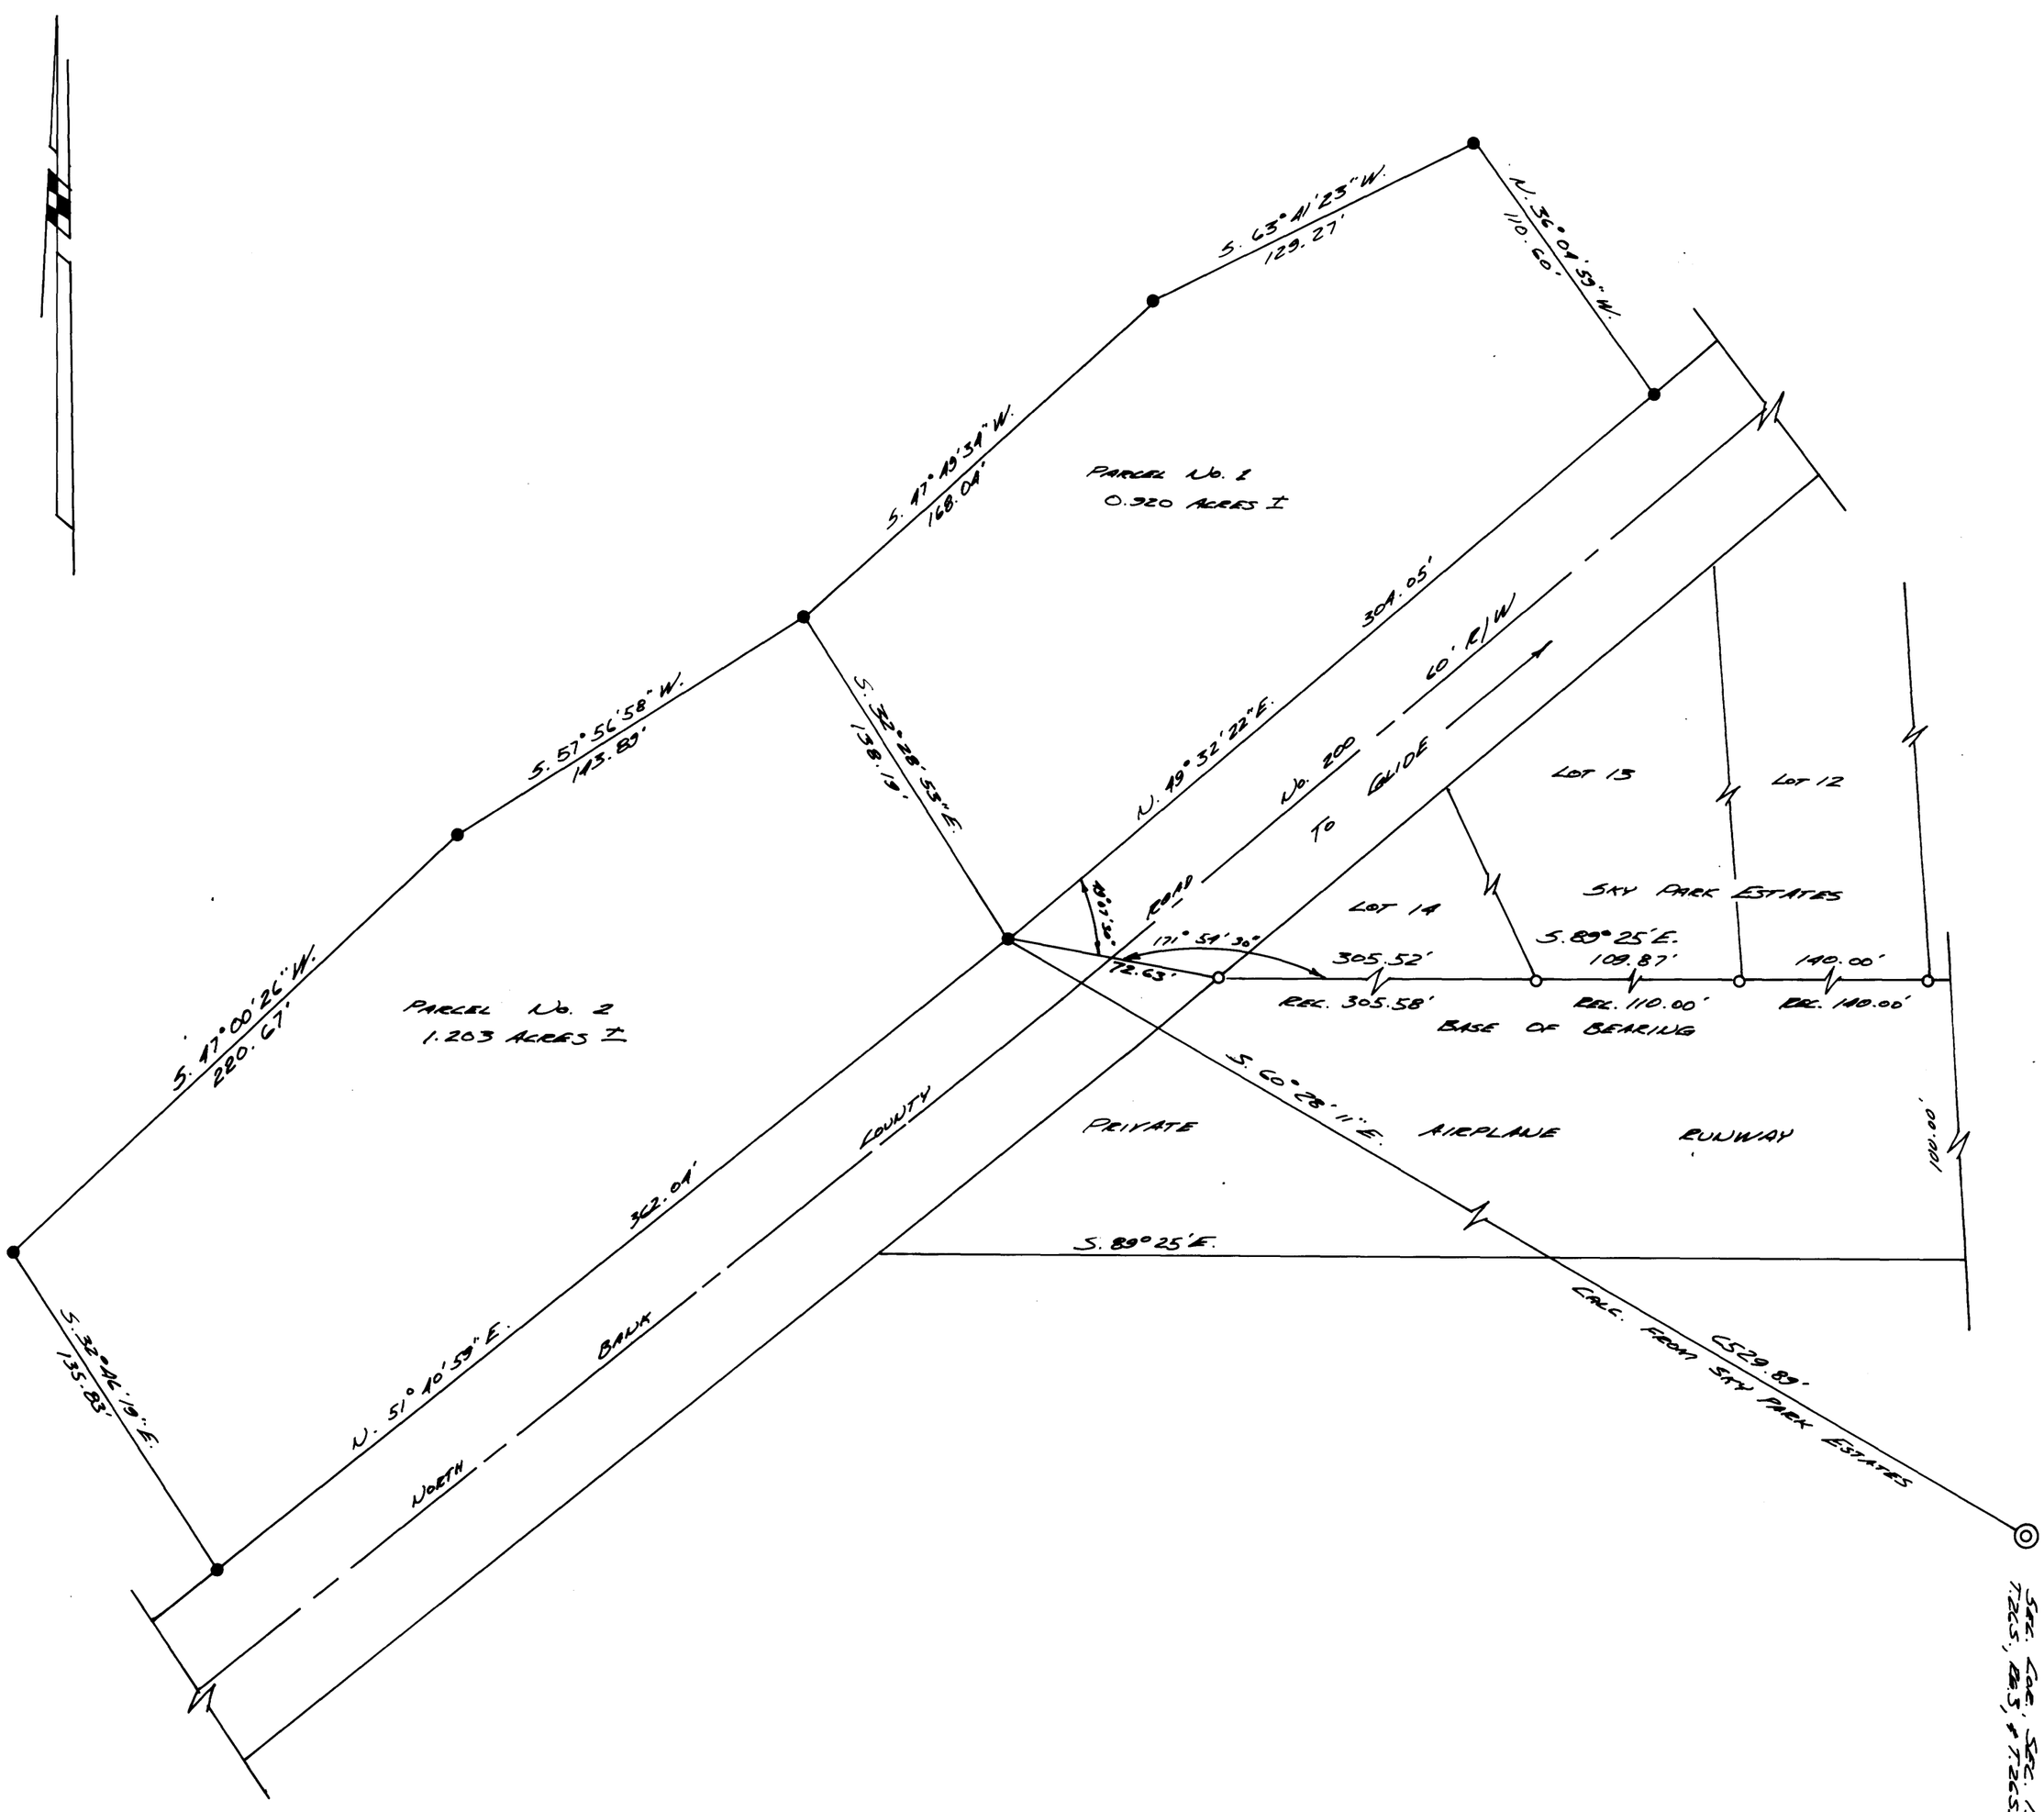

LEGEND:
● SET 5/8" I.R.
○ FOUND 5/8" I.R.

M 43 - 33