6E - E4

COUNTY SURVEYOR
DO NOT REMOVE

SURVEY TO SET CORNERS IN BOGGS ORCH. TR. ON LOTS 11 & 12 SECTION 1, T.28S., R.6W., W.M., DOUGLAS COUNTY, ORE

FOR DARRELL WADE

JUNE, 1971

BY HERBERT L. NORTHCRAFT

SCALE 1" = 200'

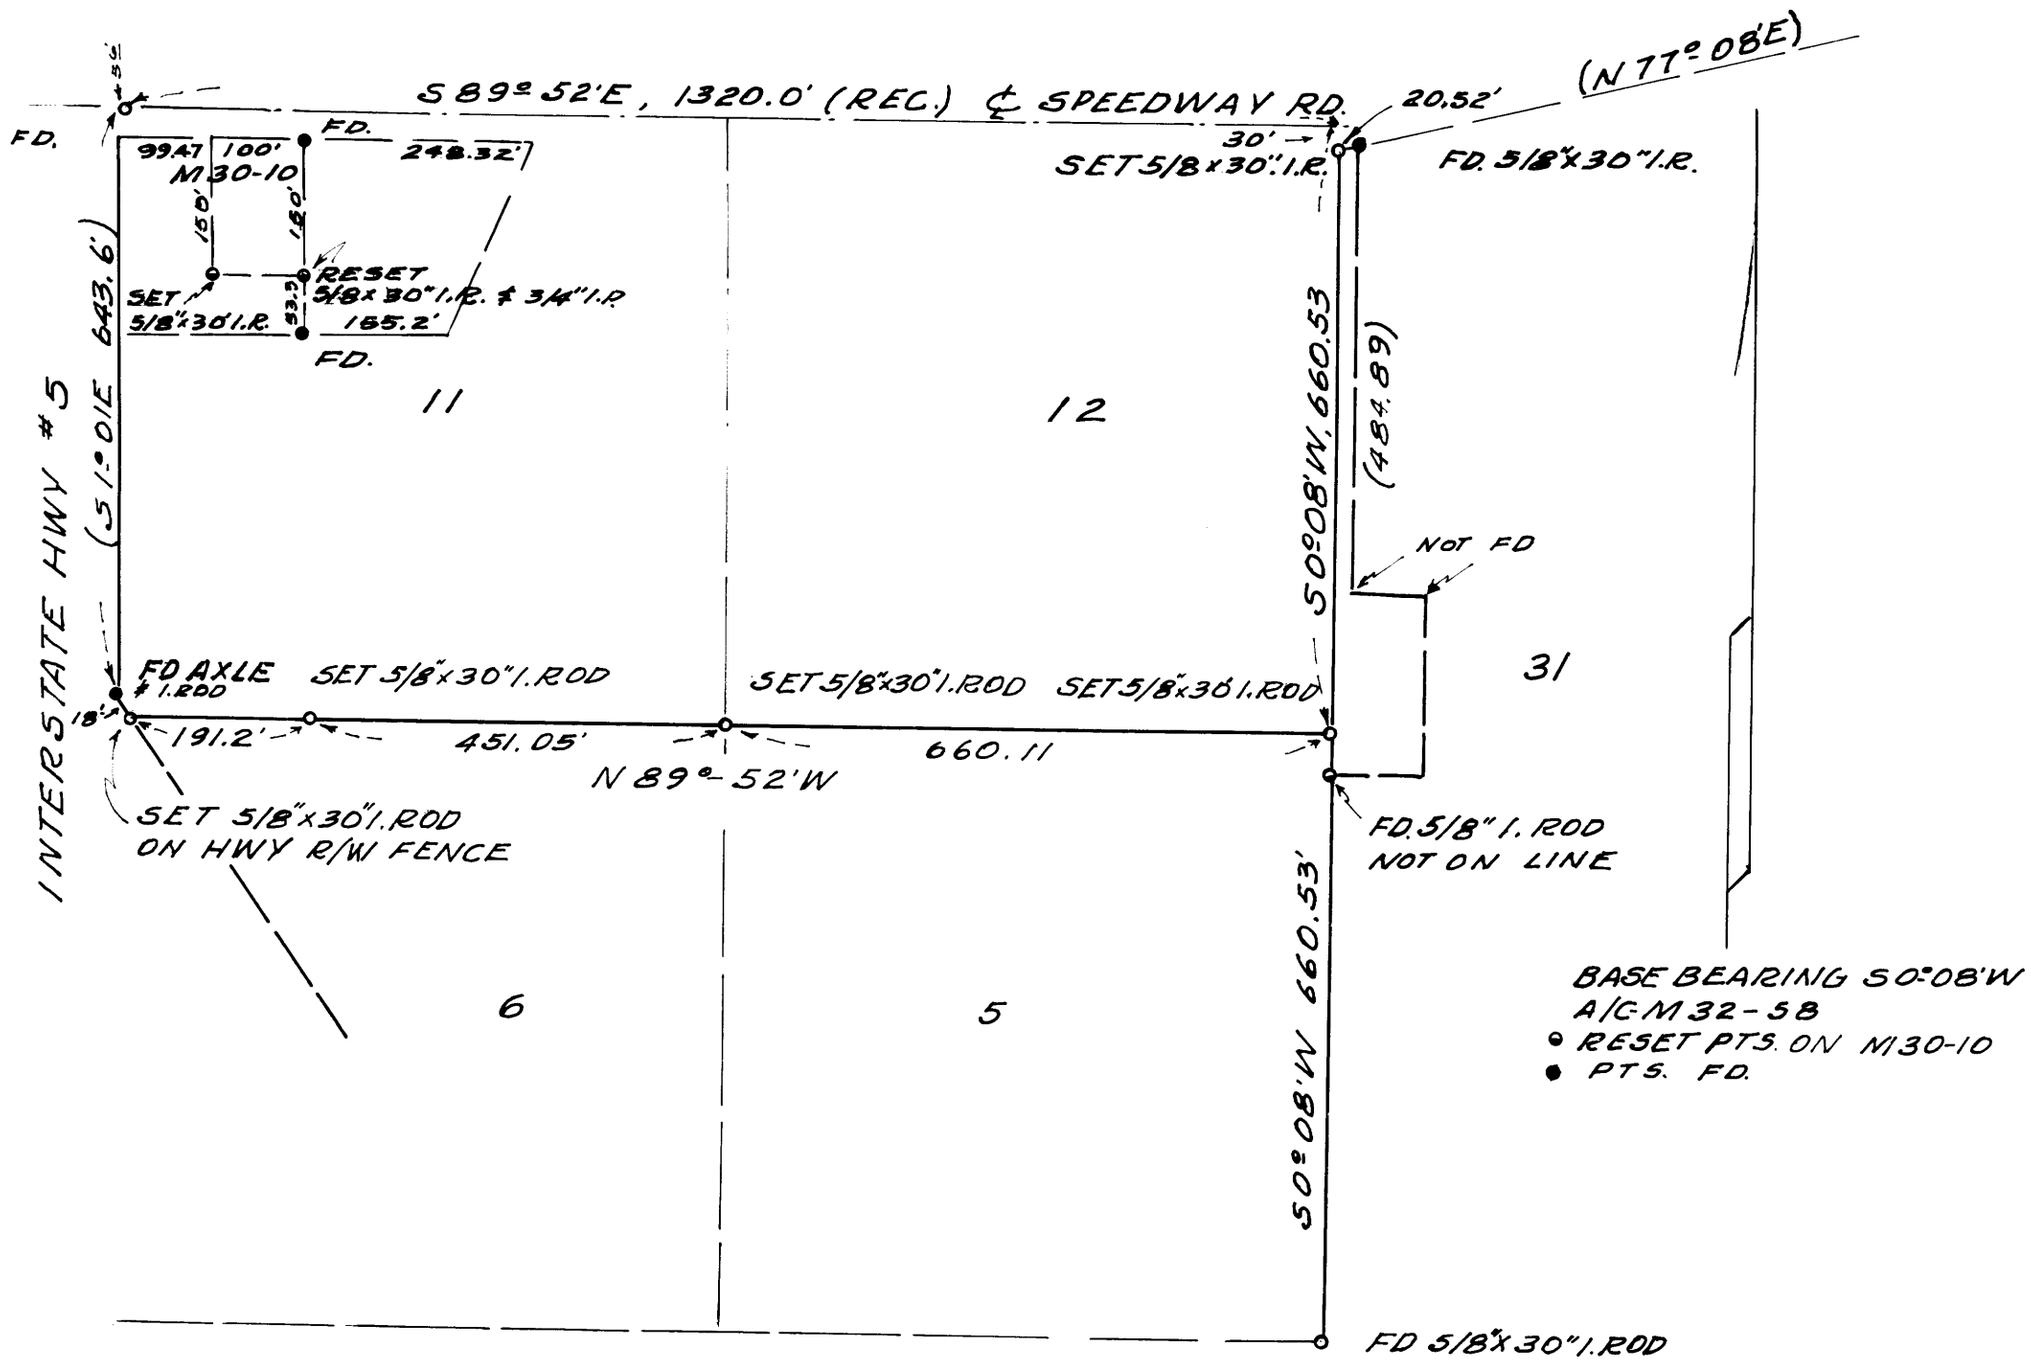

REGISTERED
OREGON
LAND SURVEYOR

Herbert L. Northcraft

JULY 8, 1966
HERBERT L. NORTHCRAFT
750

FILED
RECEIVED
AUG 23 1971
COUNTY SURVEYOR
DOUGLAS COUNTY, ORE.

M43 - 37