COUNTY SURVEYORS FILE DATA
DO NOT REMOVE FROM OFFICE

FILED
RECEIVED
SEP 9 1971
COUNTY SURVEYOR
DOUGLAS COUNTY, ORE.

MAP FILE M43-42

R.W. - Dec. 30, 1971

SURVEY IN SECTIONS 26, 23, 27, DLC 47, TOWNSHIP 26 SOUTH, RANGE 6 WEST, WILLAMETTE MERIDIAN

Surveyed for R. L. McDonald by Don E. Garrett

May, 1971

Scale 1" = 200'

○ —— Set 5/8" Iron Rod
● —— Found 5/8" Iron Rod

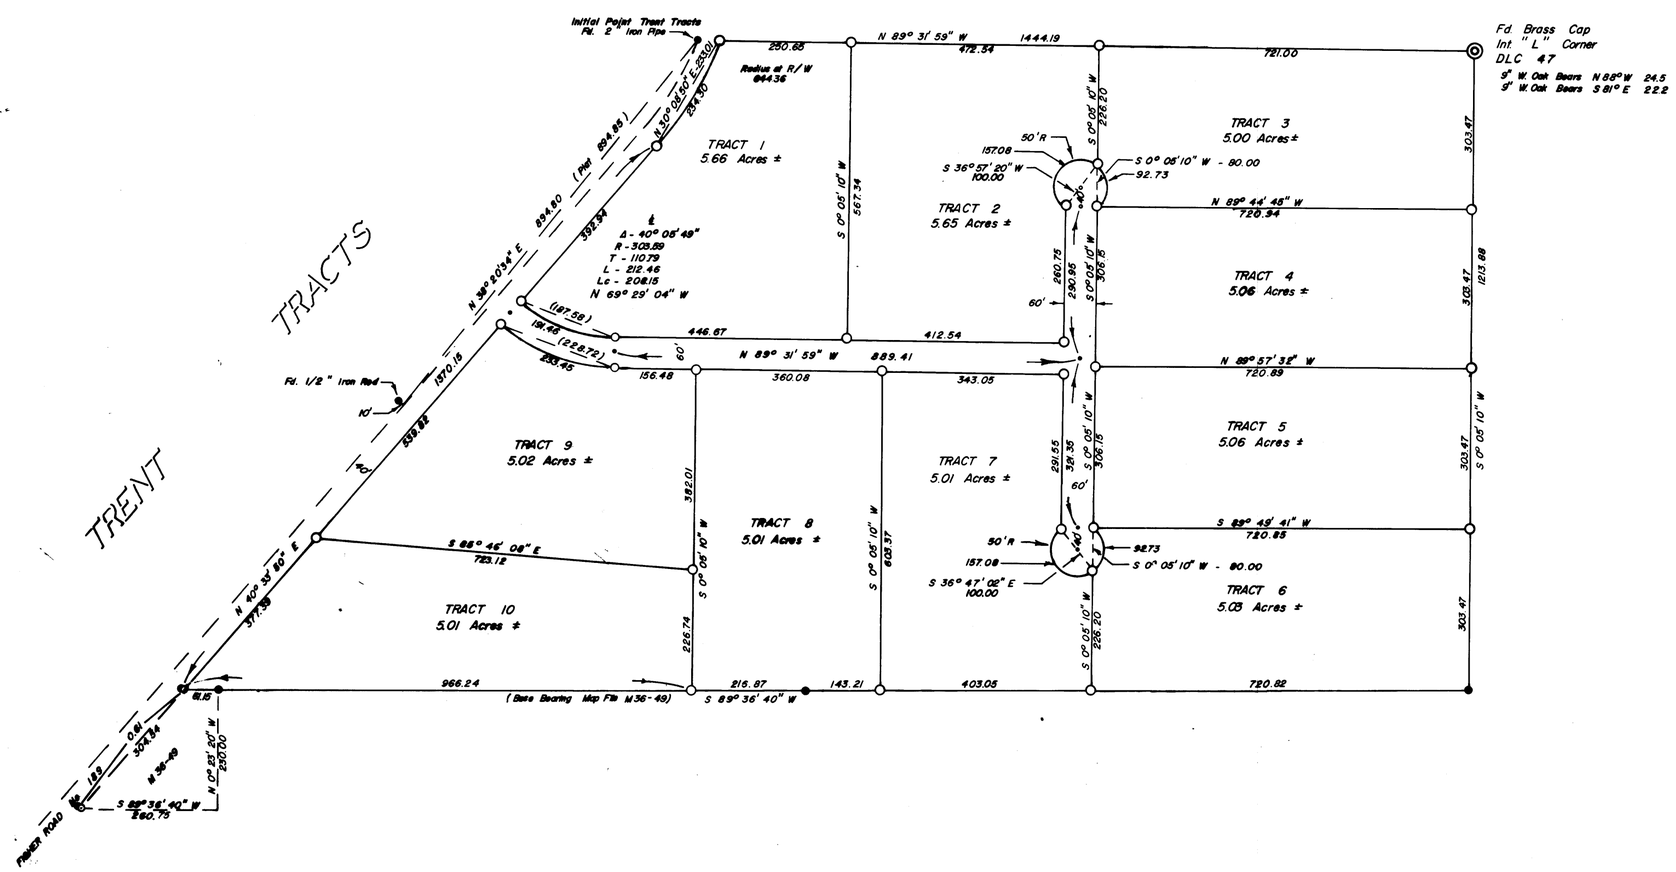

REGISTERED
OREGON
LAND SURVEYOR
Don E. Garrett
JULY 14, 1961
DON E. GARRETT
544

MAP FILE M43-42