# SURVEY FOR DESCRIPTION IN ROBERT TATE DLC #42
## SEC. 2 & 3, T 28 S., R 7 W., W.M., DOUGLAS COUNTY, ORE.
## FOR DORIS L. & IVAN M. MATTHEWS, - PORTION OF 188/295

BY- HERBERT L. NORTHCRAFT

SCALE 1" = 100'

OCT. 1971

COUNTY SURVEYOR'S DATA
DO NOT REMOVE FROM OFFICE

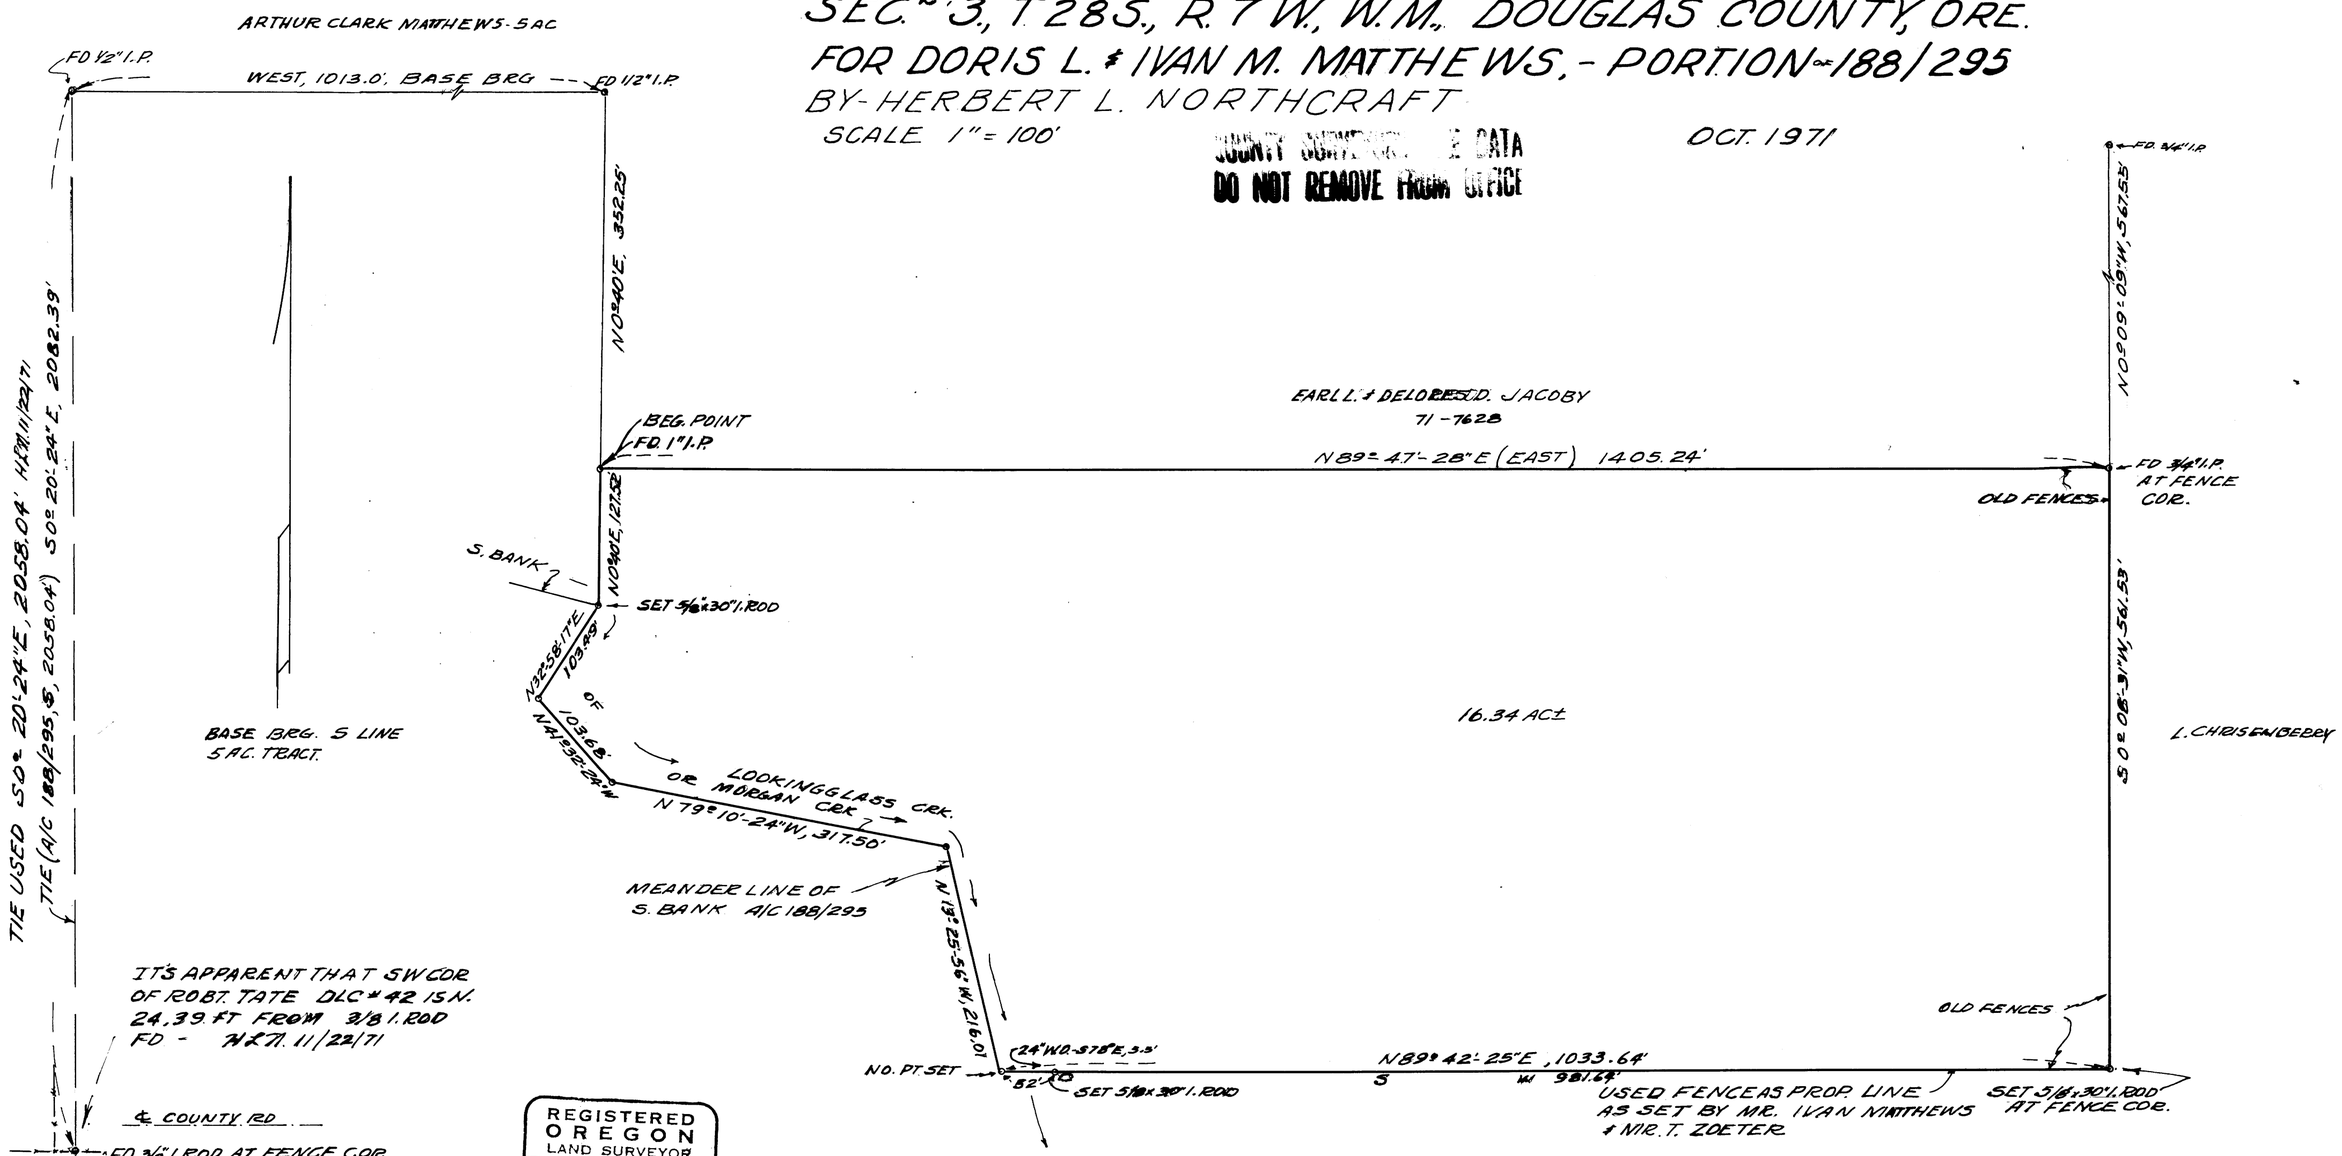


REGISTERED
OREGON
LAND SURVEYOR

Herbert L. Northcraft

JULY 8, 1966
HERBERT L. NORTHCRAFT
750

FILED
RECEIVED

OCT 26 1971

COUNTY SURVEYOR
DOUGLAS COUNTY, ORE.

MAP FILE M.43-65

MAP FILE M.43-65