COUNTY SURVEYORS FILE DATA
DO NOT REMOVE FROM OFFICE

SURVEY FOR DESCRIPTION IN R. TATE DLC #42
SECTION 3, T. 28 S., R. 7 W., W.M., DOUGLAS CO., OREGON
FOR DORIS L. & IVAN MATTHEWS - PORTION OF 188/295

SURVEY BY HERBERT L. NORTHCRAFT

SCALE 1" = 100'

A.A. & MARY JACOBY
209/265

OCT. 1971

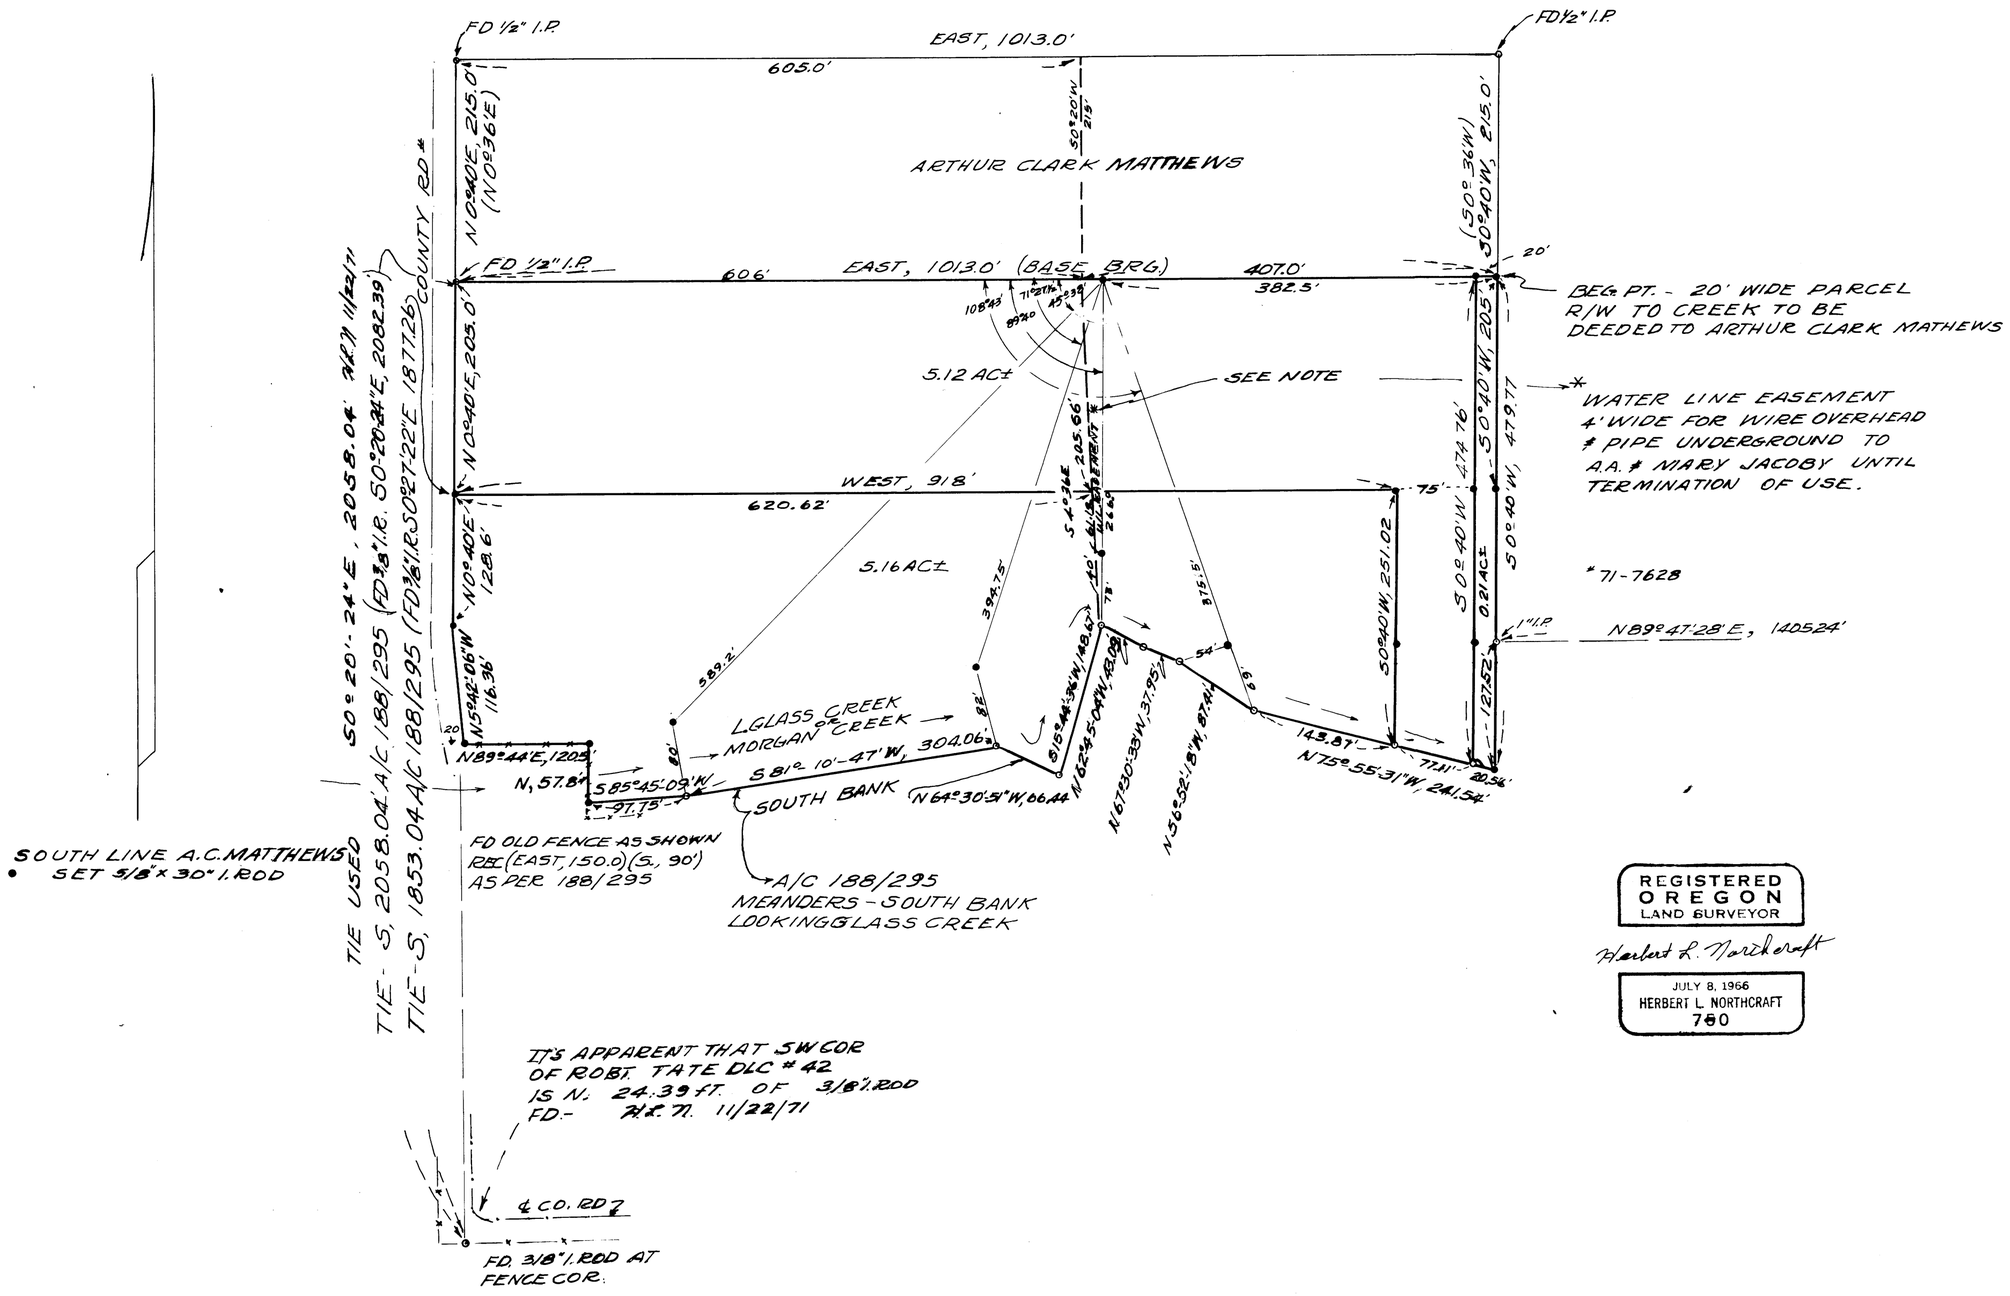

REGISTERED
OREGON
LAND SURVEYOR

Herbert L. Northcraft

JULY 8, 1966
HERBERT L. NORTHCRAFT
750

MAP FILE M 43 - 66

MAP FILE M 43 - 66