FILED
RECEIVED
NOV 8 1971
COUNTY SURVEYOR
DOUGLAS COUNTY, ORE.

MAP FILE M 43 - 70

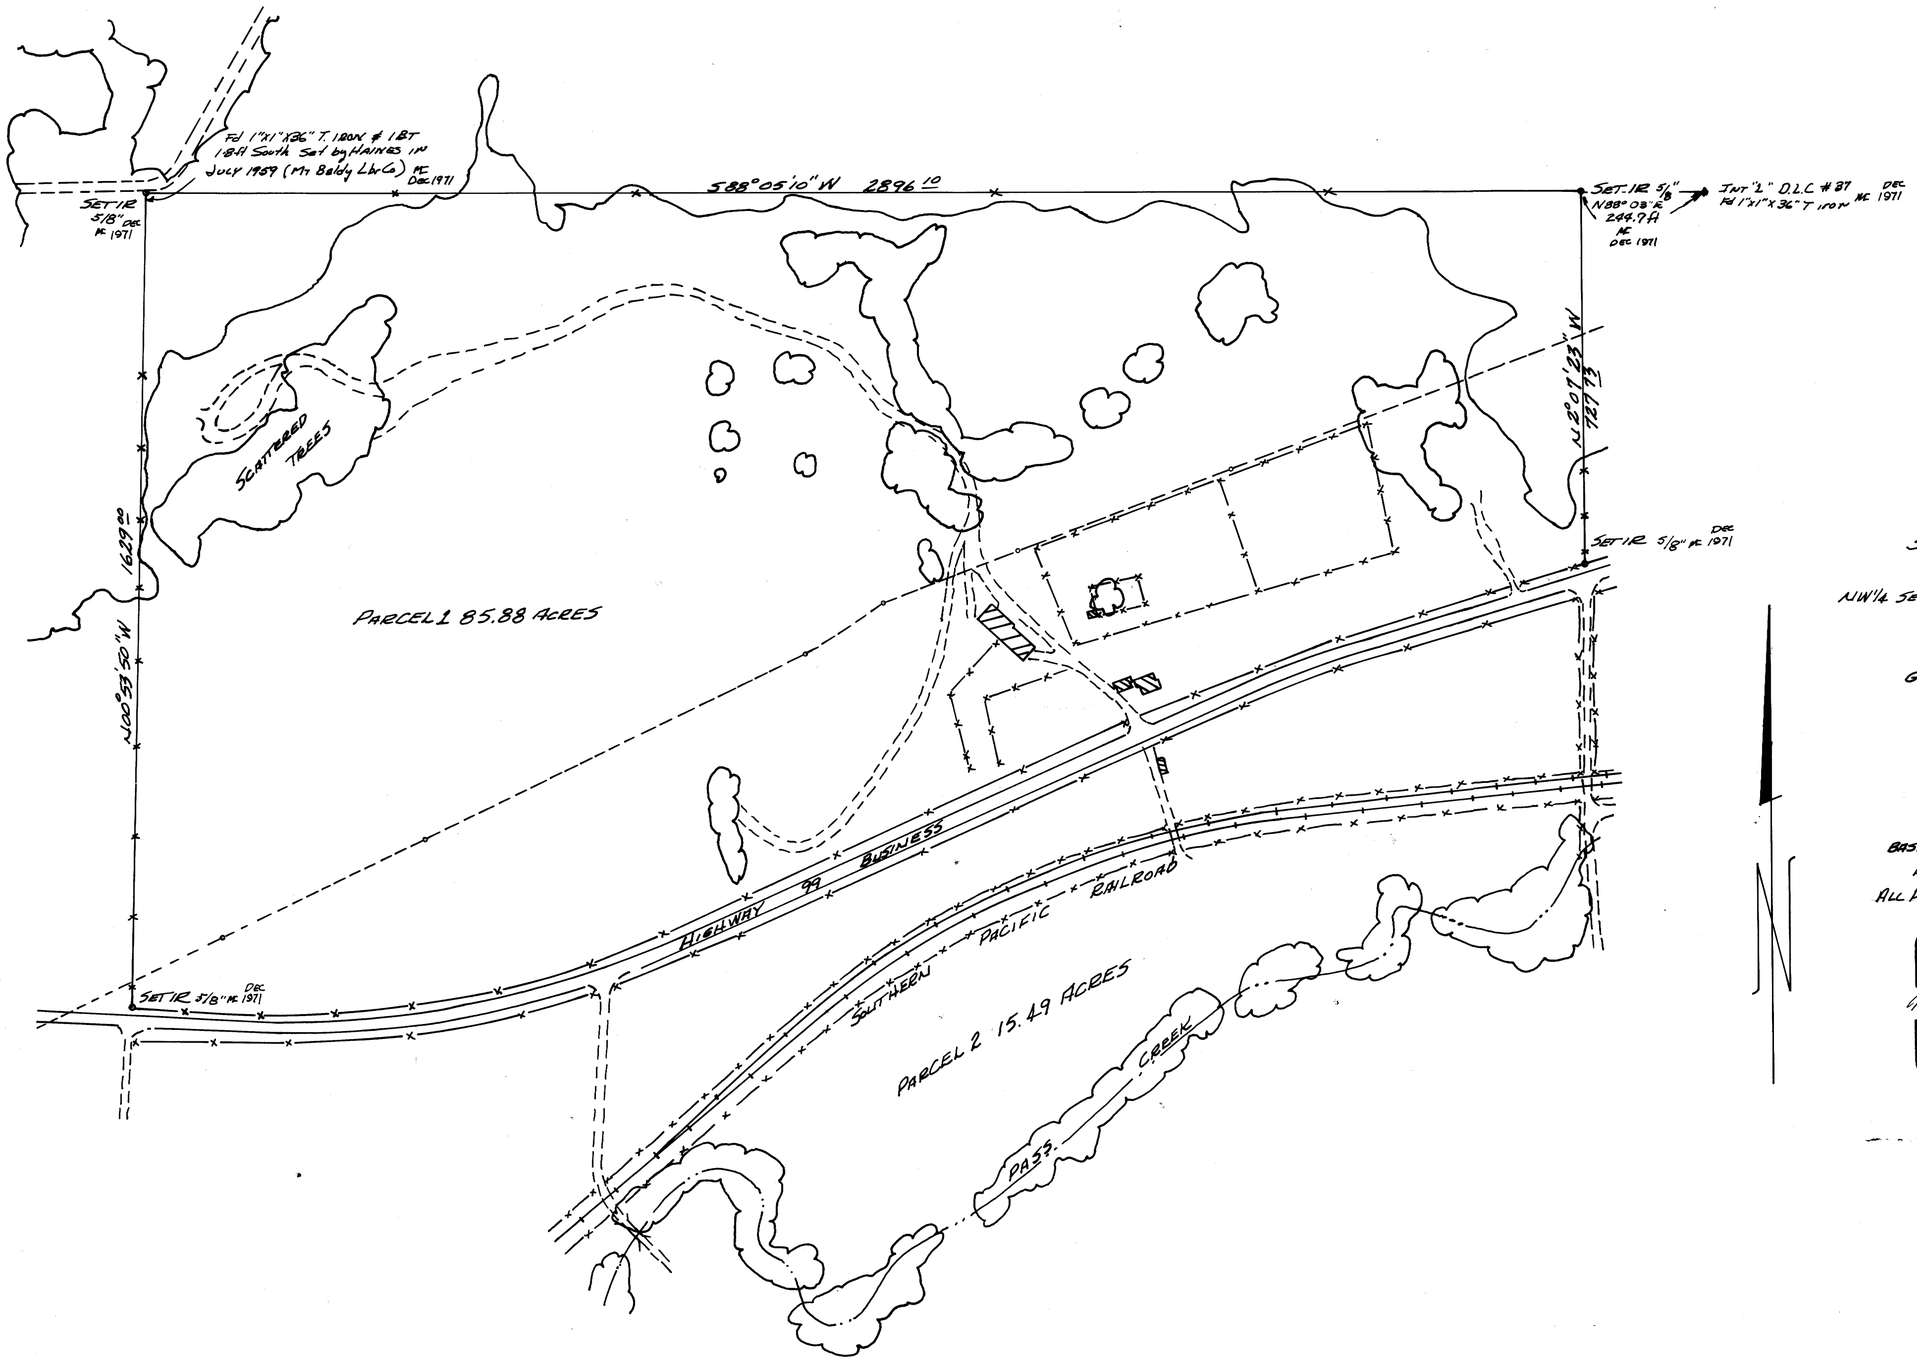

SURVEY FOR FAMBROUGH
IN THE
NW¼ SEC. 35 & THE SW¼ SEC. 35, T. 21S, R. 5W, W.M.
BY
GREEN EMPIRE, INC.
OAKRIDGE, ORE.

OCT., 71 REVISED DEC 1971 - MC
SCALE 1" = 200'

BASIS OF BEARING: MAGNETIC
AREA BY PLANIMETER
ALL PINS SET ARE 5/8"x36" IRON RODS MC DEC 1971

REGISTERED
OREGON
LAND SURVEYOR
Malcolm N. Clark
JULY 12, 1963
MALCOLM N. CLARK
601

COUNTY SURVEYORS FILE DATA
DO NOT REMOVE FROM OFFICE

MAP FILE M 43 - 70