COUNTY SURVEYORS FILE
DO NOT REMOVE FROM OFF

FILED
RECEIVED
NOV 9 1971
COUNTY SURVEYOR
DOUGLAS COUNTY, ORE.

MAP FILE M 43 - 78

SURVEY FOR PROPERTY CORNERS
A PORTION OF SEC. 14, T.27S., R.6 W.W.M.
SURVEY FOR MR. COLLINS J. OAKES
SURVEY BY BAUGHMAN SURVEYING SERVICE

SCALE 1"=20'

SEPTEMBER 1971

REGISTERED
OREGON
LAND SURVEYOR
JULY 14, 1961
GLENN S. BAUGHMAN
536

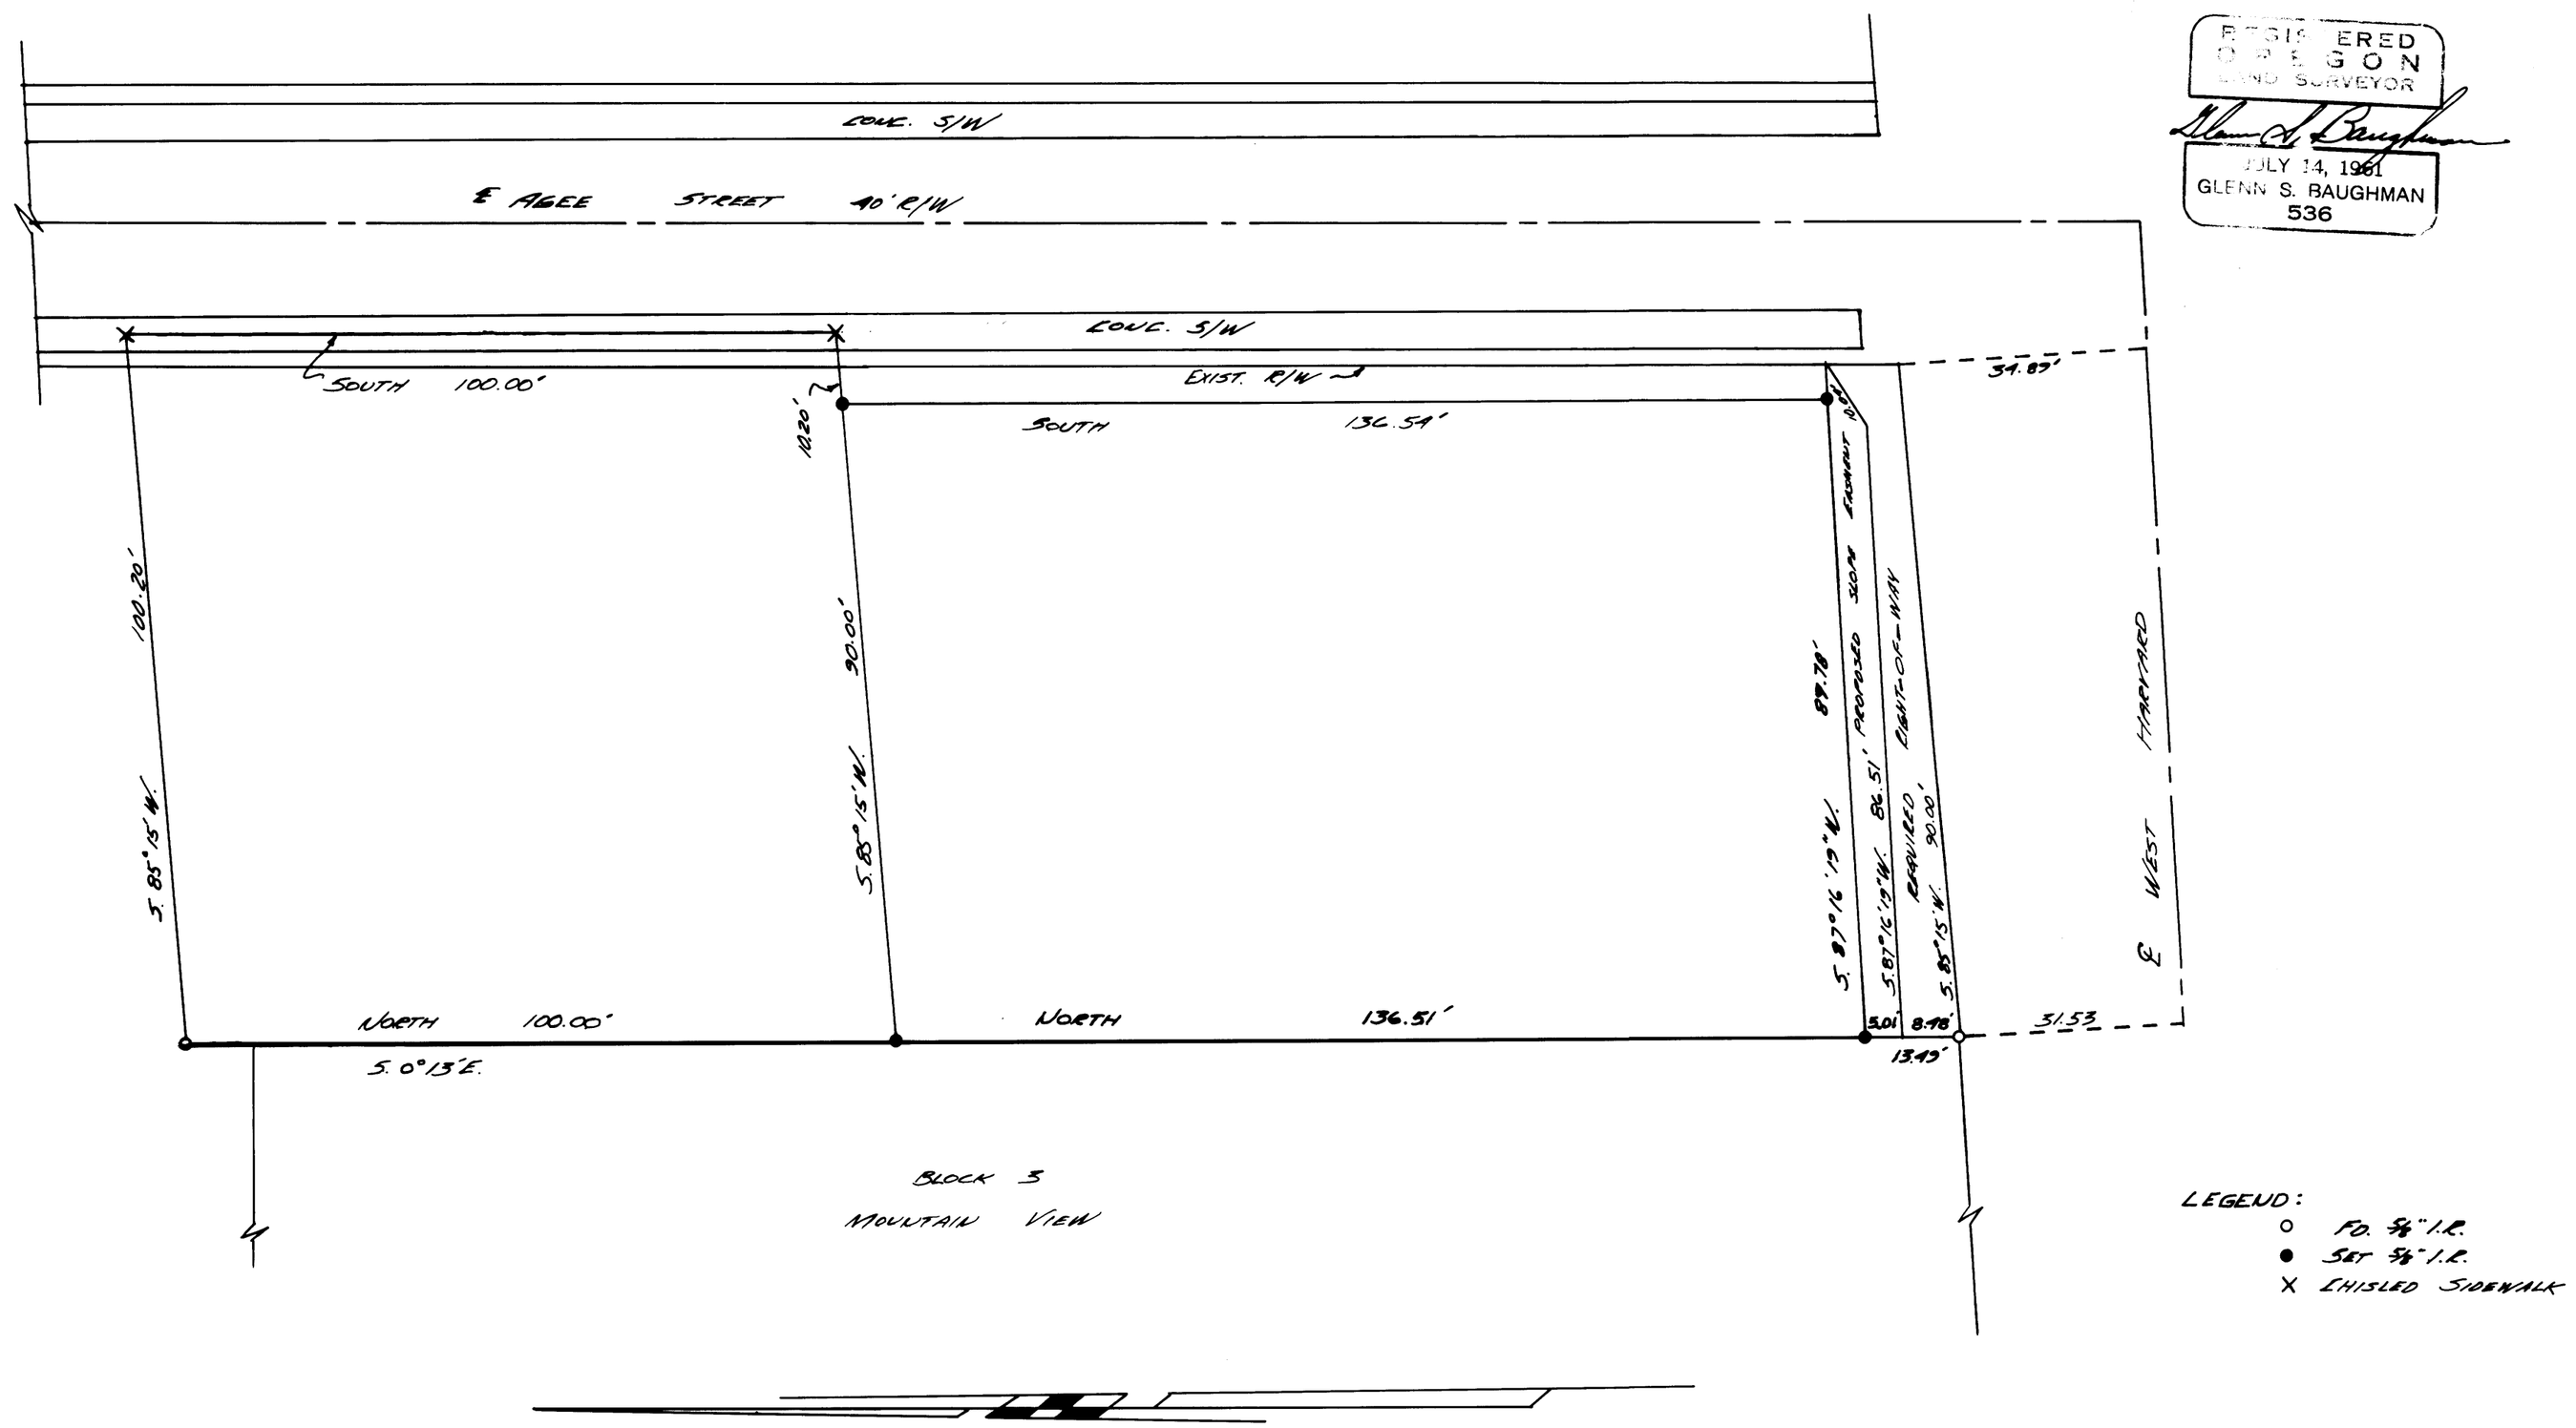

LEGEND:
- ○ FD. 5/8" I.R.
- ● SET 5/8" I.R.
- X CHISLED SIDEWALK

MAP FILE M 43 - 78