SURVEY IN SEC. 19, T25S, R4W, & SEC. 24, T25S, R5W, W.M., DOUGLAS COUNTY, OREGON

Surveyed For Bob Wiley by Victor M. McLind

OCTOBER 1971

COUNTY SURVEYORS FILE DA
DO NOT REMOVE FROM OFF

SCALE : 1" = 400'

Bearings Based on Solar Observation Oct. 18, 1971

o ~ Indicates Set 5/8" I. Rod

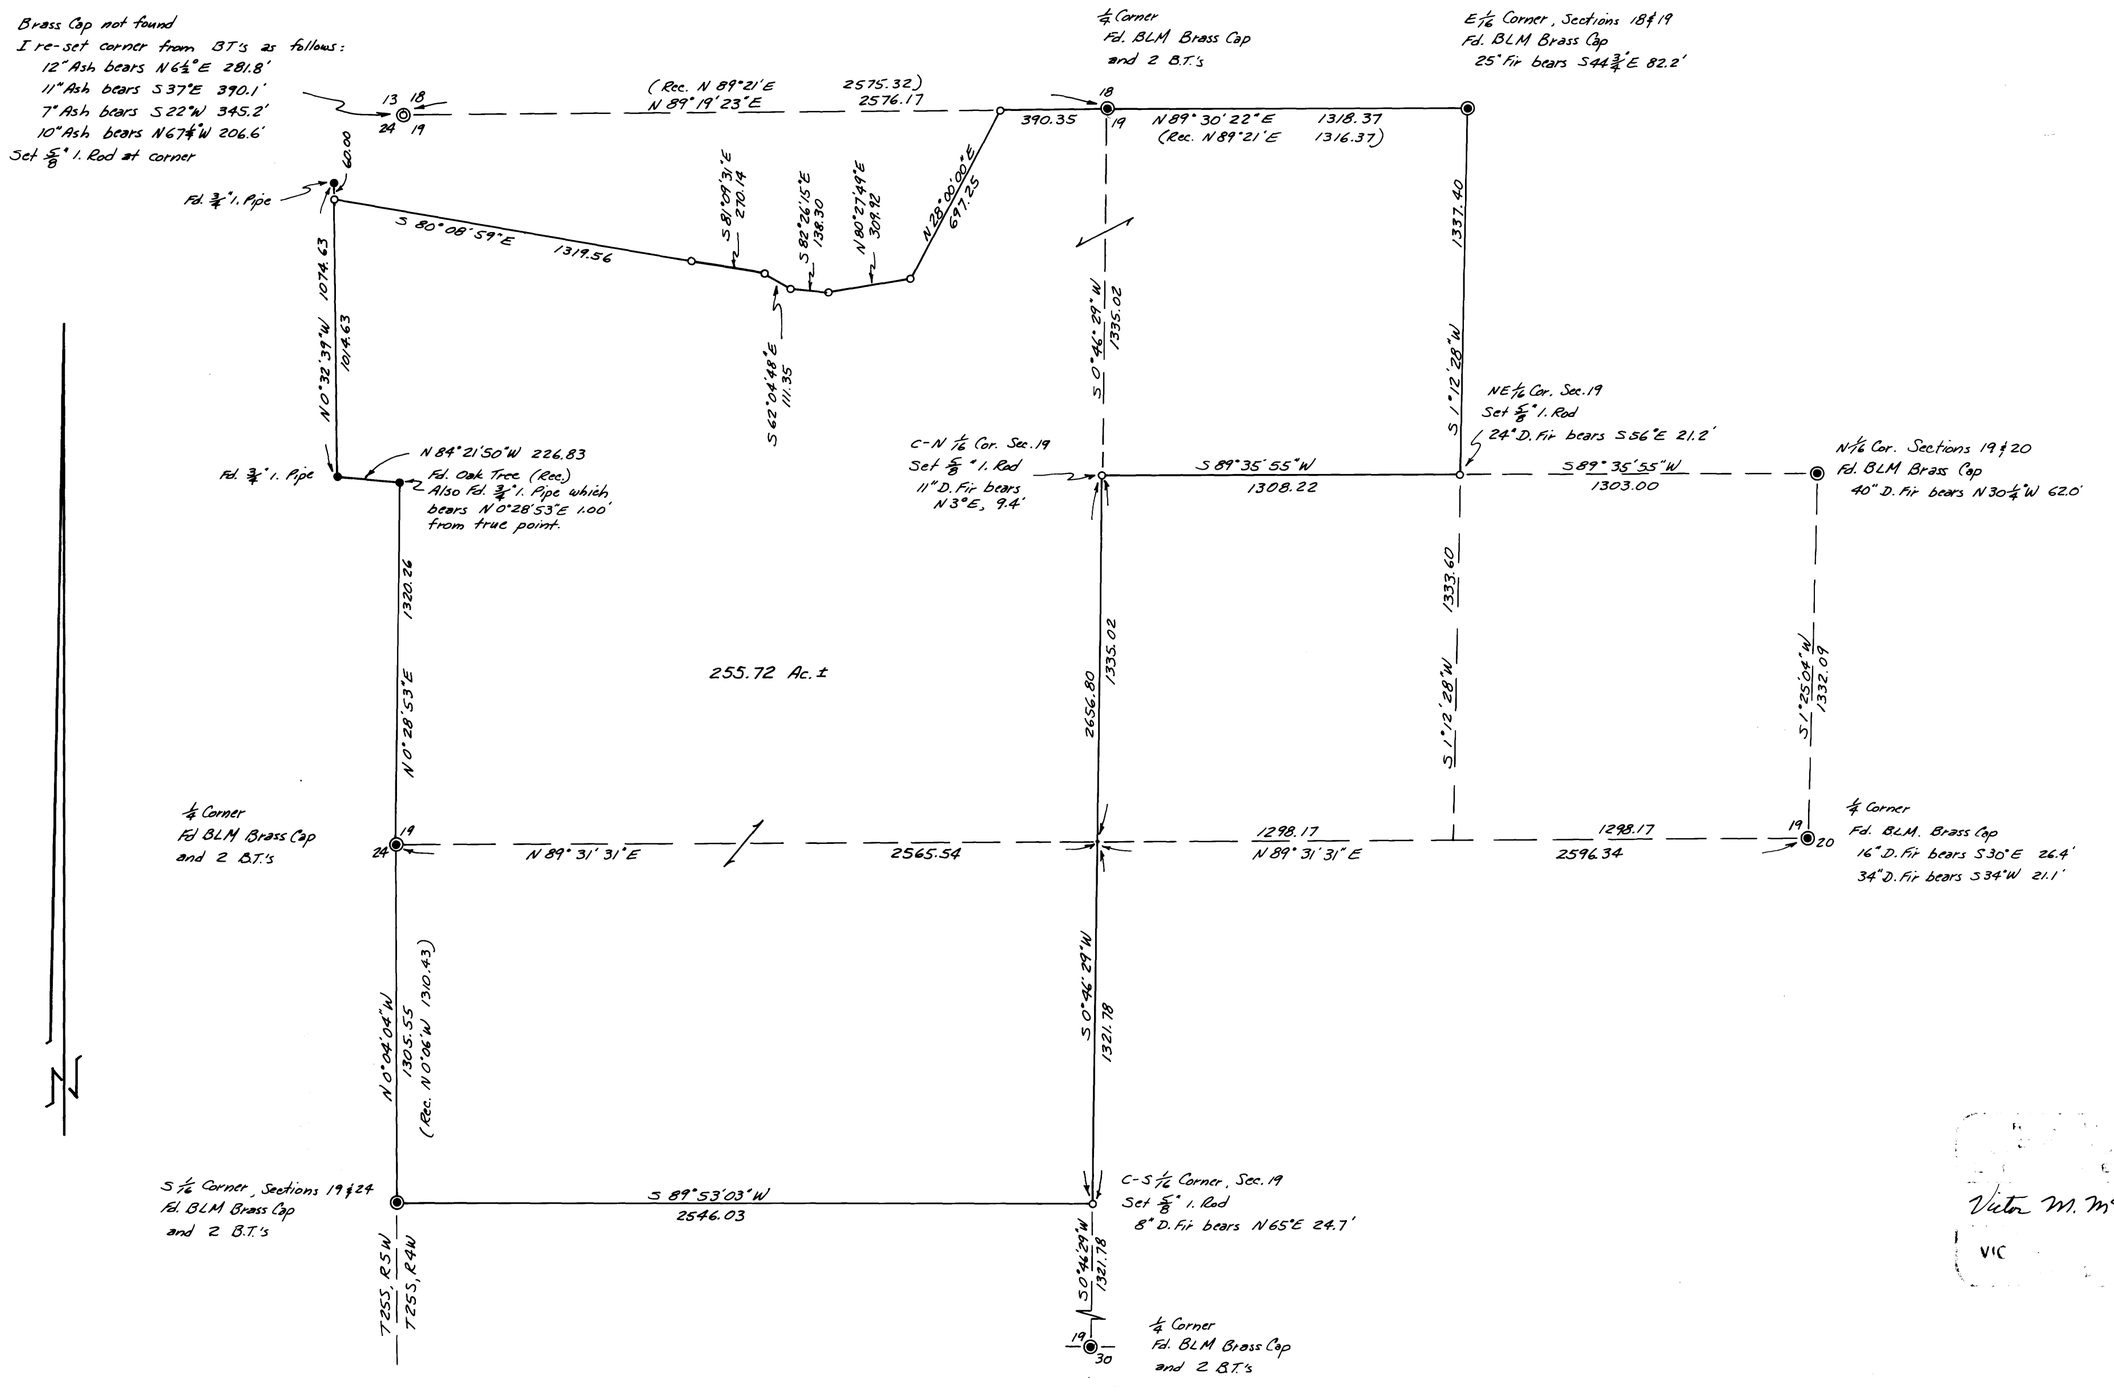

Victor M. McLind

VIC

M 43 - 79