M 44 - 11

COUNTY SURVEYORS FILE DATA
DO NOT REMOVE FROM OFFICE

SURVEY FOR DEED DESCRIPTIONS
IN SEC. 11, T. 26 S., R. 3 W.W.M.
FOR KENNETH TAYLOR
by BRUCE ROGERS
DEC., 1971
1" = 200'

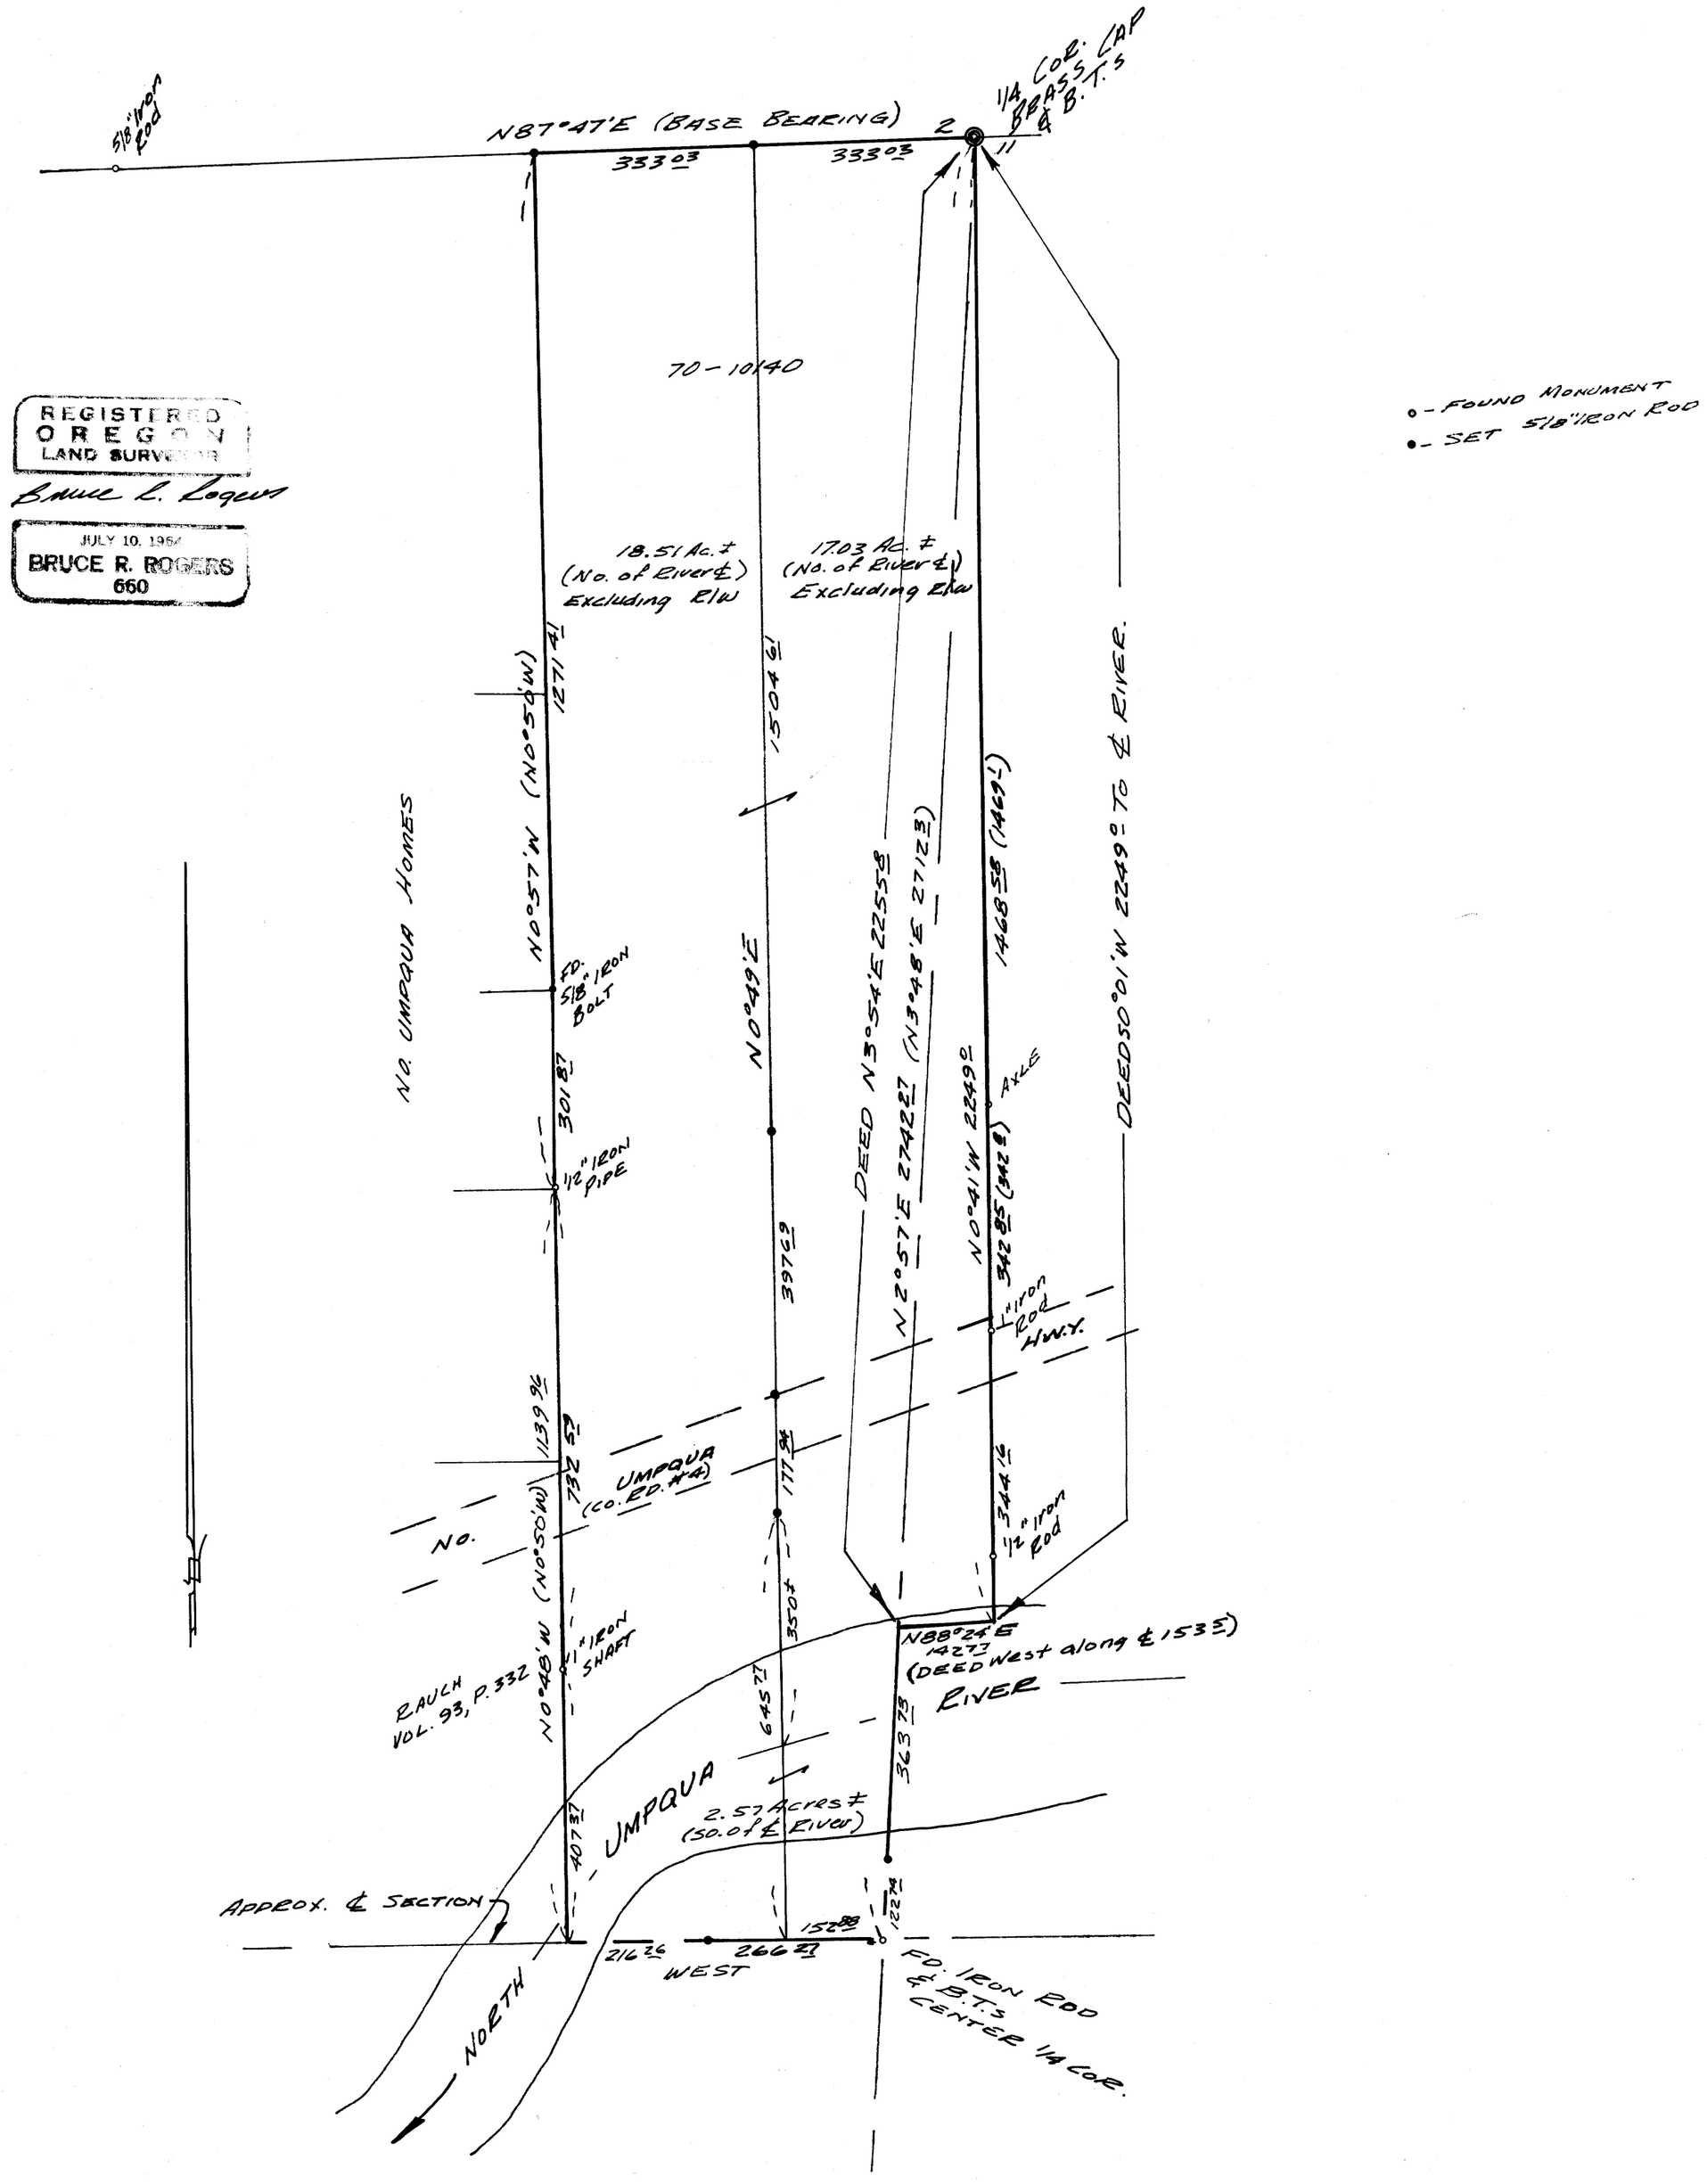

M 44 - 11