COUNTY SURVEYORS FILE DATA
DO NOT REMOVE FROM OFFICE

RECEIVED
DEC 14
COUNTY SURVEYOR
DOUGLAS COUNTY, OREGON

M 44-16

SURVEY IN D.L.C. NO. 52, SECTION 29 & 20, T27S, R7W, W.M.

SURVEYED FOR HAYWARD REED
SURVEYED BY DON E. GARRETT
OCTOBER, 1971 SCALE: 1"=200'

• — DENOTES FOUND 5/8" IRON ROD
○ — DENOTES SET 5/8" IRON ROD

REGISTERED
OREGON
LAND SURVEYOR
Don E. Garrett
JULY 14, 1961
DON E. GARRETT
544

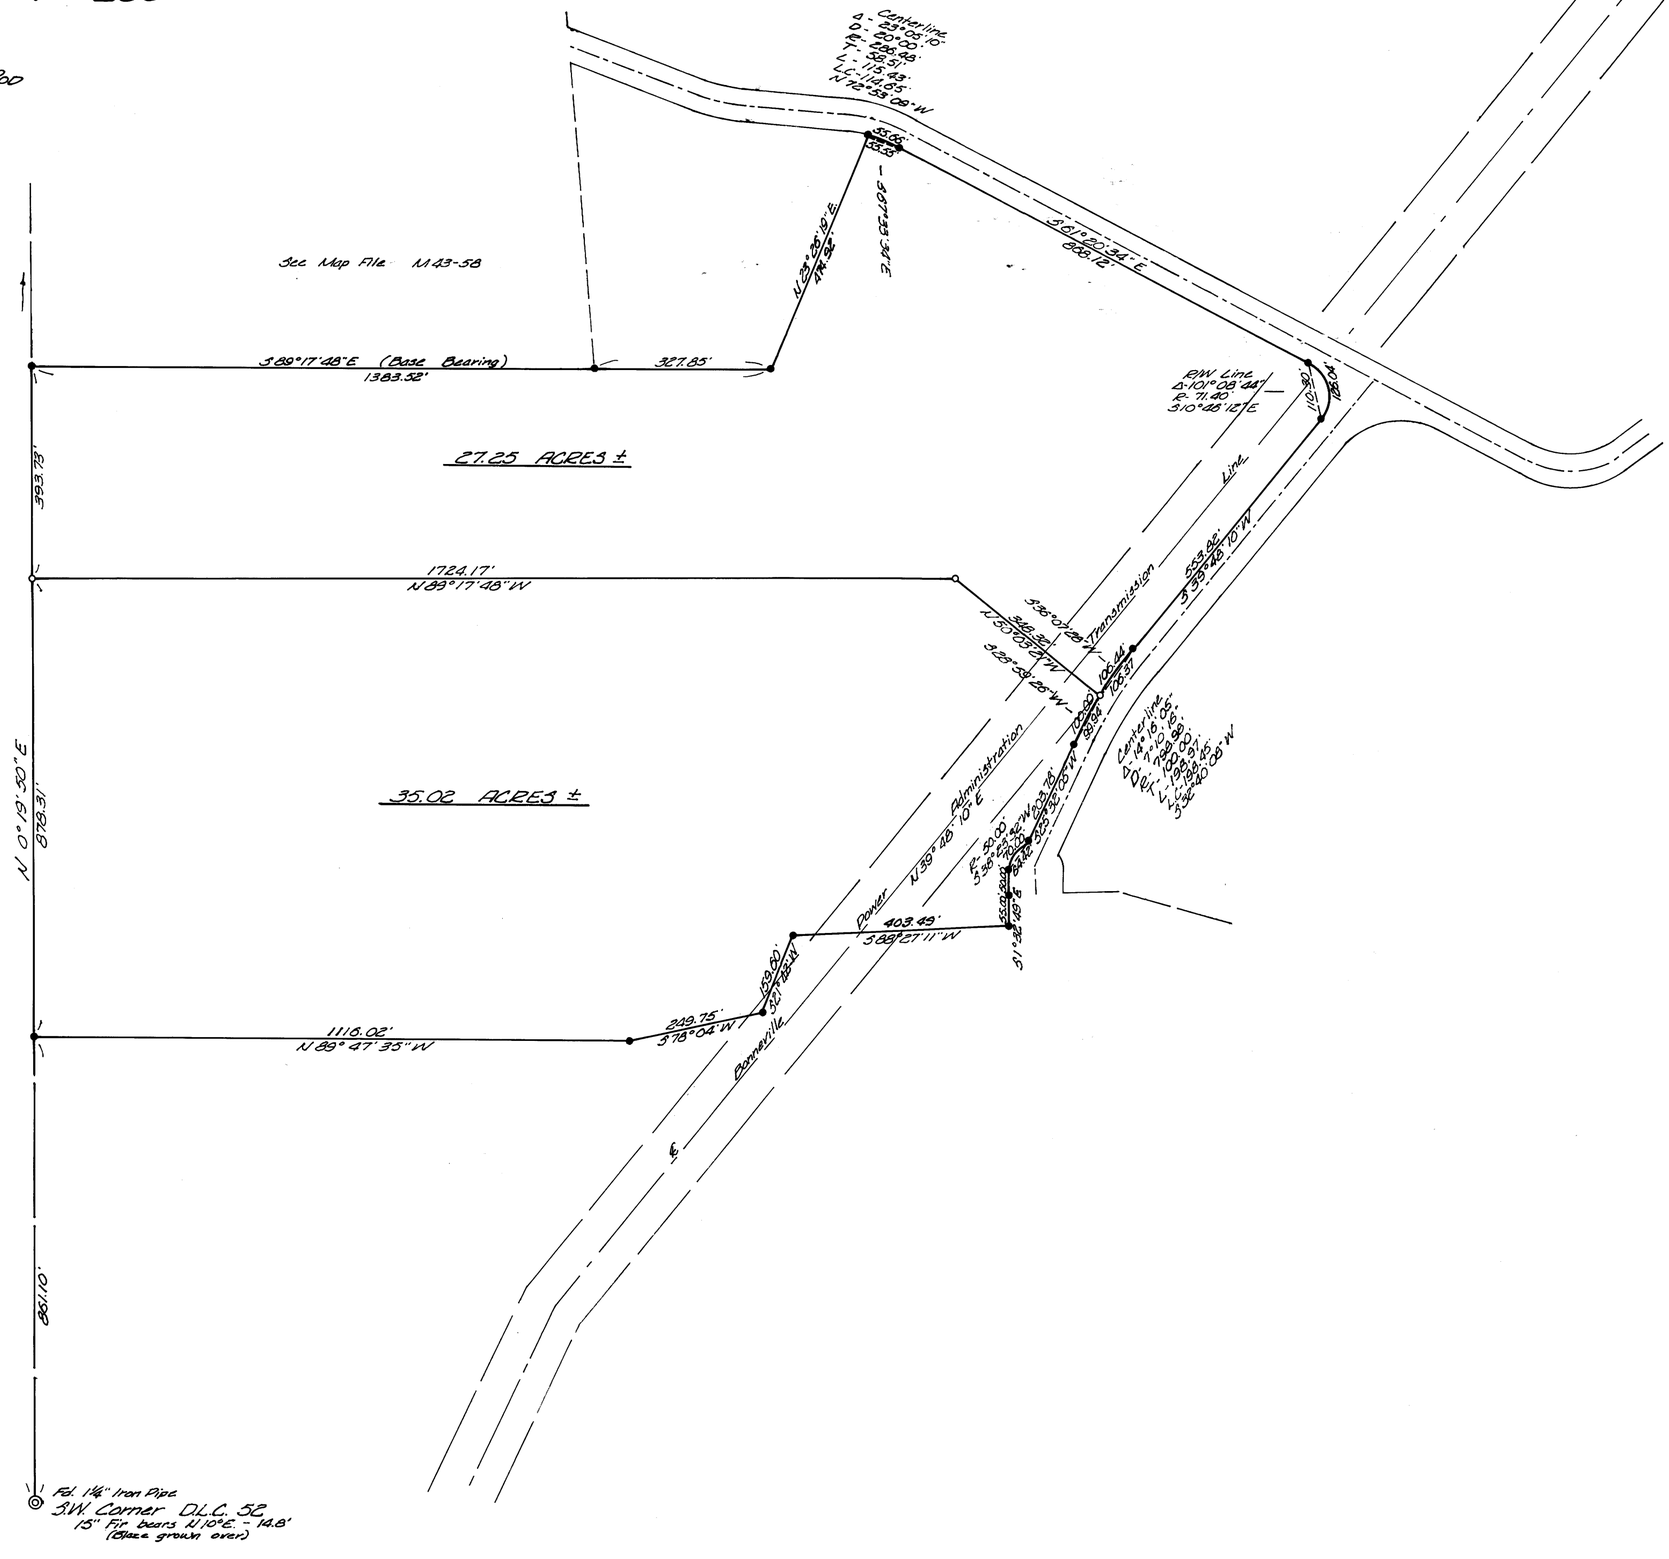

M 44-16