M 44 - 20

SURVEY IN SECTIONS 9 & 10, T29S, R6W, W.M., DOUGLAS COUNTY, ORE.

Surveyed for Willis Creek Properties Inc. by Victor M. McLind

December 1971

Scale: 1" = 200'

Bearings Based on Solar Observation April 1, 1971

● ~ Fd. 5/8" I. Rod
○ ~ Set 5/8" I. Rod

COUNTY SURVEYORS FILE DATA
DO NOT REMOVE FROM OFFICE

FILED
21 1971
COUNTY SURVEYOR
DOUGLAS COUNTY, ORE.

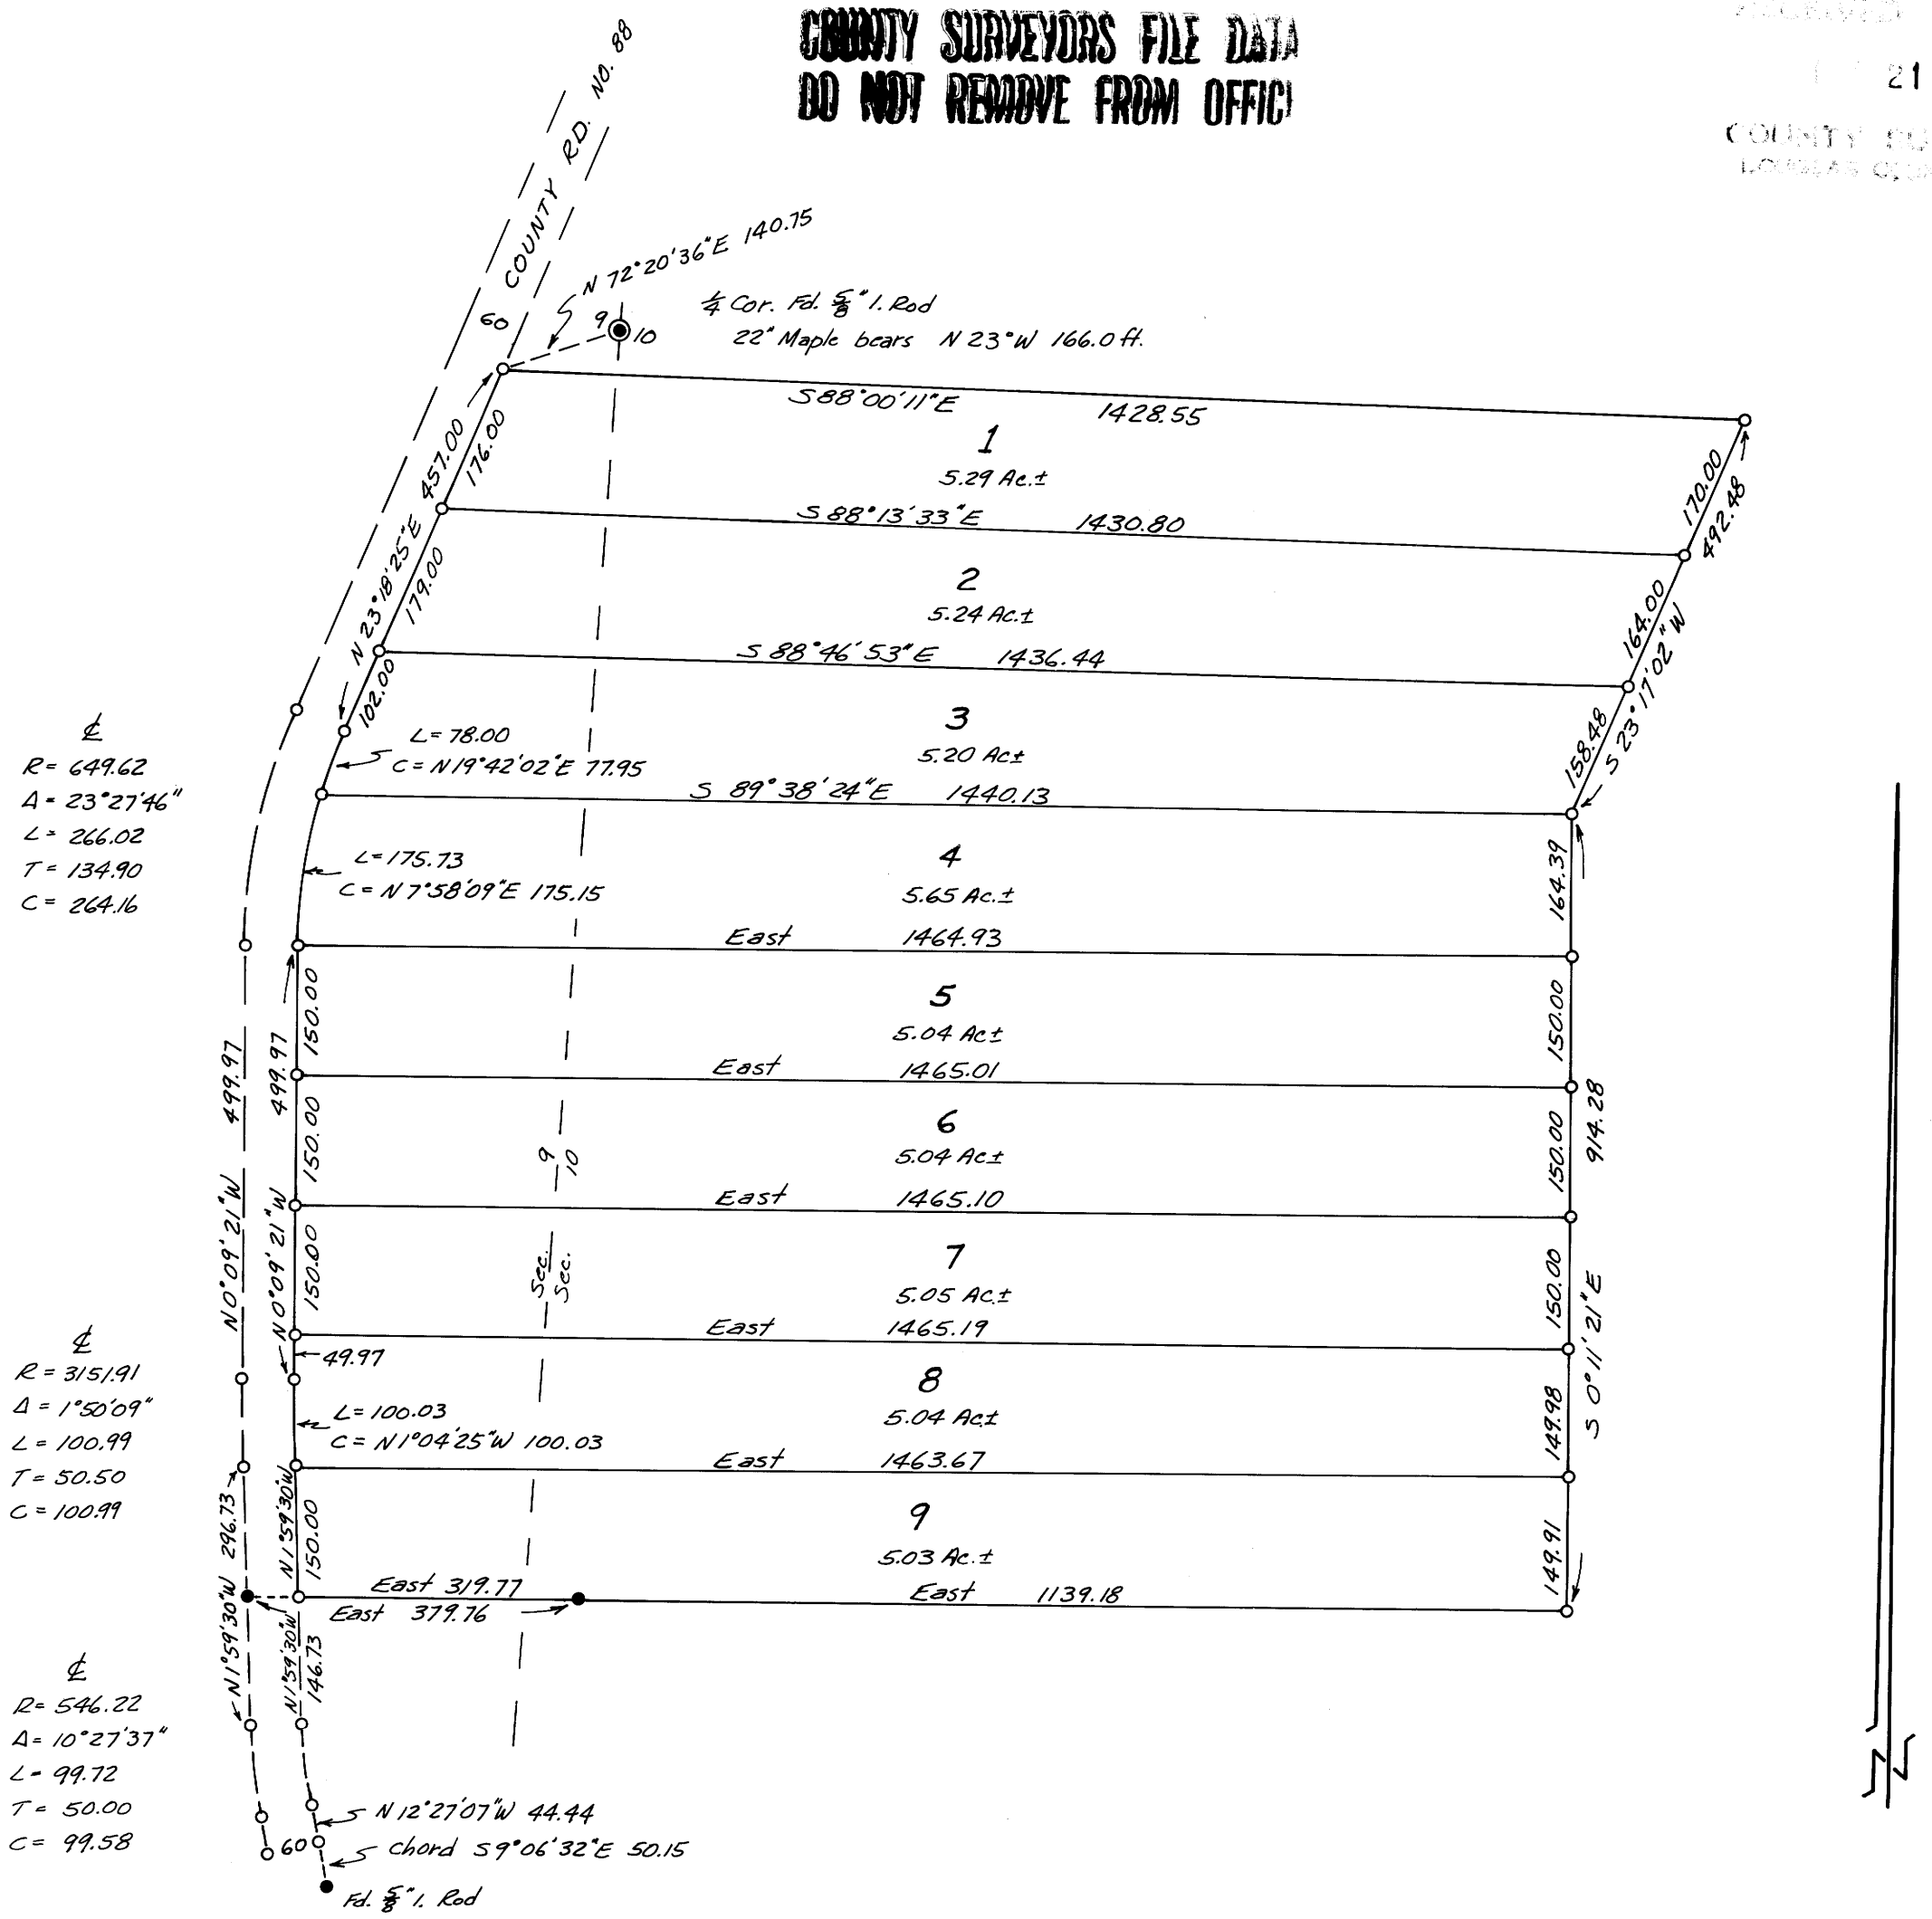

Victor M. McLind

M 44 - 20