SURVEY OF EXISTING ROAD
IN SECTION 5, T. 29 S., R 5 W.W.M.
SURVEYED FOR CHAS. HURD
by BRUCE ROGERS
JAN., 1972
1" = 200'

COUNTY SURVEYORS FILE DA
AND MUST ARCHIVE FROM OFFIC

FILED
RECEIVED
JAN 12 1972
COUNTY SURVEYOR
DOUGLAS COUNTY, ORE.

MAP FILE M 44-25

REGISTERED
OREGON
LAND SURVEYOR

Bruce R. Rogers

JULY 10, 1964
BRUCE R. ROGERS
660

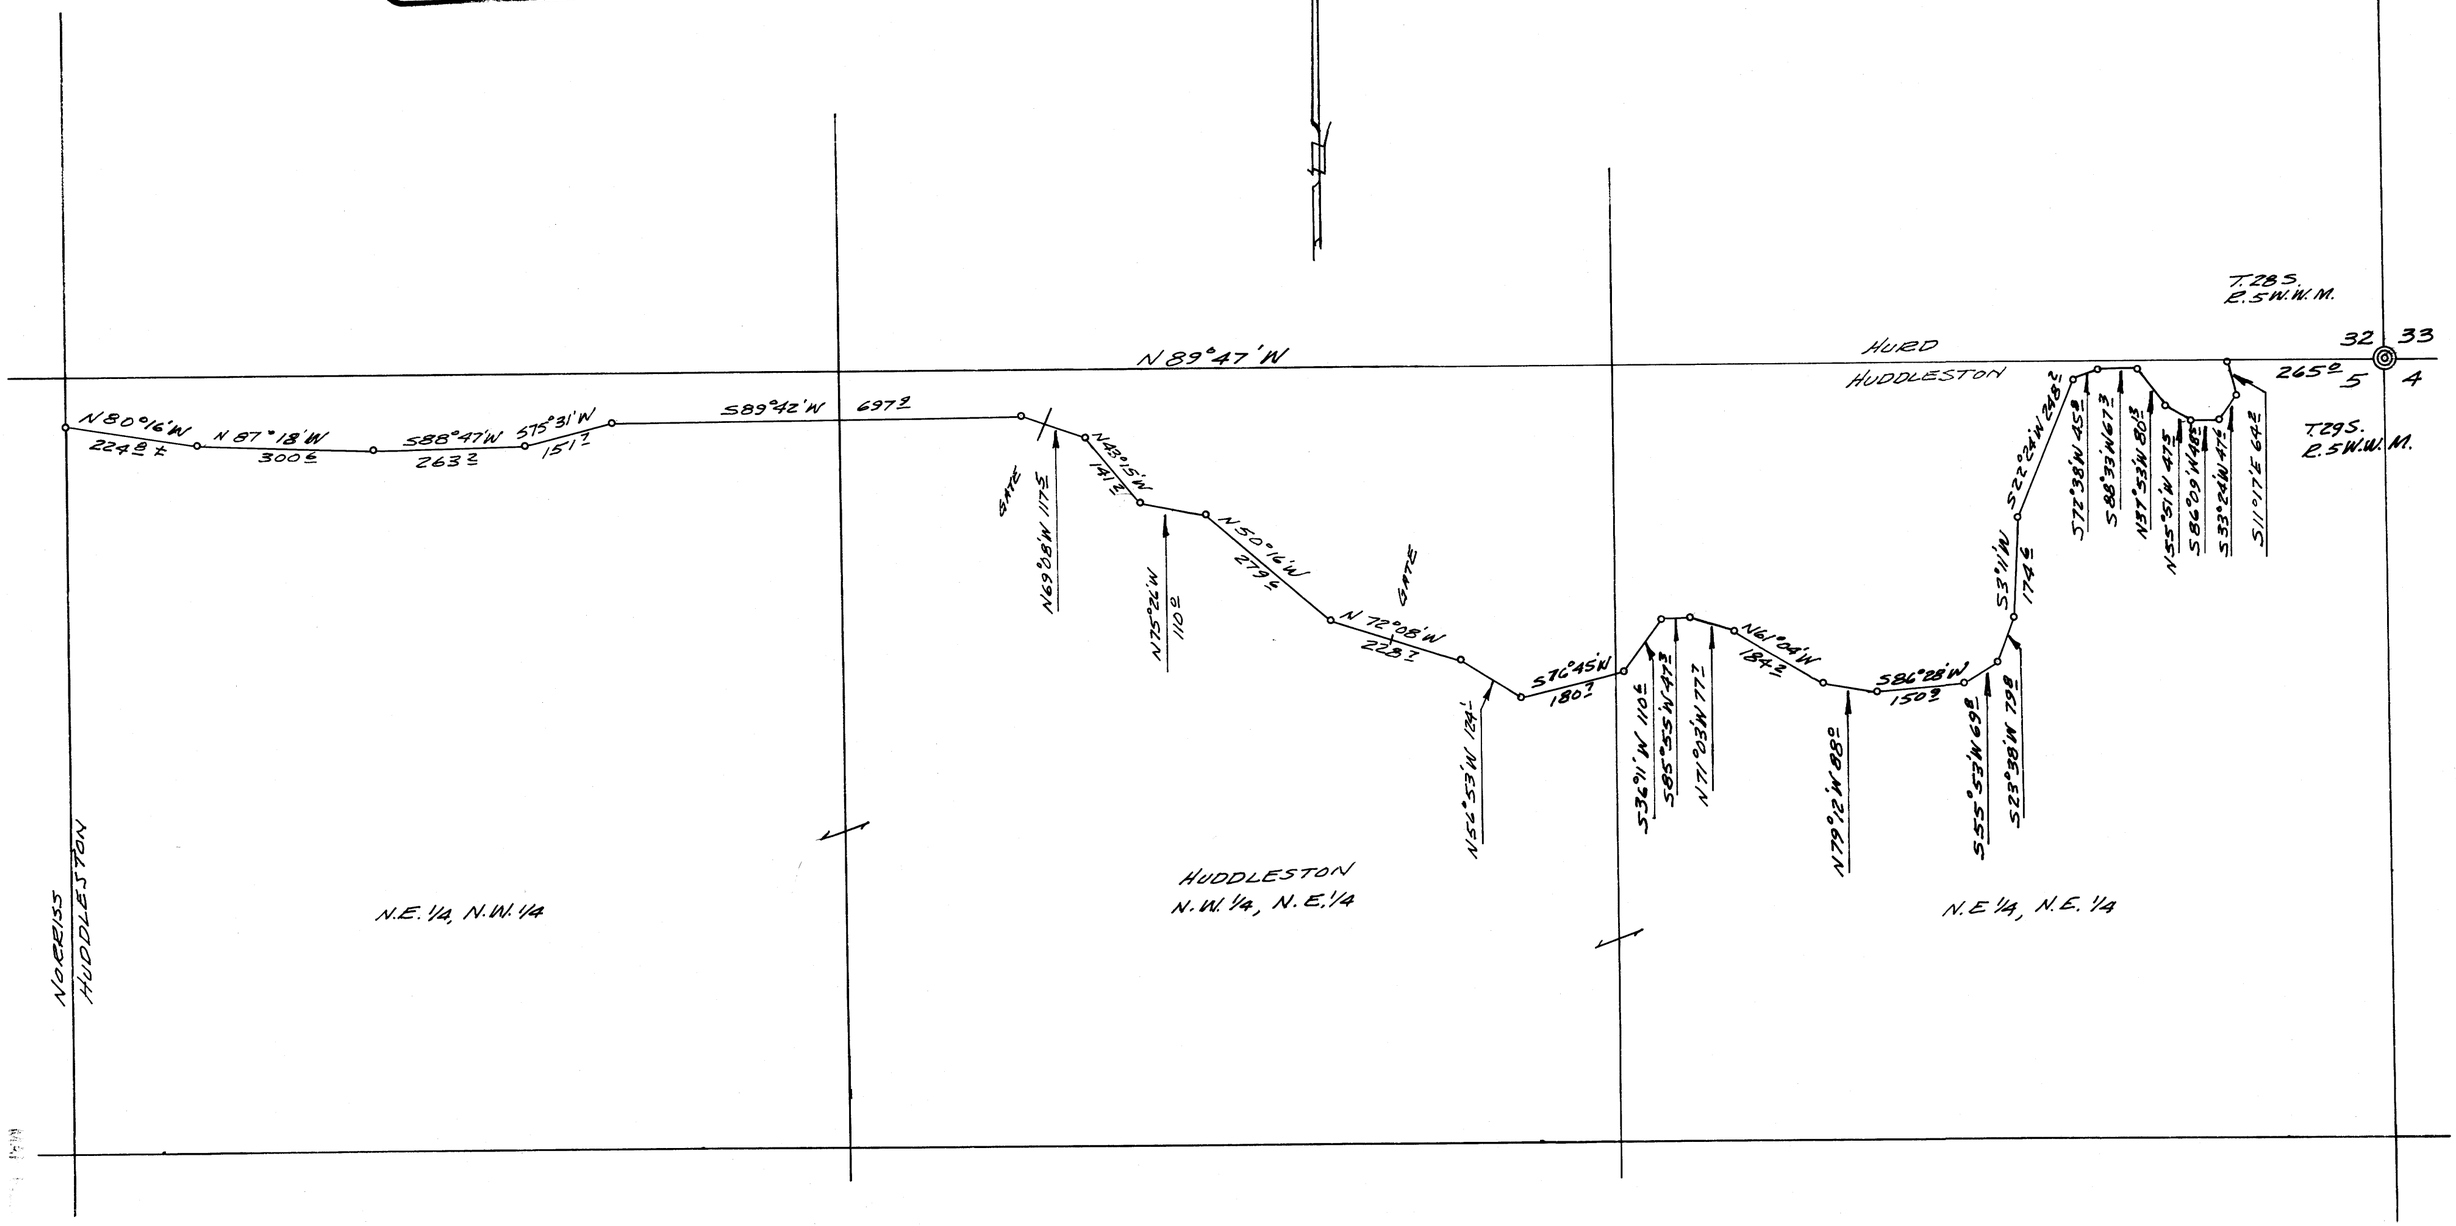

M 44-25