SURVEY IN N.W ¼ SEC. 29, T 25S, R 7W, W.M., DOUGLAS CO., ORE.

Surveyed for Ralph Peery by Victor M. McLind

JANUARY 1972

SCALE : 1" = 100'

○ Indicates Set ⅝" I. Rod
● Indicates fd. Road Monument unless otherwise noted.

COUNTY SURVEYORS FILE DATA
DO NOT REMOVE FROM OFFICE

COUNTY SURVEYOR
DOUGLAS COUNTY, ORE.

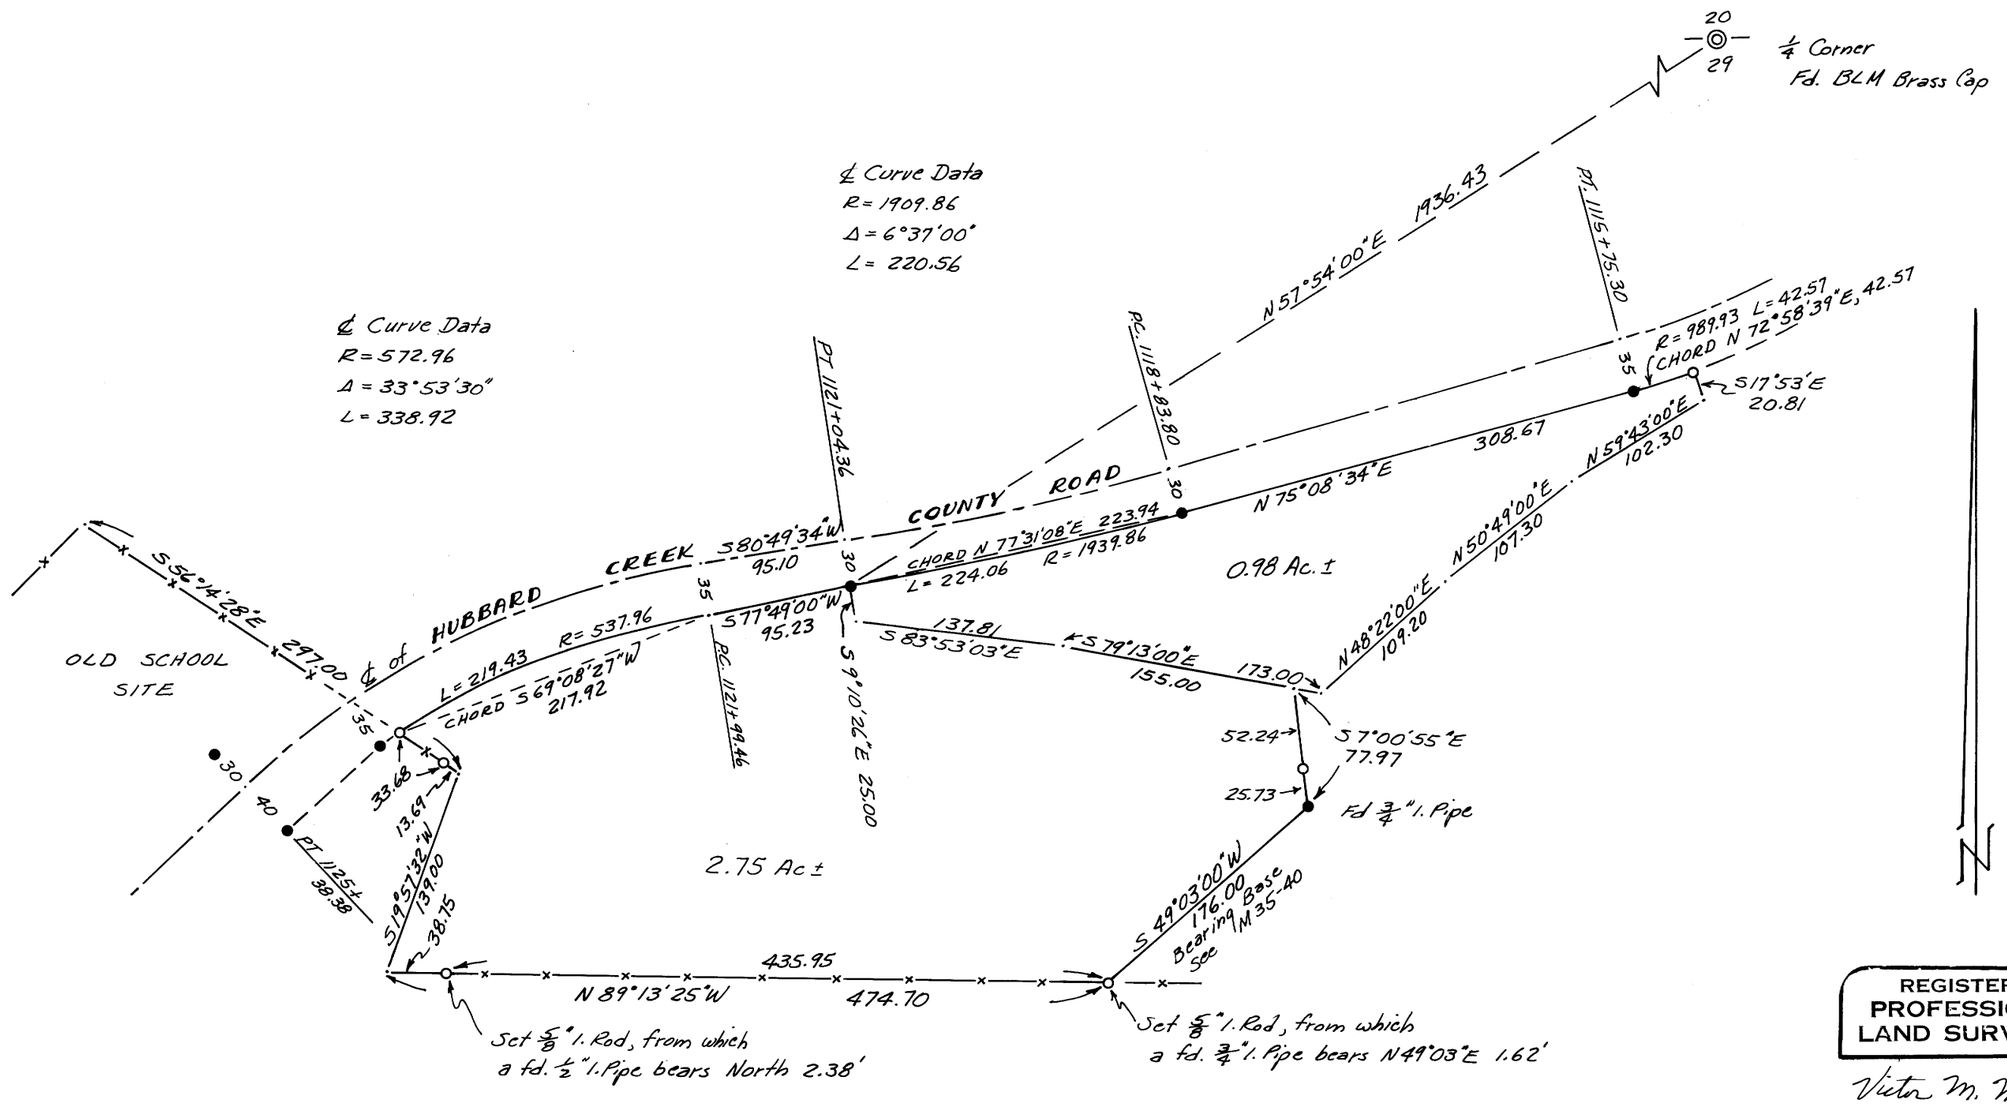

REGISTERED
PROFESSIONAL
LAND SURVEYOR

Victor M. McLind

OREGON
JULY 17, 1970
VICTOR M. McLIND
934

MAP M44-26

M44-26