SURVEY IN SECTIONS 17 & 18, T29S, R5W, W.M., DOUGLAS CO., ORE.

Surveyed for Frances Svedbeck by Victor M. McLind

JANUARY 1972

Bearings Based on Solar Observation taken January 4, 1972

o ~ Set 5/8" I. Rod

SCALE : 1" = 400'

COUNTY SURVEYORS FILE DATA
DO NOT REMOVE FROM OFFICE

REGISTERED PROFESSIONAL LAND SURVEYOR
Victor McLind
SIGNATURE
VICTOR M. McLIND
934

COUNTY SURVEYOR
DOUGLAS COUNTY, OREGON

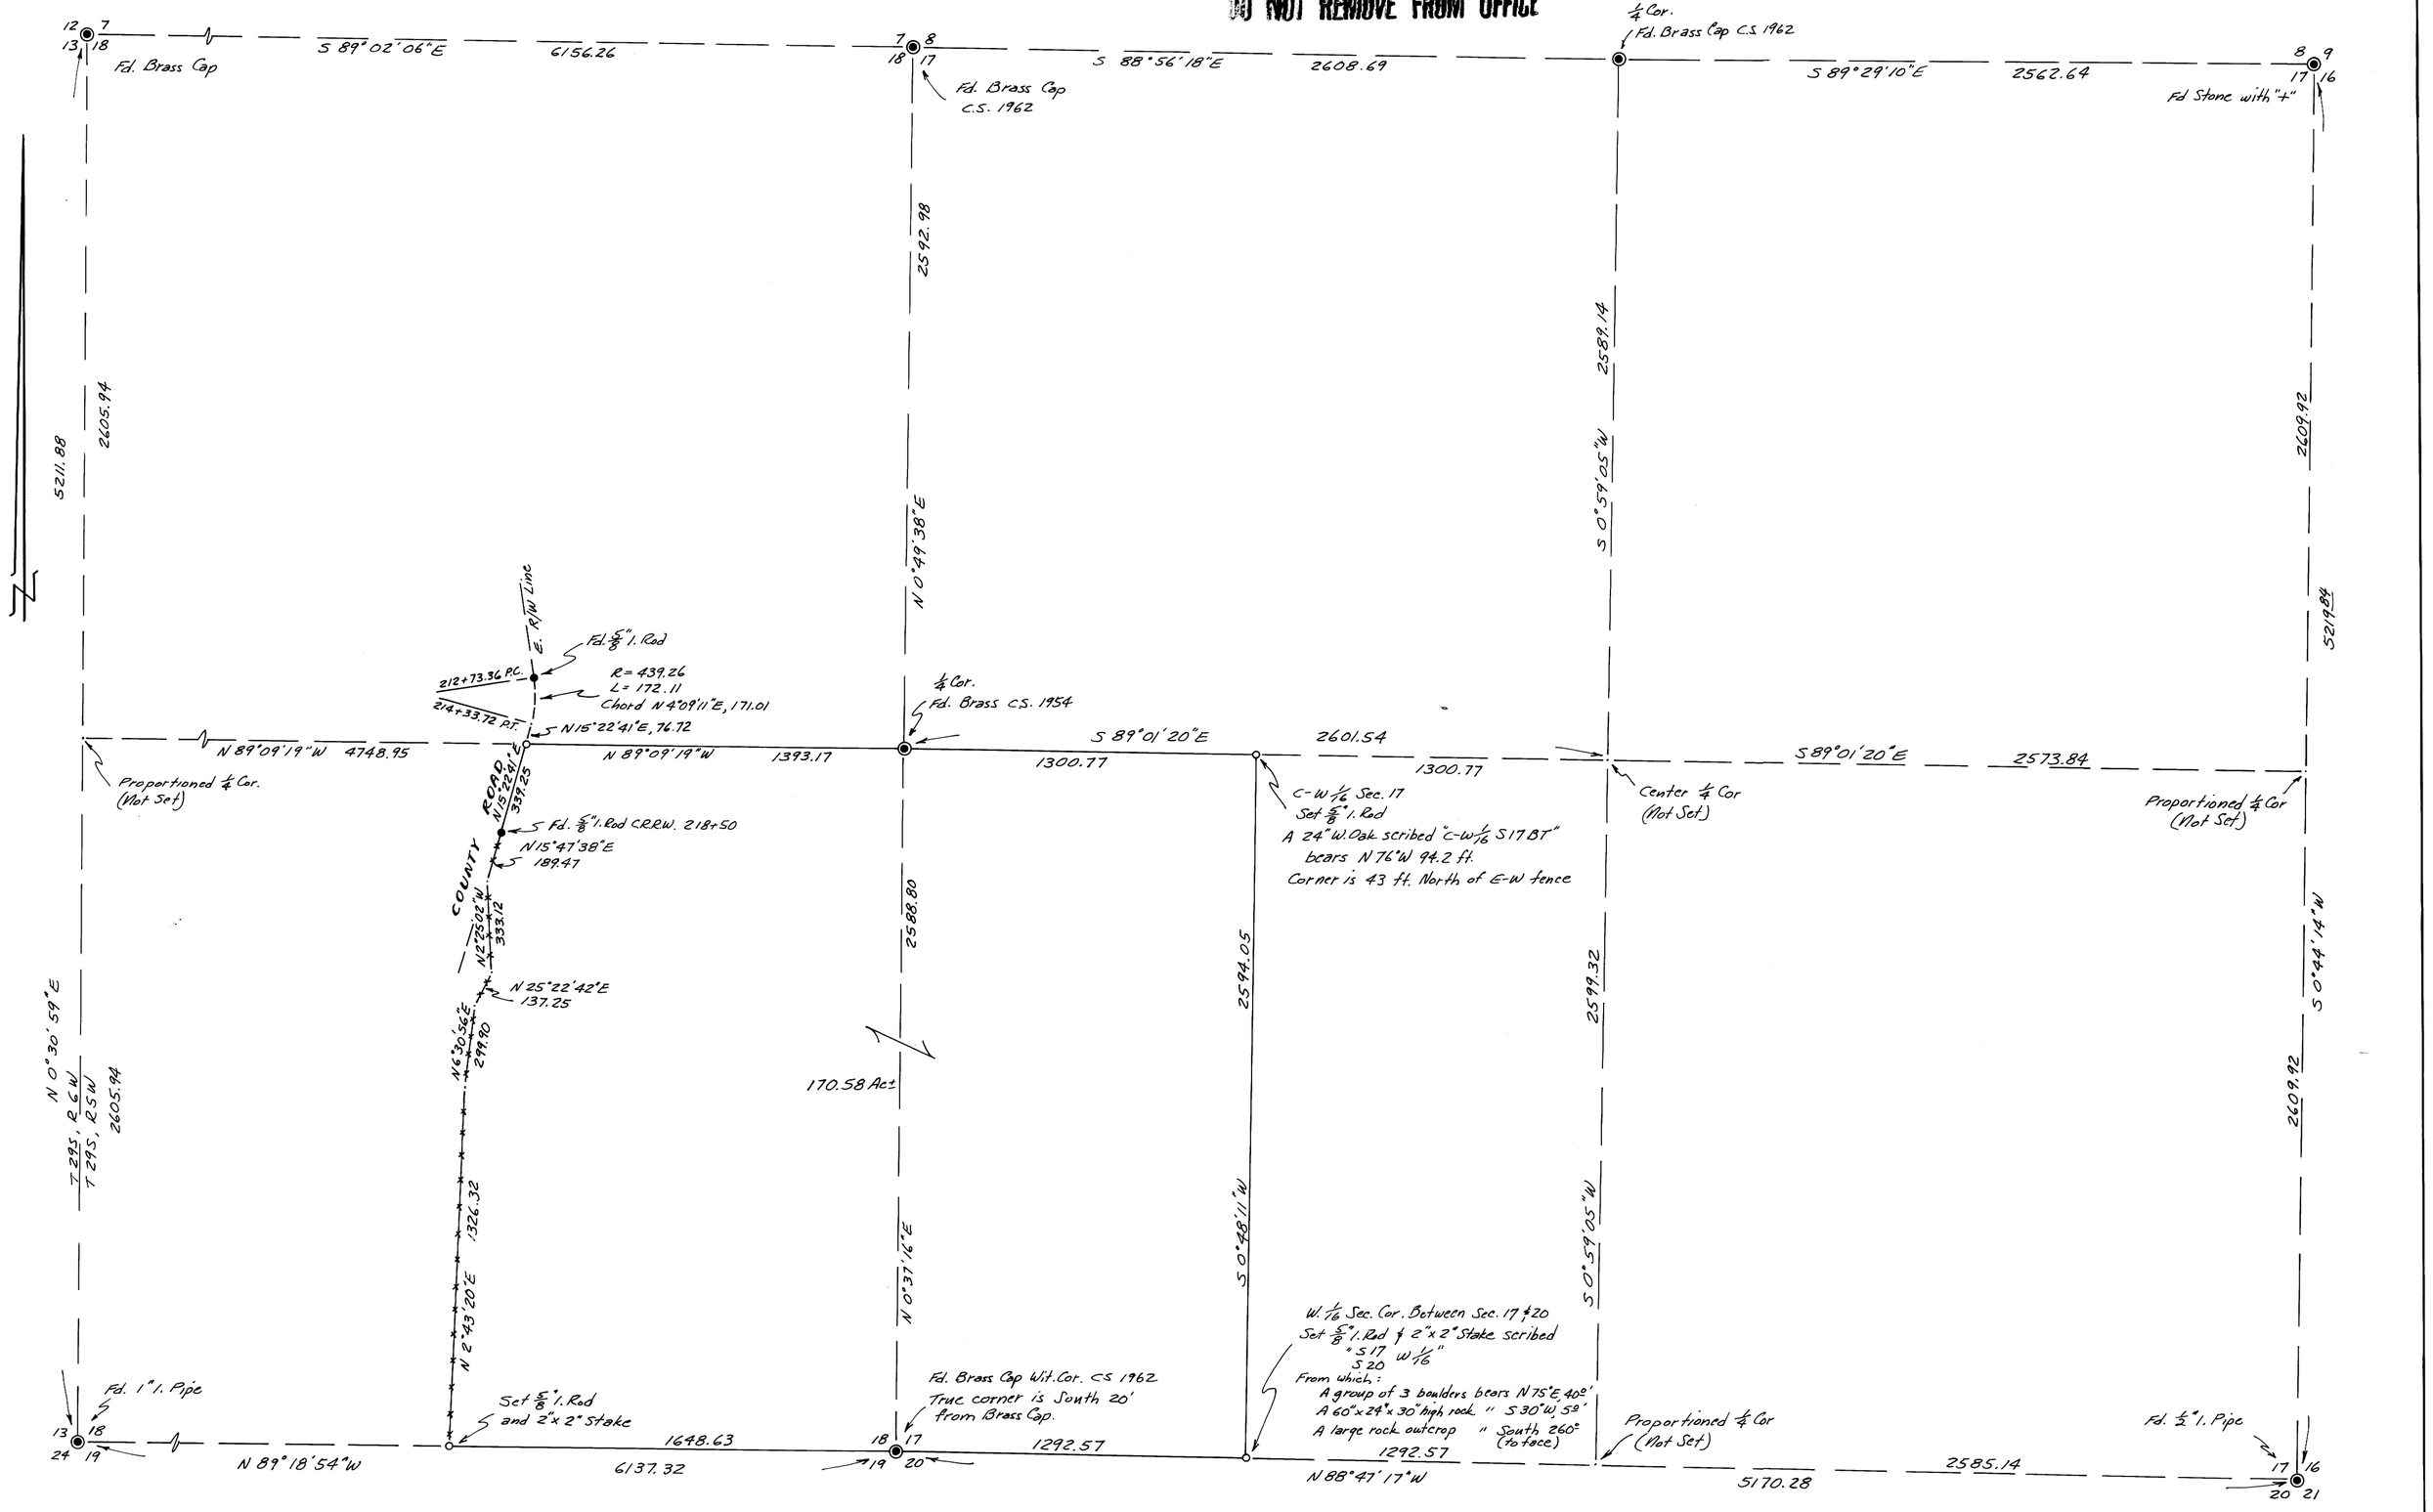

M44-28

M44-28