MAP FILE M 44-3

COUNTY SURVEYORS FILE DATA
DO NOT REMOVE FROM OFFICE

FILED
RECEIVED
NOV 22 1971
COUNTY SURVEYOR
DOUGLAS COUNTY, ORE.

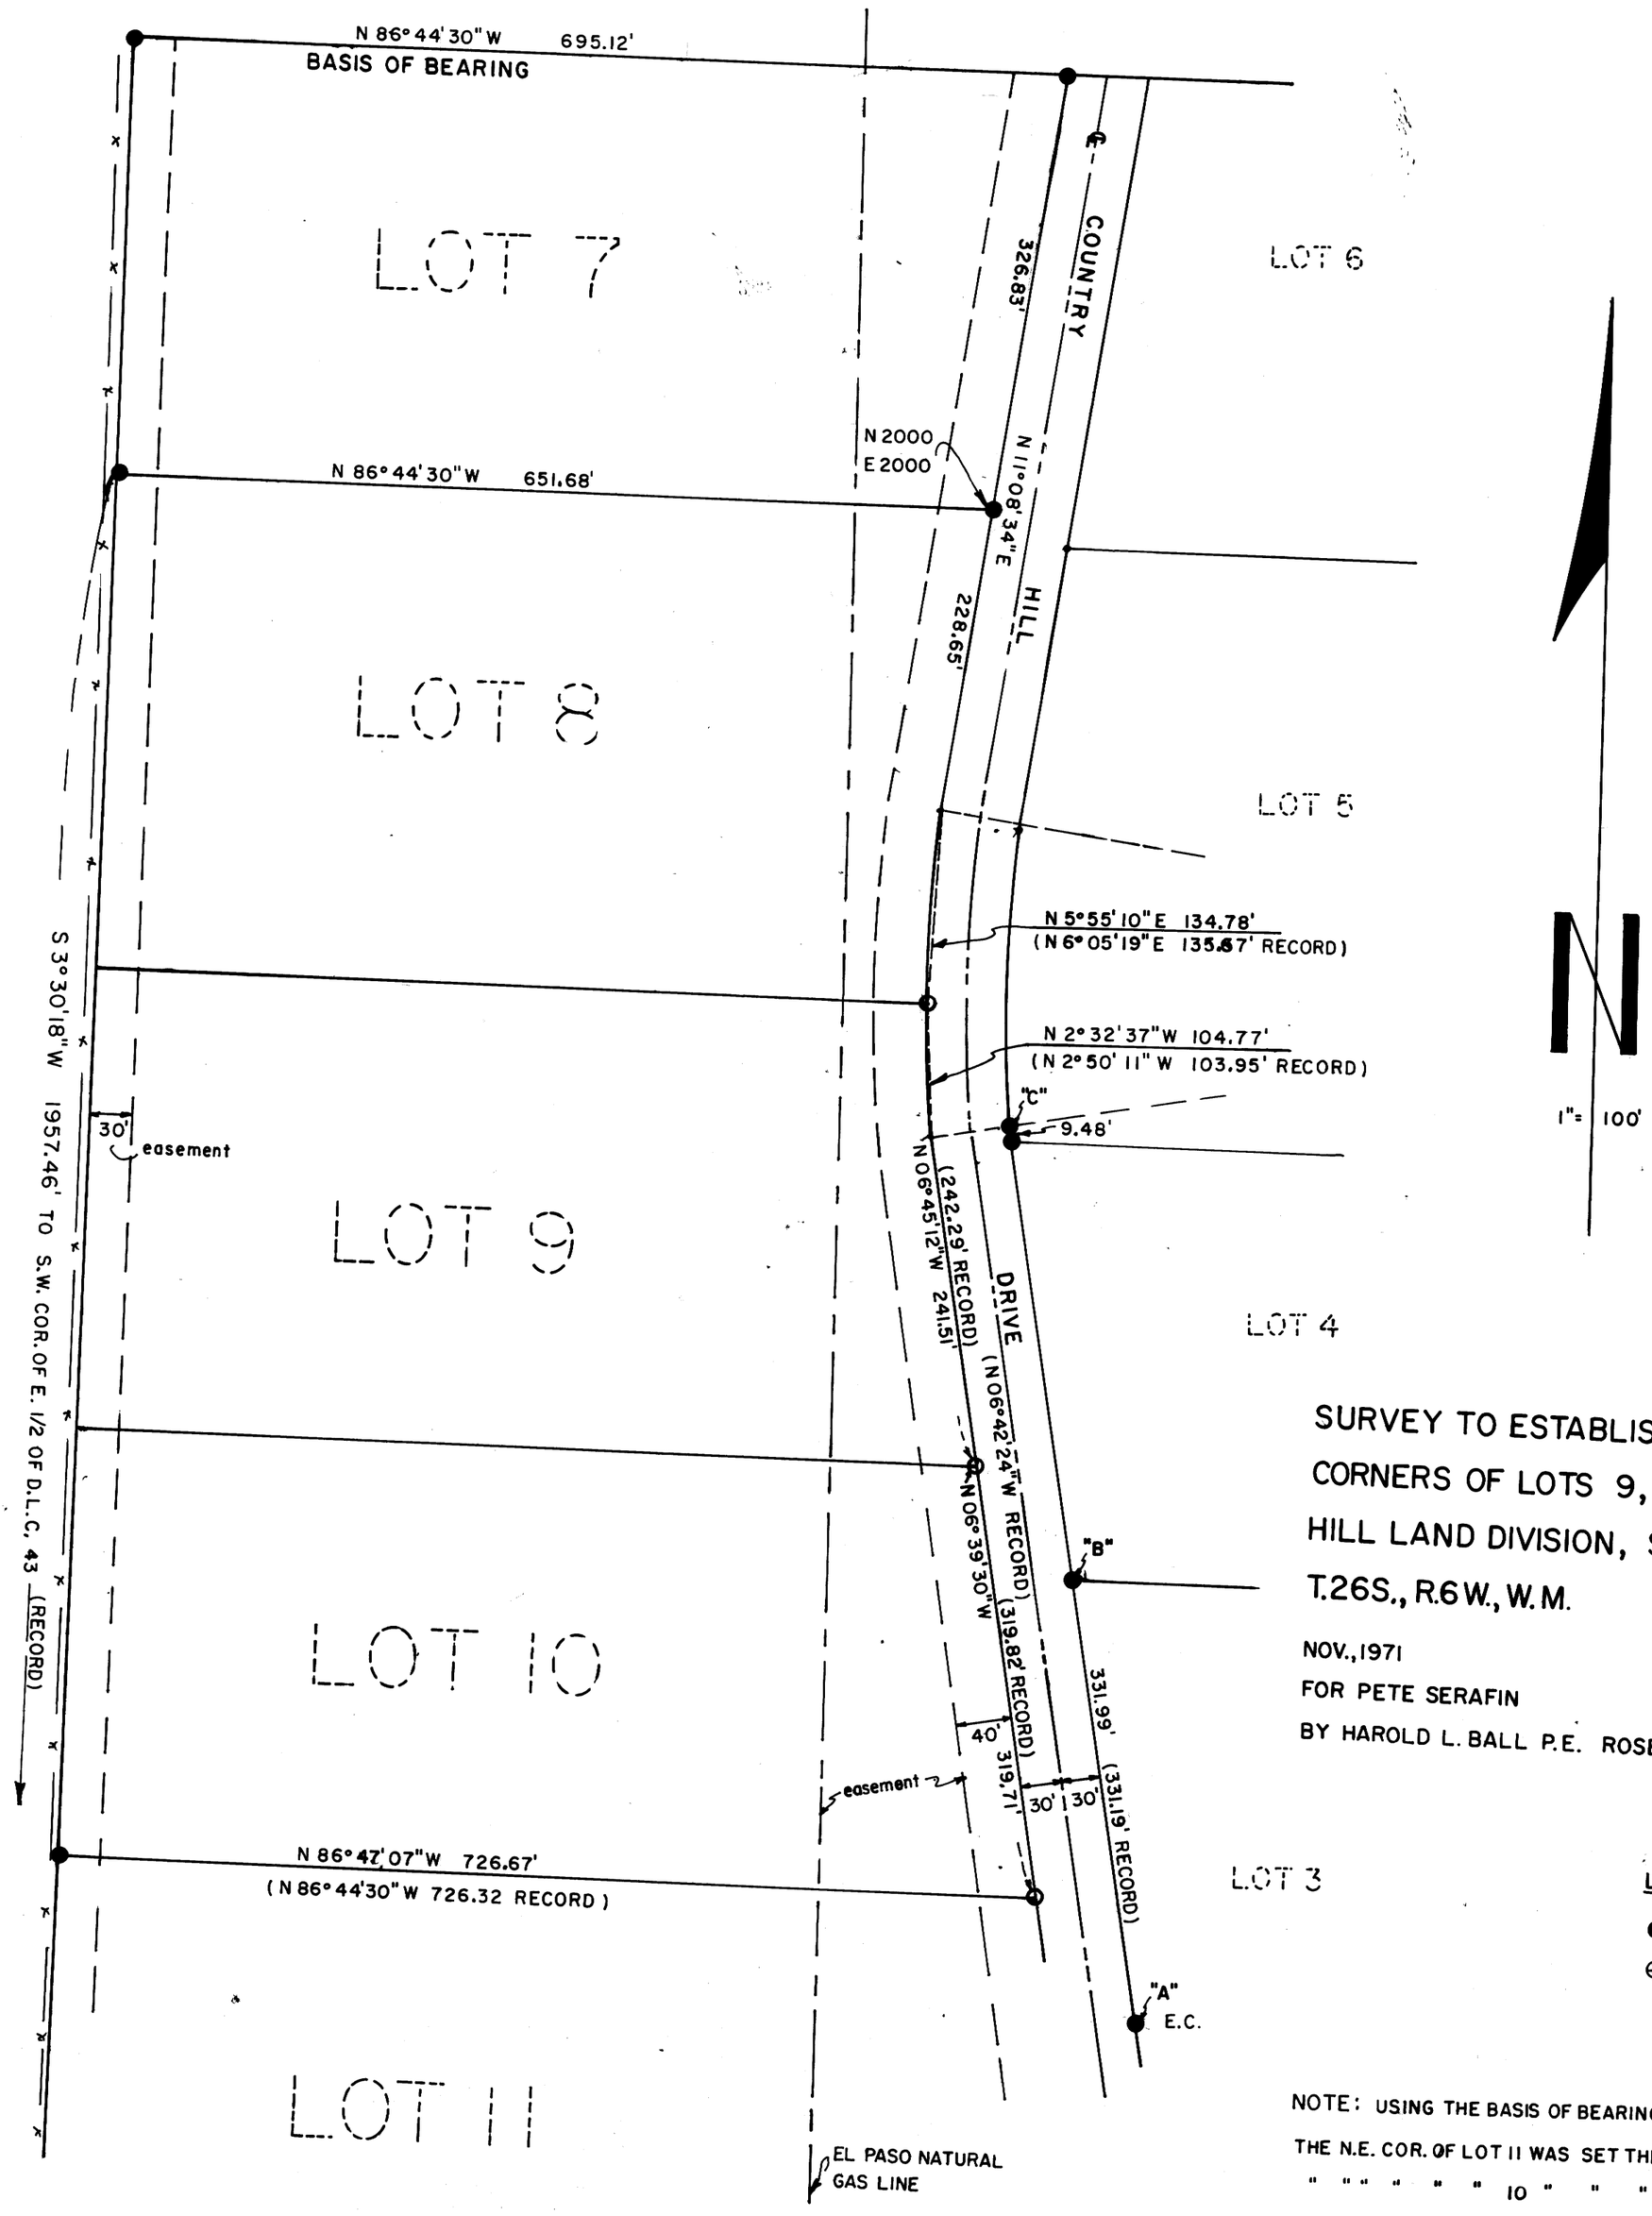

SURVEY TO ESTABLISH THE NORTHEAST CORNERS OF LOTS 9, 10 & 11 OF COUNTRY HILL LAND DIVISION, SECTIONS 22 & 27, T.26S., R.6W., W.M.

NOV., 1971
FOR PETE SERAFIN
BY HAROLD L. BALL P.E. ROSEBURG, OREGON

LEGEND

● — 5/8" REINFORCING BAR FD.
⊕ — " " " " SET

NOTE: USING THE BASIS OF BEARING SHOWN —
THE N.E. COR. OF LOT 11 WAS SET THE RECORD BEARING & DISTANCE FROM "A"
" " " " " " 10 " " " " " " " " "B"
" " " " " " 9 " " " " " " " " "C"

"A"—	882.93'N 2083.88E
"B"—	1212.65N 2045.30E
"C"—	1544.80N 2006.64E

REGISTERED PROFESSIONAL ENGINEER 6025 OREGON SEPT. 8, 1967 HAROLD L. BALL

MAP FILE M 44 - 3