CONTROL SURVEY FOR WINSTON — DILLARD AREA

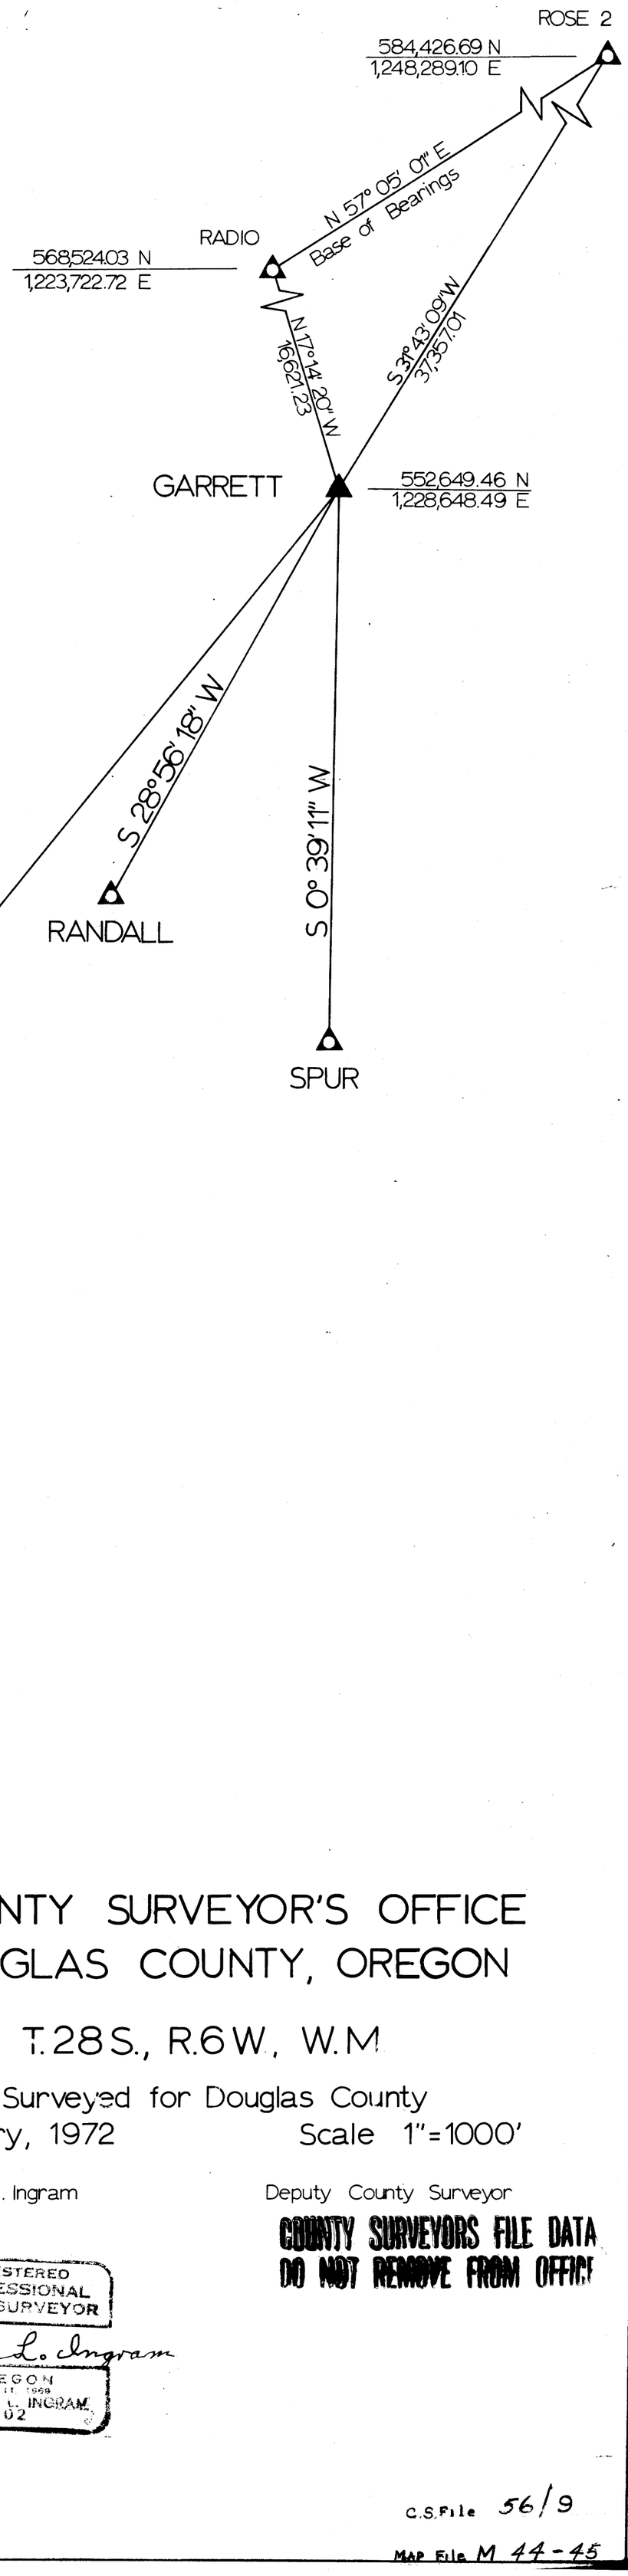

All data shown based upon
the Oregon State Plane Coordinate System,
South Zone

▲— Set Brass Cap in Concrete Monument
▲— Found Brass Cap

COUNTY SURVEYOR'S OFFICE
DOUGLAS COUNTY, OREGON

T. 28 S., R. 6 W., W.M

Surveyed for Douglas County
January, 1972 Scale 1"=1000'

Francis L. Ingram Deputy County Surveyor

REGISTERED PROFESSIONAL LAND SURVEYOR
Francis L. Ingram
OREGON JULY 11, 1969 FRANCIS L. INGRAM 902

COUNTY SURVEYORS FILE DATA
DO NOT REMOVE FROM OFFICE

C.S. File 56/9

MAP File M 44-45