MAP FILE M 44 - 5

COUNTY SURVEYORS FILE
DO NOT REMOVE FROM OFFICE

SURVEY TO LOCATE BOUNDARIES OF PARCEL IN N. ½ OF SEC. 34, T. 30S., R. 3 W., W.M., A/C DEED VOL. 465 INST# 71-5286 & METES & BOUNDS DESCRIPTIONS, AT MILO, DOUGLAS COUNTY, OREGON

NOV. 1971
SCALE 1" = 100'

FOR FRANK STRINGER

BY HERBERT L. NORTHCRAFT

FILED
RECEIVED
NOV 30 1971
COUNTY SURVEYOR
DOUGLAS COUNTY, ORE.

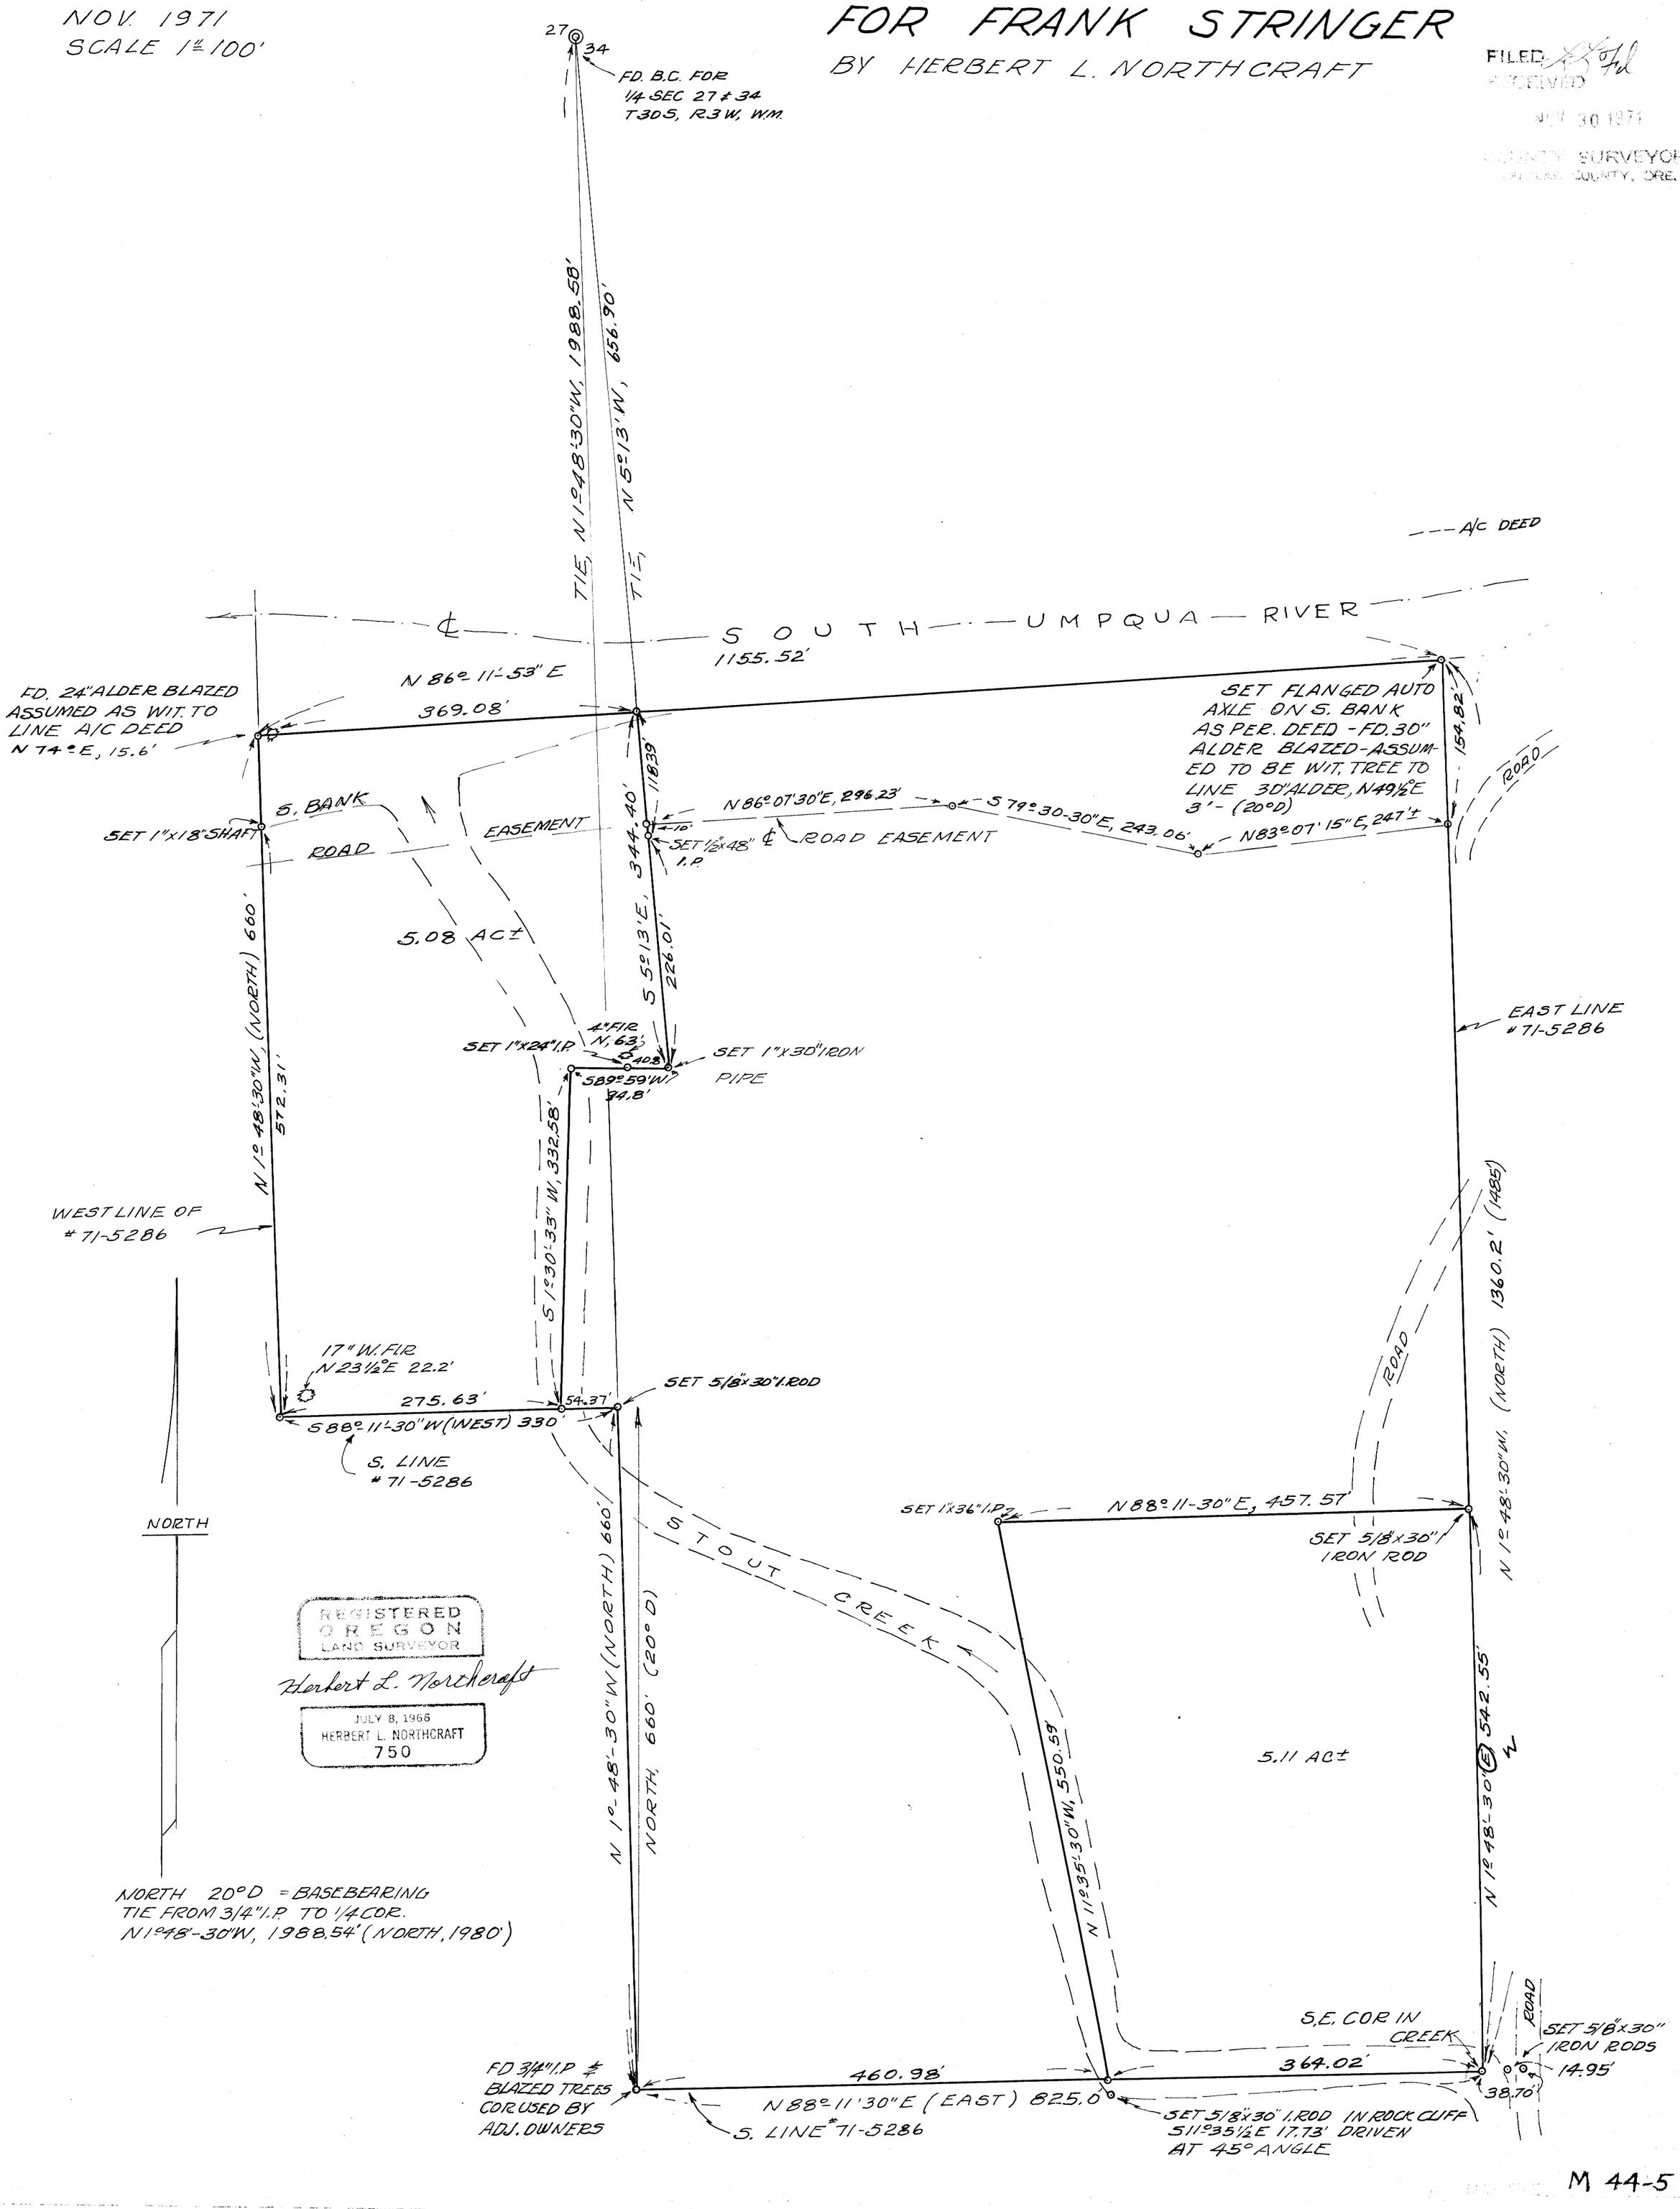

REGISTERED
OREGON
LAND SURVEYOR

Herbert L. Northcraft

JULY 8, 1966
HERBERT L. NORTHCRAFT
750

NORTH 20° D = BASEBEARING
TIE FROM 3/4" I.P TO 1/4 COR.
N 1° 48'-30" W, 1988.54' (NORTH, 1980')

M 44-5