59-44 W

A SURVEY OF A PARCEL OF LAND IN THE SE 1/4 OF SEC. 16 & THE NE 1/4 OF SEC. 21, T. 32 S, R. 5 W, DOUGLAS CO., ORE.

COUNTY SURVEYORS FILE COPY
DO NOT REMOVE FROM OFFICE

FILED
RECEIVED
APR 21 1972
COUNTY SURVEYOR
DOUGLAS COUNTY, ORE.

FOR: CHARLES VAN VLAKE
BOX 61, OLD HIGHWAY 99,
GLENDALE, ORE.

BY: GERALD D. RILEY, R.S. 705
214 NW 6th. ST.
GRANTS PASS, ORE.

D'W'N: B.J.T.

DATE: MARCH 22, 1972.

SCALE: 1" = 200'

N

NOTES:
• = DENOTES 5/8" I. ROD SET THIS SURVEY.
o = DENOTES MONUMENTS FOUND.
BEARING REFERENCED TO BEARINGS OF MY SURVEY IN THE NW 1/4 OF SEC. 22

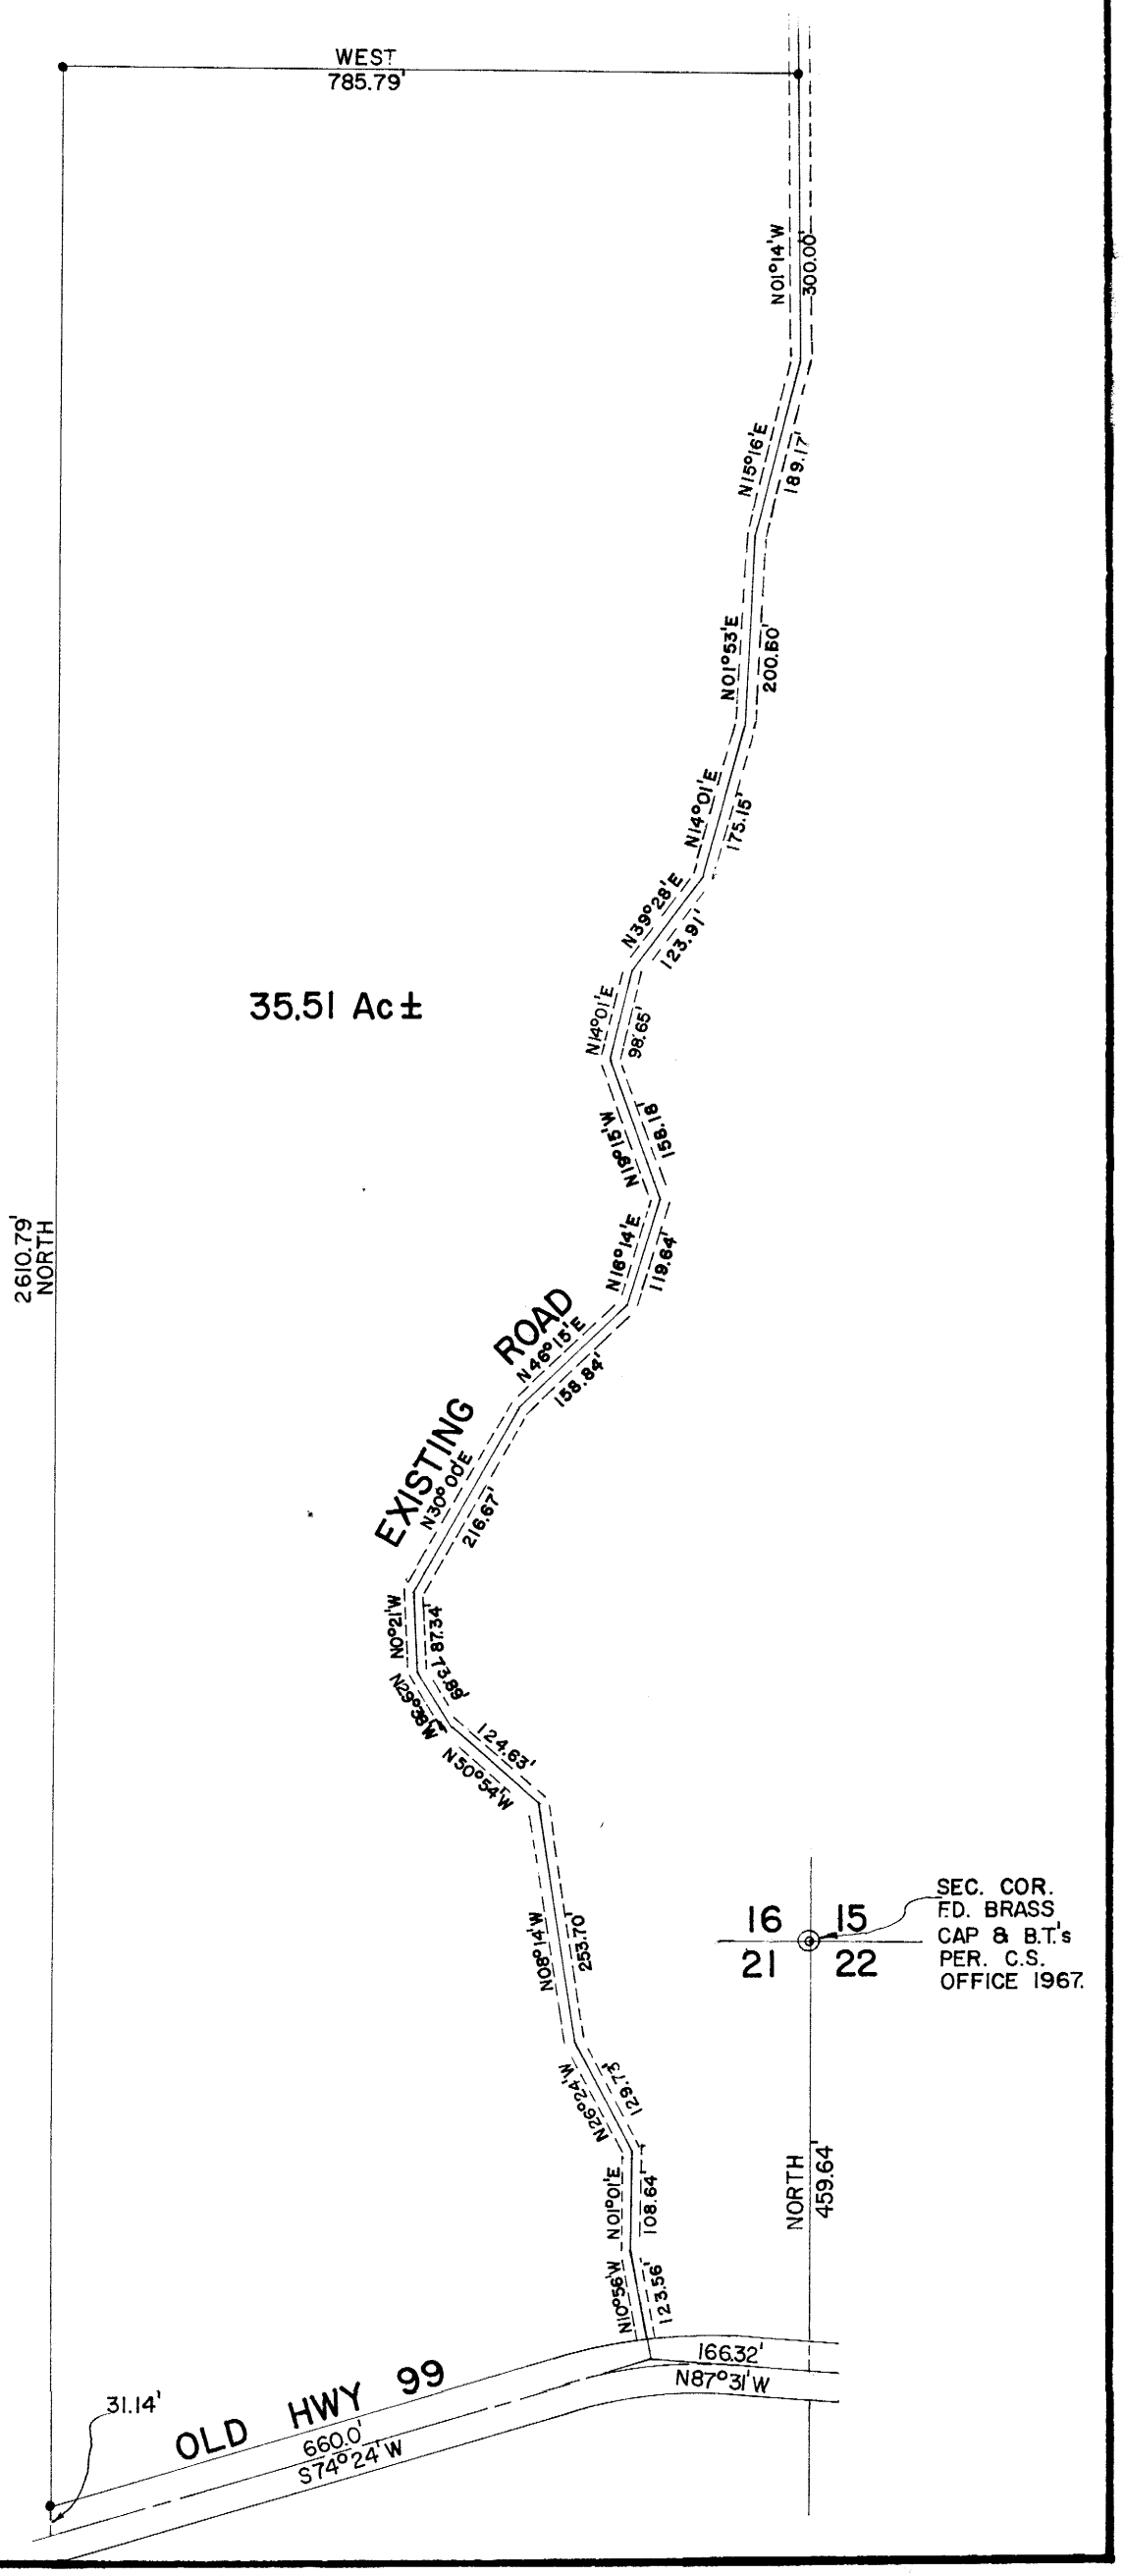

REGISTERED
PROFESSIONAL
LAND SURVEYOR
Gerald D. Riley
OREGON
JULY 1, 1966
GERALD D. RILEY
705

MAP FILE M 44 - 65