COUNTY SURVEYORS FILE DATA
DO NOT REMOVE FROM OFFICE

FILED
RECEIVED
APR 28 1972
COUNTY SURVEYOR
DOUGLAS COUNTY, ORE.

MAP FILE M44-72

SURVEY IN SEC. 12, TOWNSHIP 27 SOUTH, RANGE 5 WEST, WILLAMETTE MERIDIAN

Surveyed for Pete Serafin Realty by Don E. Garrett

April 1972

Scale 1" = 200'

o – Set 5/8" I. Rod
● – Fd. 5/8" I. Rod
NOTE: For Subdivision of Sec. 12 See M41-7.

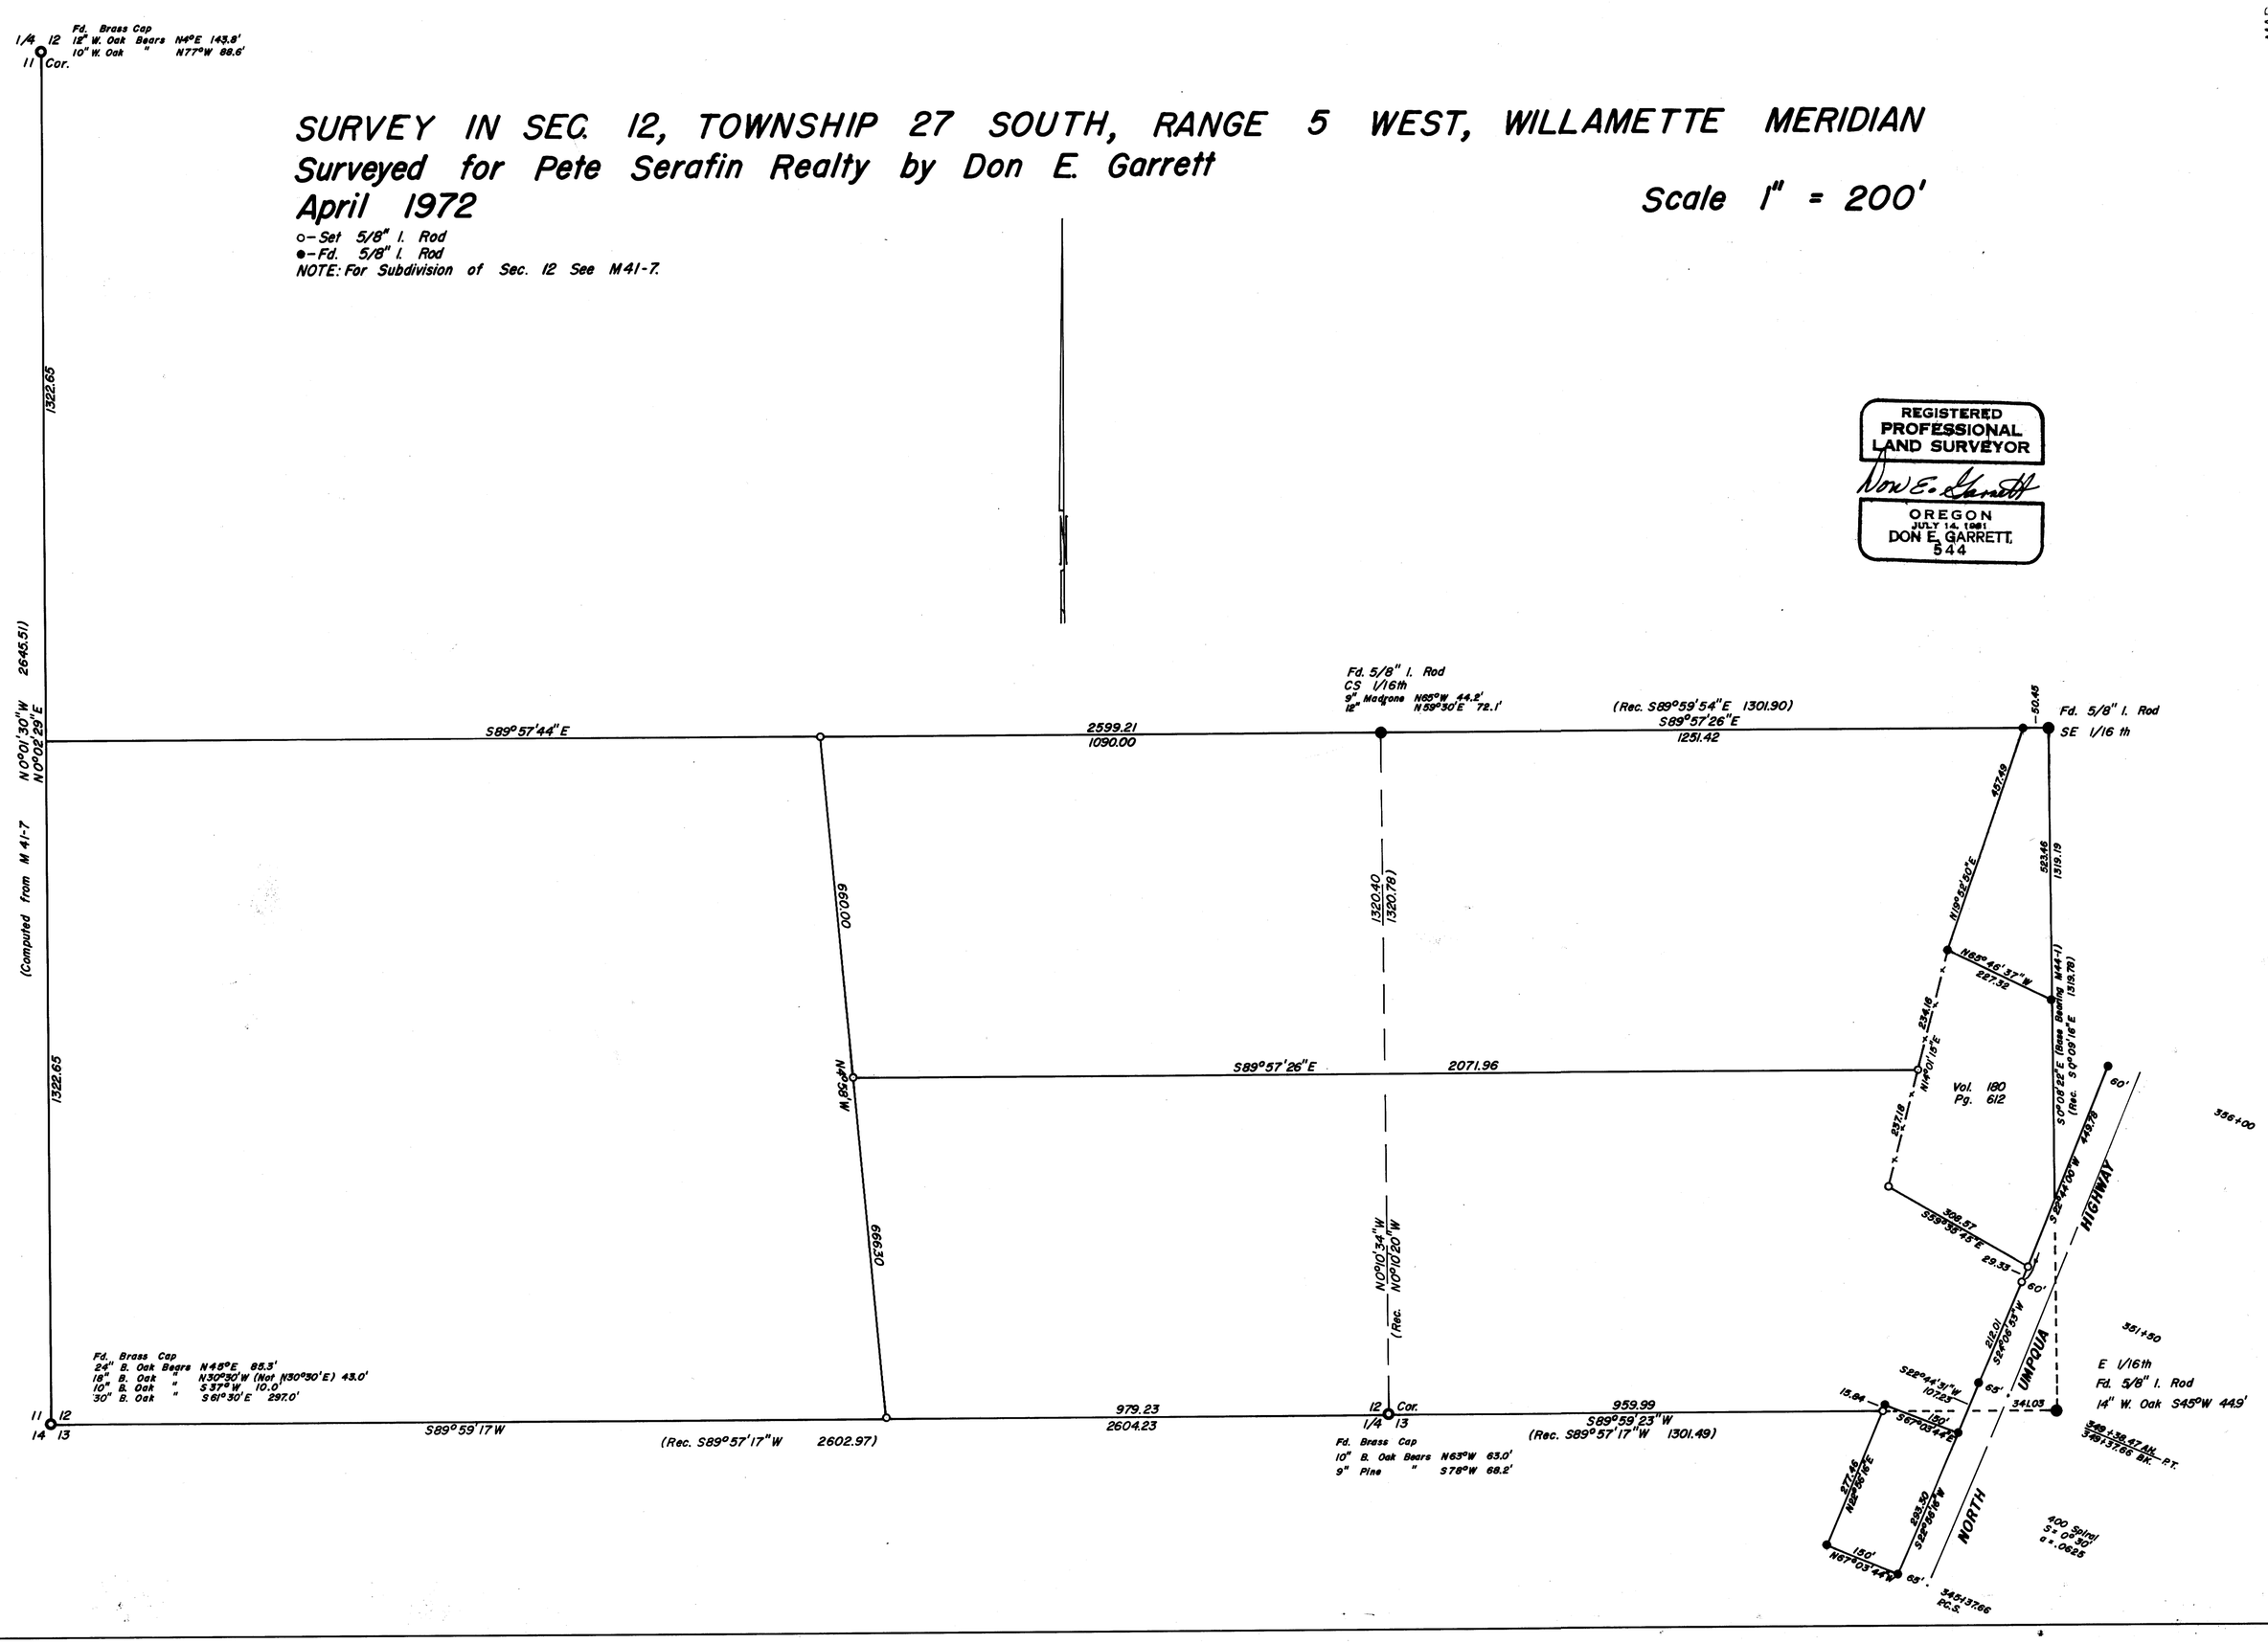

REGISTERED
PROFESSIONAL
LAND SURVEYOR
Don E. Garrett
OREGON
JULY 14, 1981
DON E. GARRETT
544

MAP FILE M44-72