


SURVEY IN SECTIONS 5, 8, 9, T.29S., R.6W., W.M., DOUGLAS COUNTY, ORE. FOR DOUG RICE, RICE-CREEK, DILLARD, ORE.

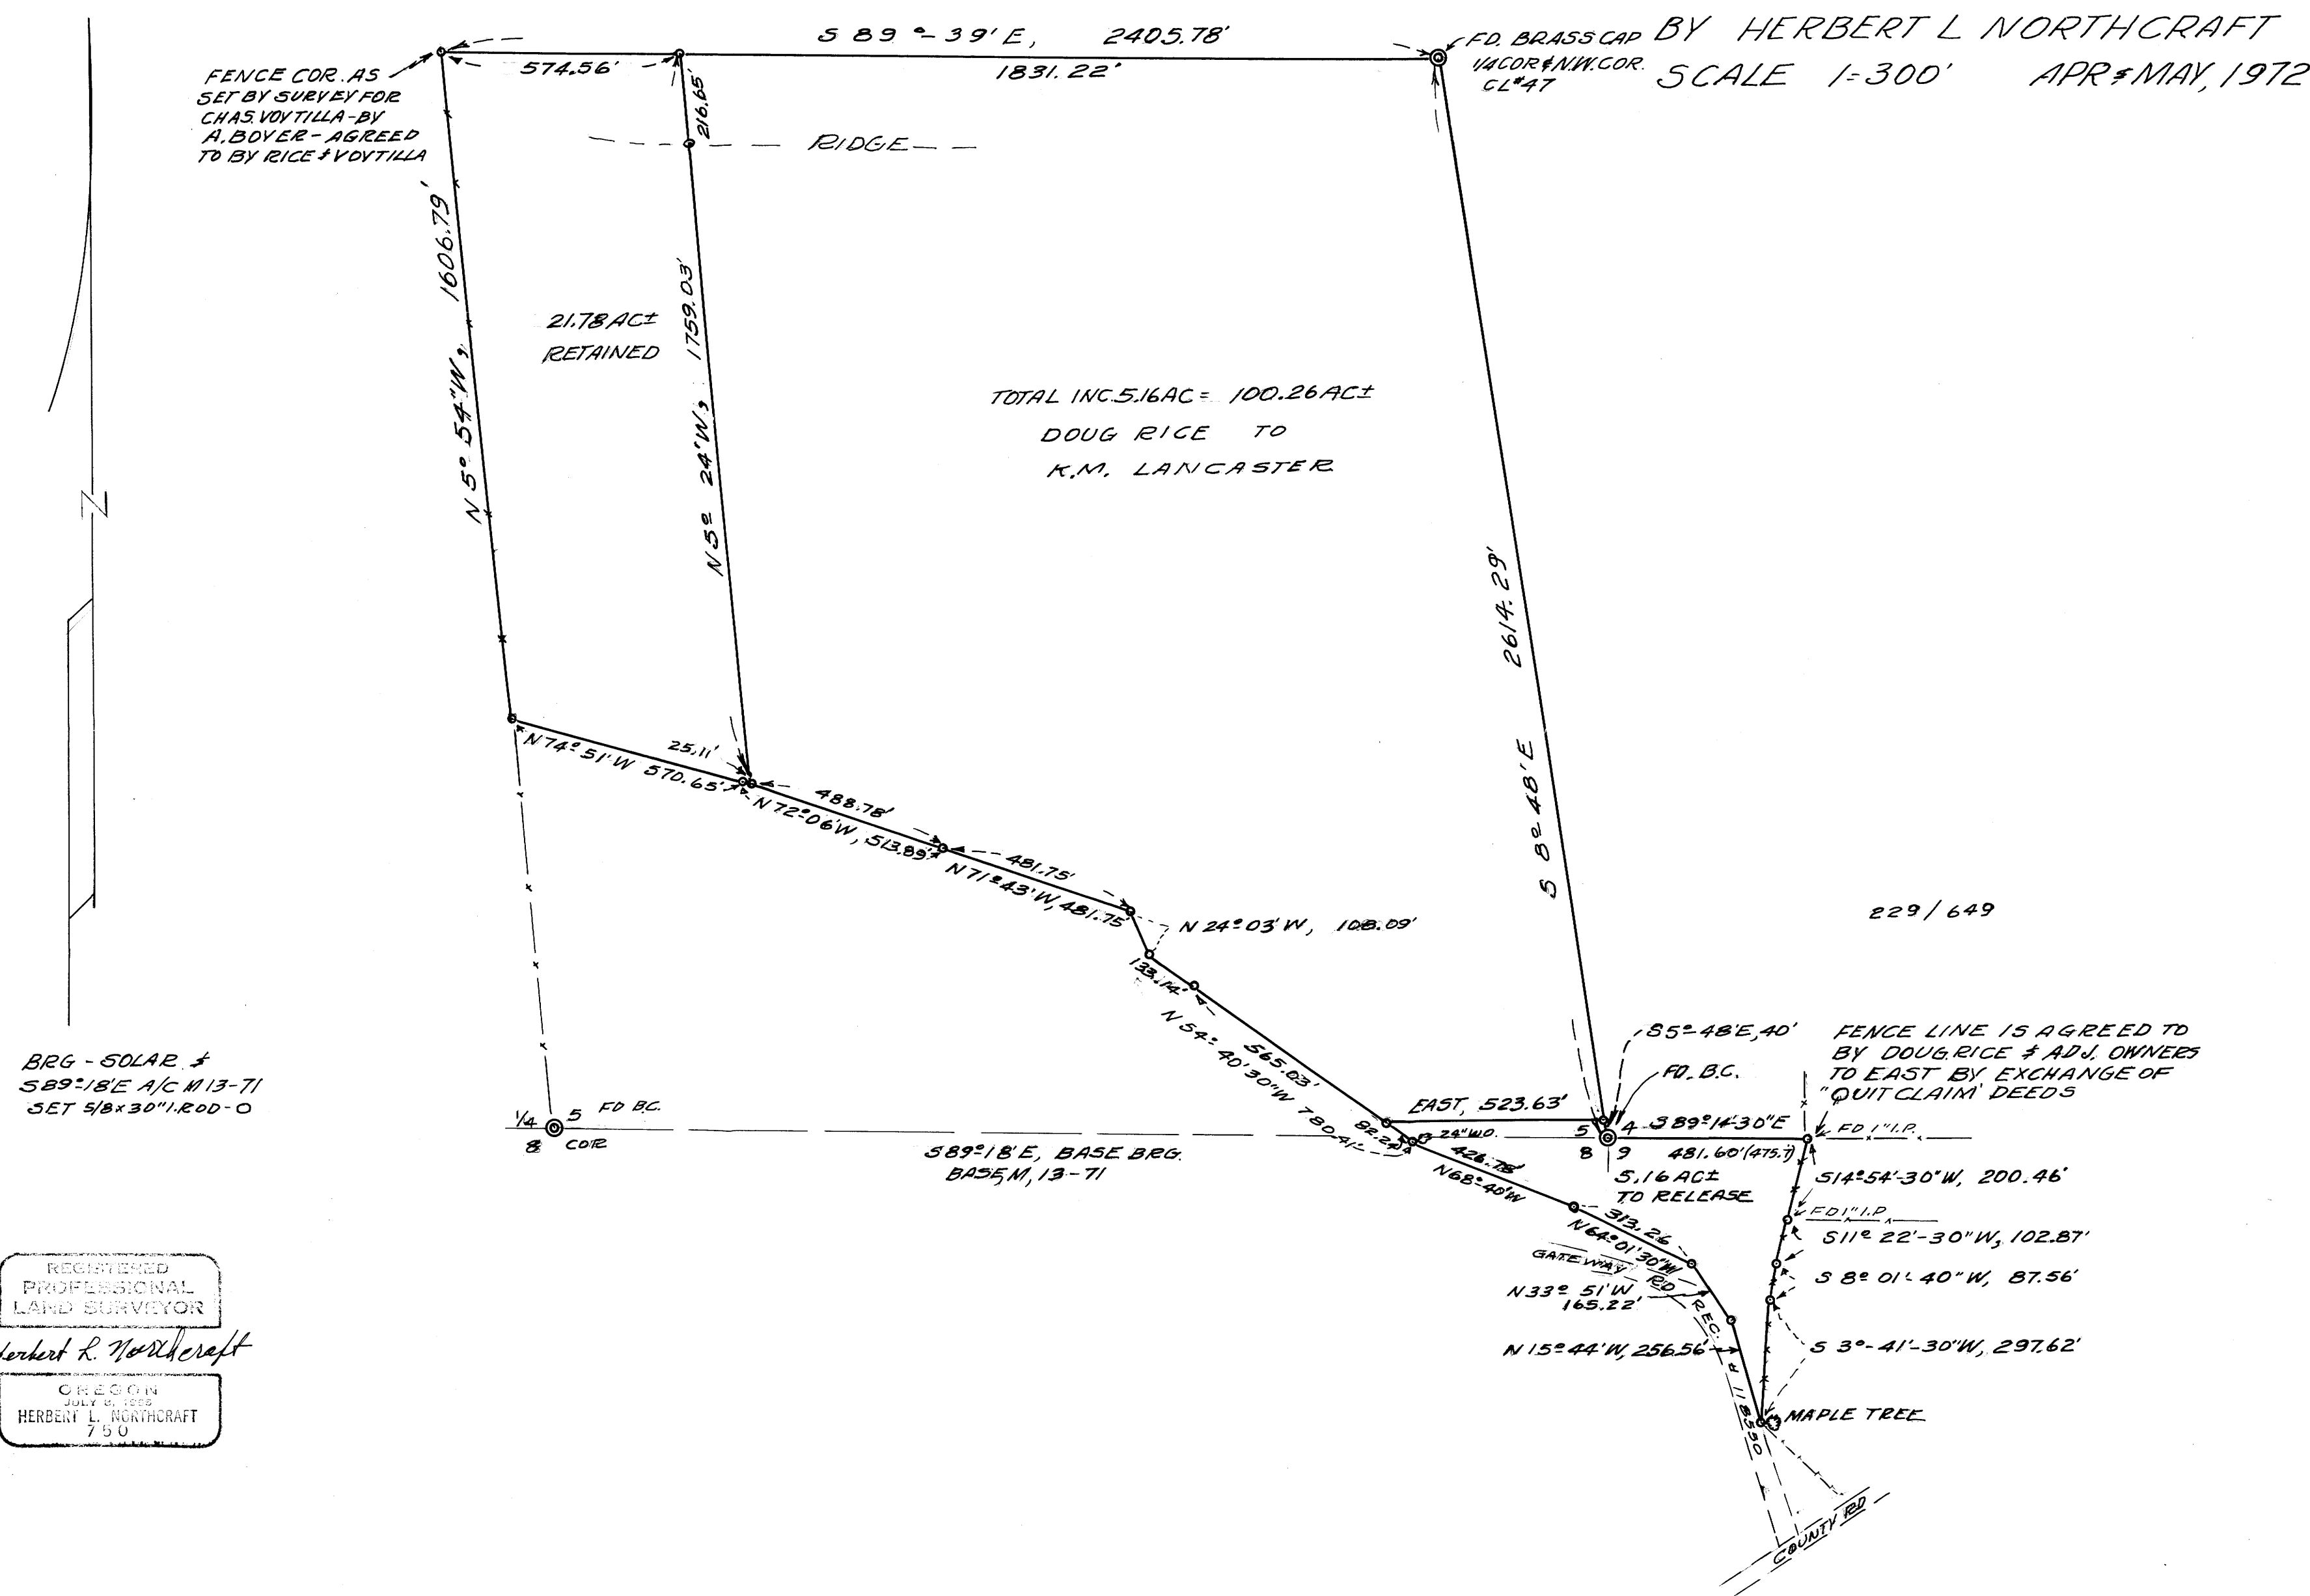

MAP FILE M-44-80

MAP FILE M-44-80