COUNTY SURVEYORS FILE DATA
DO NOT REMOVE FROM OFFICE

SURVEY OF PARCEL FOR HOME BUILDING SITE IN S.E. 1/4 SECTION 14, T. 28 S., R. 6 W., W.M., DOUGLAS CO., ORE. FOR RALPH CARNES

A/C. VOL 406 PGE 407 & 408

BY HERBERT L NORTHCRAFT — MAY 1972 — SCALE 1"=100'

FILED
RECEIVED
MAY 23 1972
COUNTY SURVEYOR
DOUGLAS COUNTY, ORE.

MAP FILE M 45 - 6

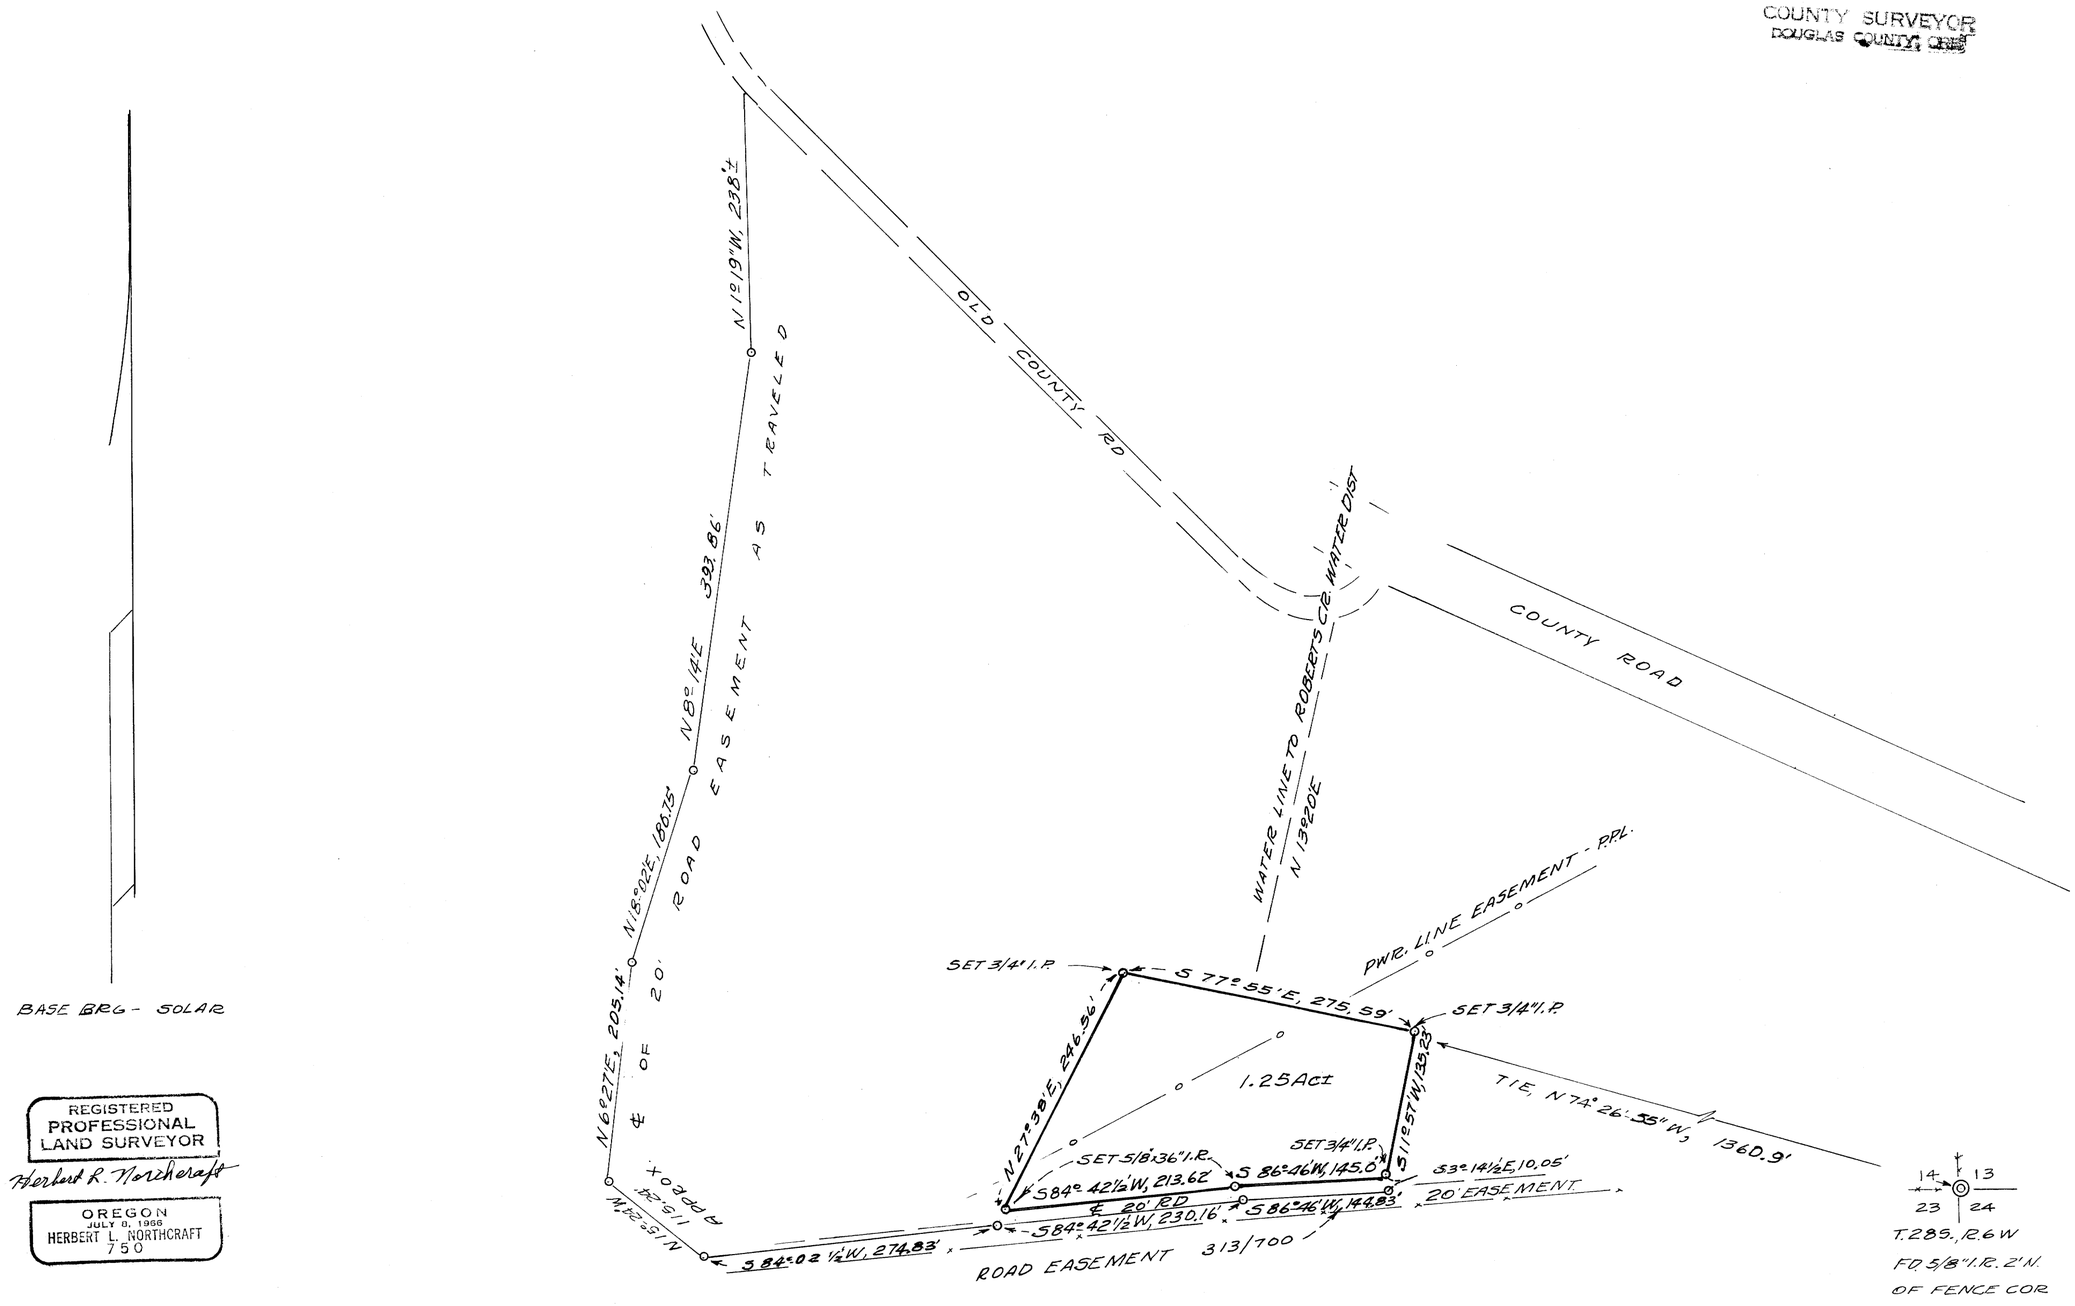

REGISTERED
PROFESSIONAL
LAND SURVEYOR
Herbert R. Northcraft
OREGON
JULY 8, 1966
HERBERT L. NORTHCRAFT
750

MAP FILE M 45 - 6