MAP FILE M45-71

SURVEY IN SECTIONS 2 & 3, DLC 45, TOWNSHIP 27 SOUTH, RANGE 6 WEST, WILLAMETTE MERIDIAN

Surveyed for Walter Welker by Don E. Garrett
May 1972

COUNTY SURVEYORS FILE DATA
DO NOT REMOVE FROM OFFICE

Scale 1" = 200'

Bearings are based on the "L" Line Location of Fisher Road No. 189.
o-Set 5/8" I. Rod

FILED
RECEIVED
JUN 7
COUNTY SURVEYOR
DOUGLAS COUNTY, OREGON

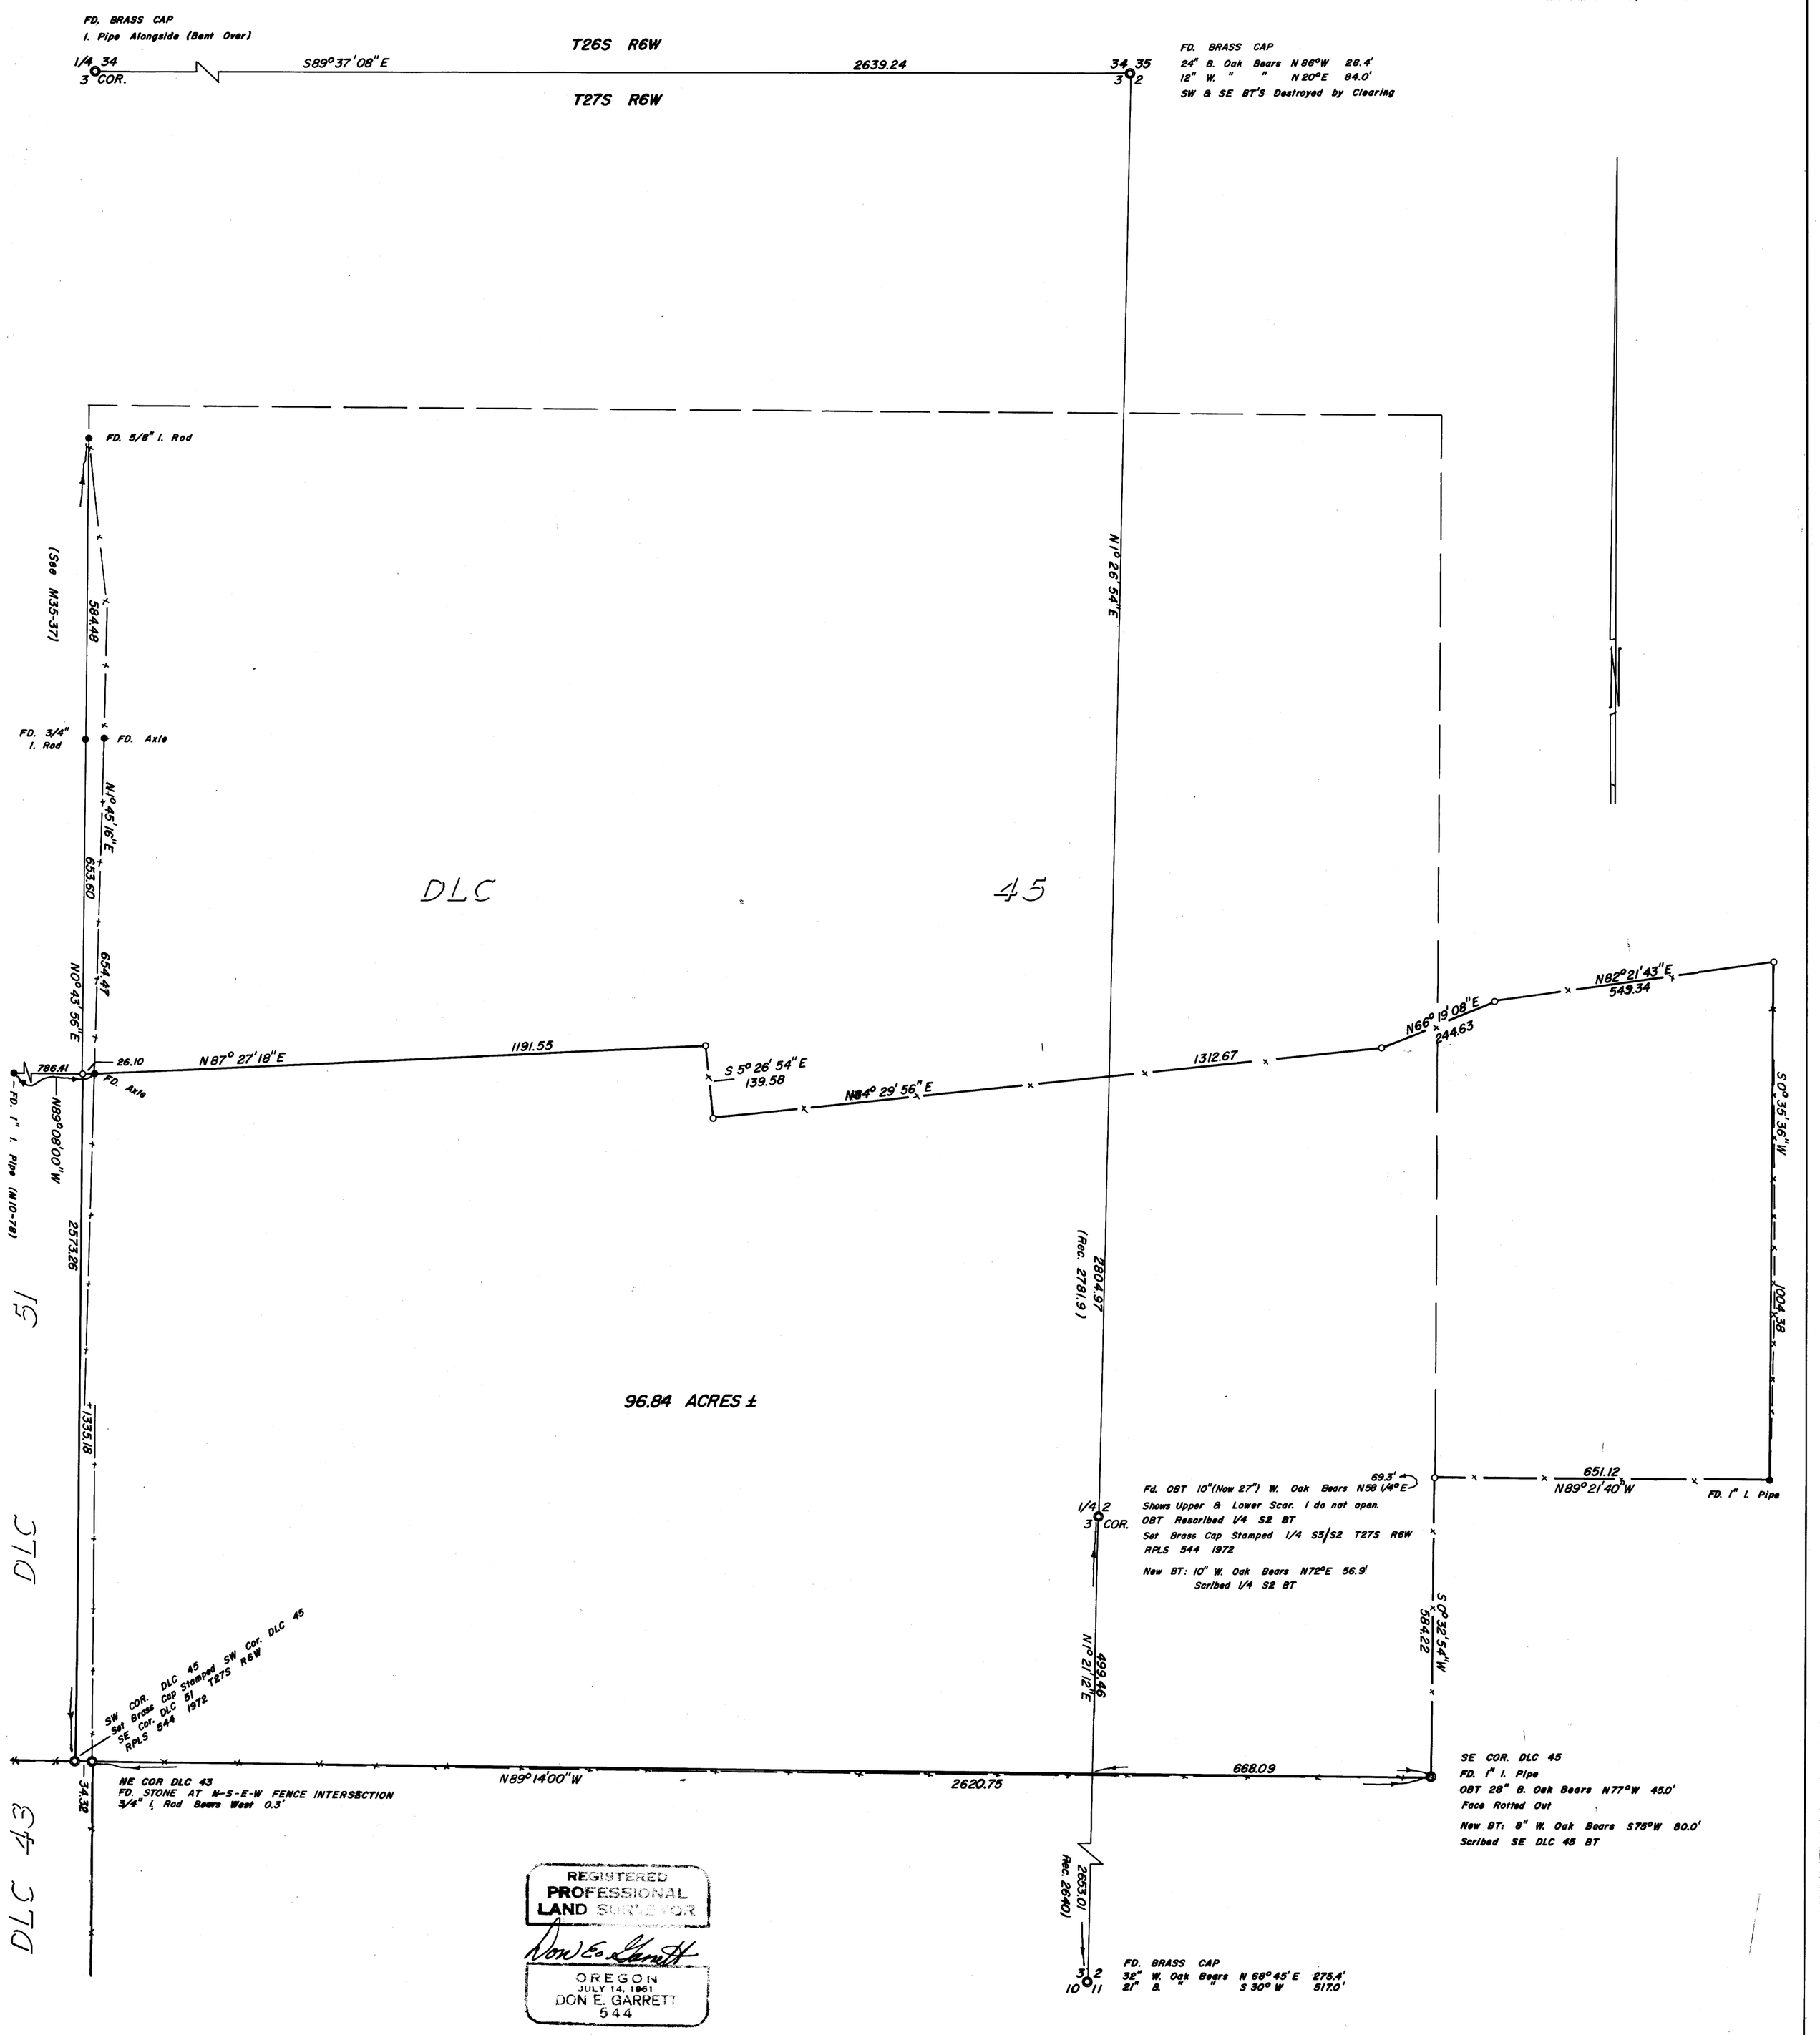

REGISTERED
PROFESSIONAL
LAND SURVEYOR
Don E. Garrett
OREGON
JULY 14, 1961
DON E. GARRETT
544

MAP FILE M45-71