MAP FILE M 46 - 21

SURVEY TO LOCATE THE EASTERLY PROPERTY LINE OF YONCALLA GRADE SCHOOL IN BLOCK ONE, DEVORE'S ADDITION TO YONCALLA, DOUGLAS COUNTY, OREGON

SURVEYED FOR SCHOOL DISTRICT NO. 32 BY VICTOR M. McLIND

JULY, 1972

SCALE: 1" = 100'

COUNTY SURVEYORS FILE DATA
DO NOT REMOVE FROM OFFICE

FILED
RECEIVED
AUG 1 1972
COUNTY SURVEYOR
DOUGLAS COUNTY, ORE.

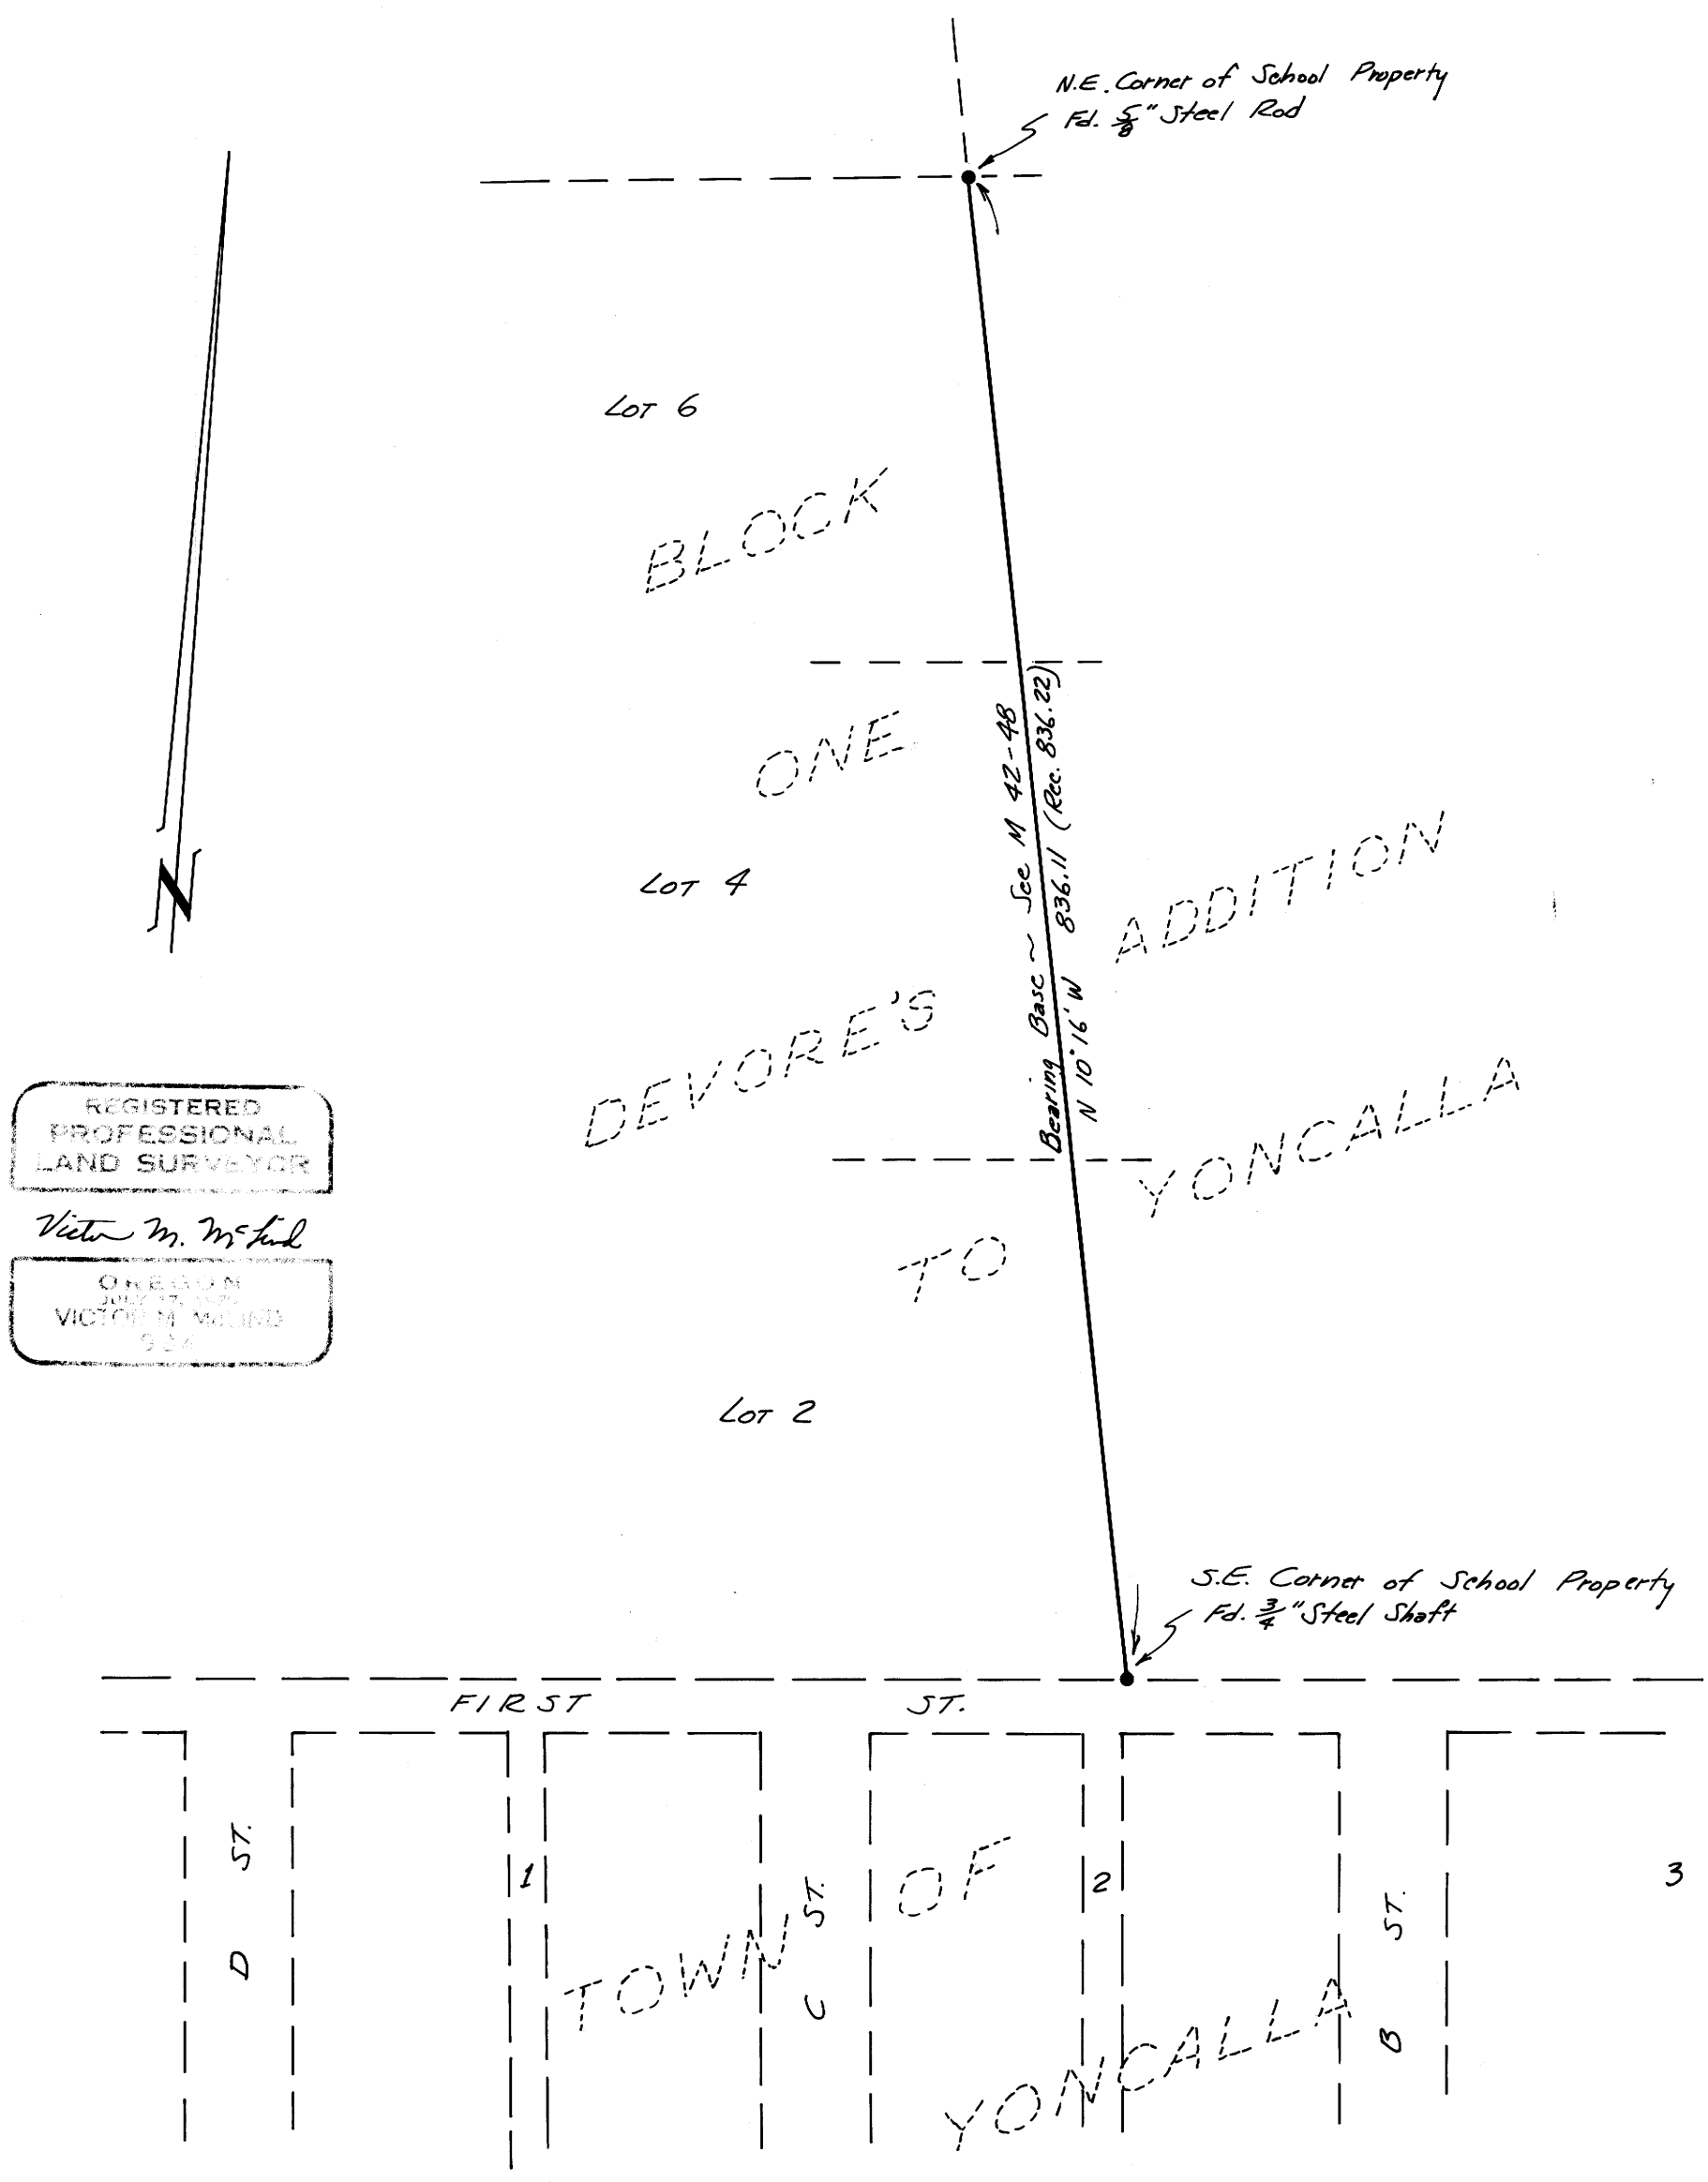

REGISTERED
PROFESSIONAL
LAND SURVEYOR
Victor M. McLind
OREGON
JULY 17, 1972
VICTOR M. McLIND
934

P MAP FILE M 46 - 21