M46 - 24

FILED
RECEIVED
AUG 8 1972
COUNTY SURVEYOR
DOUGLAS COUNTY, ORE.

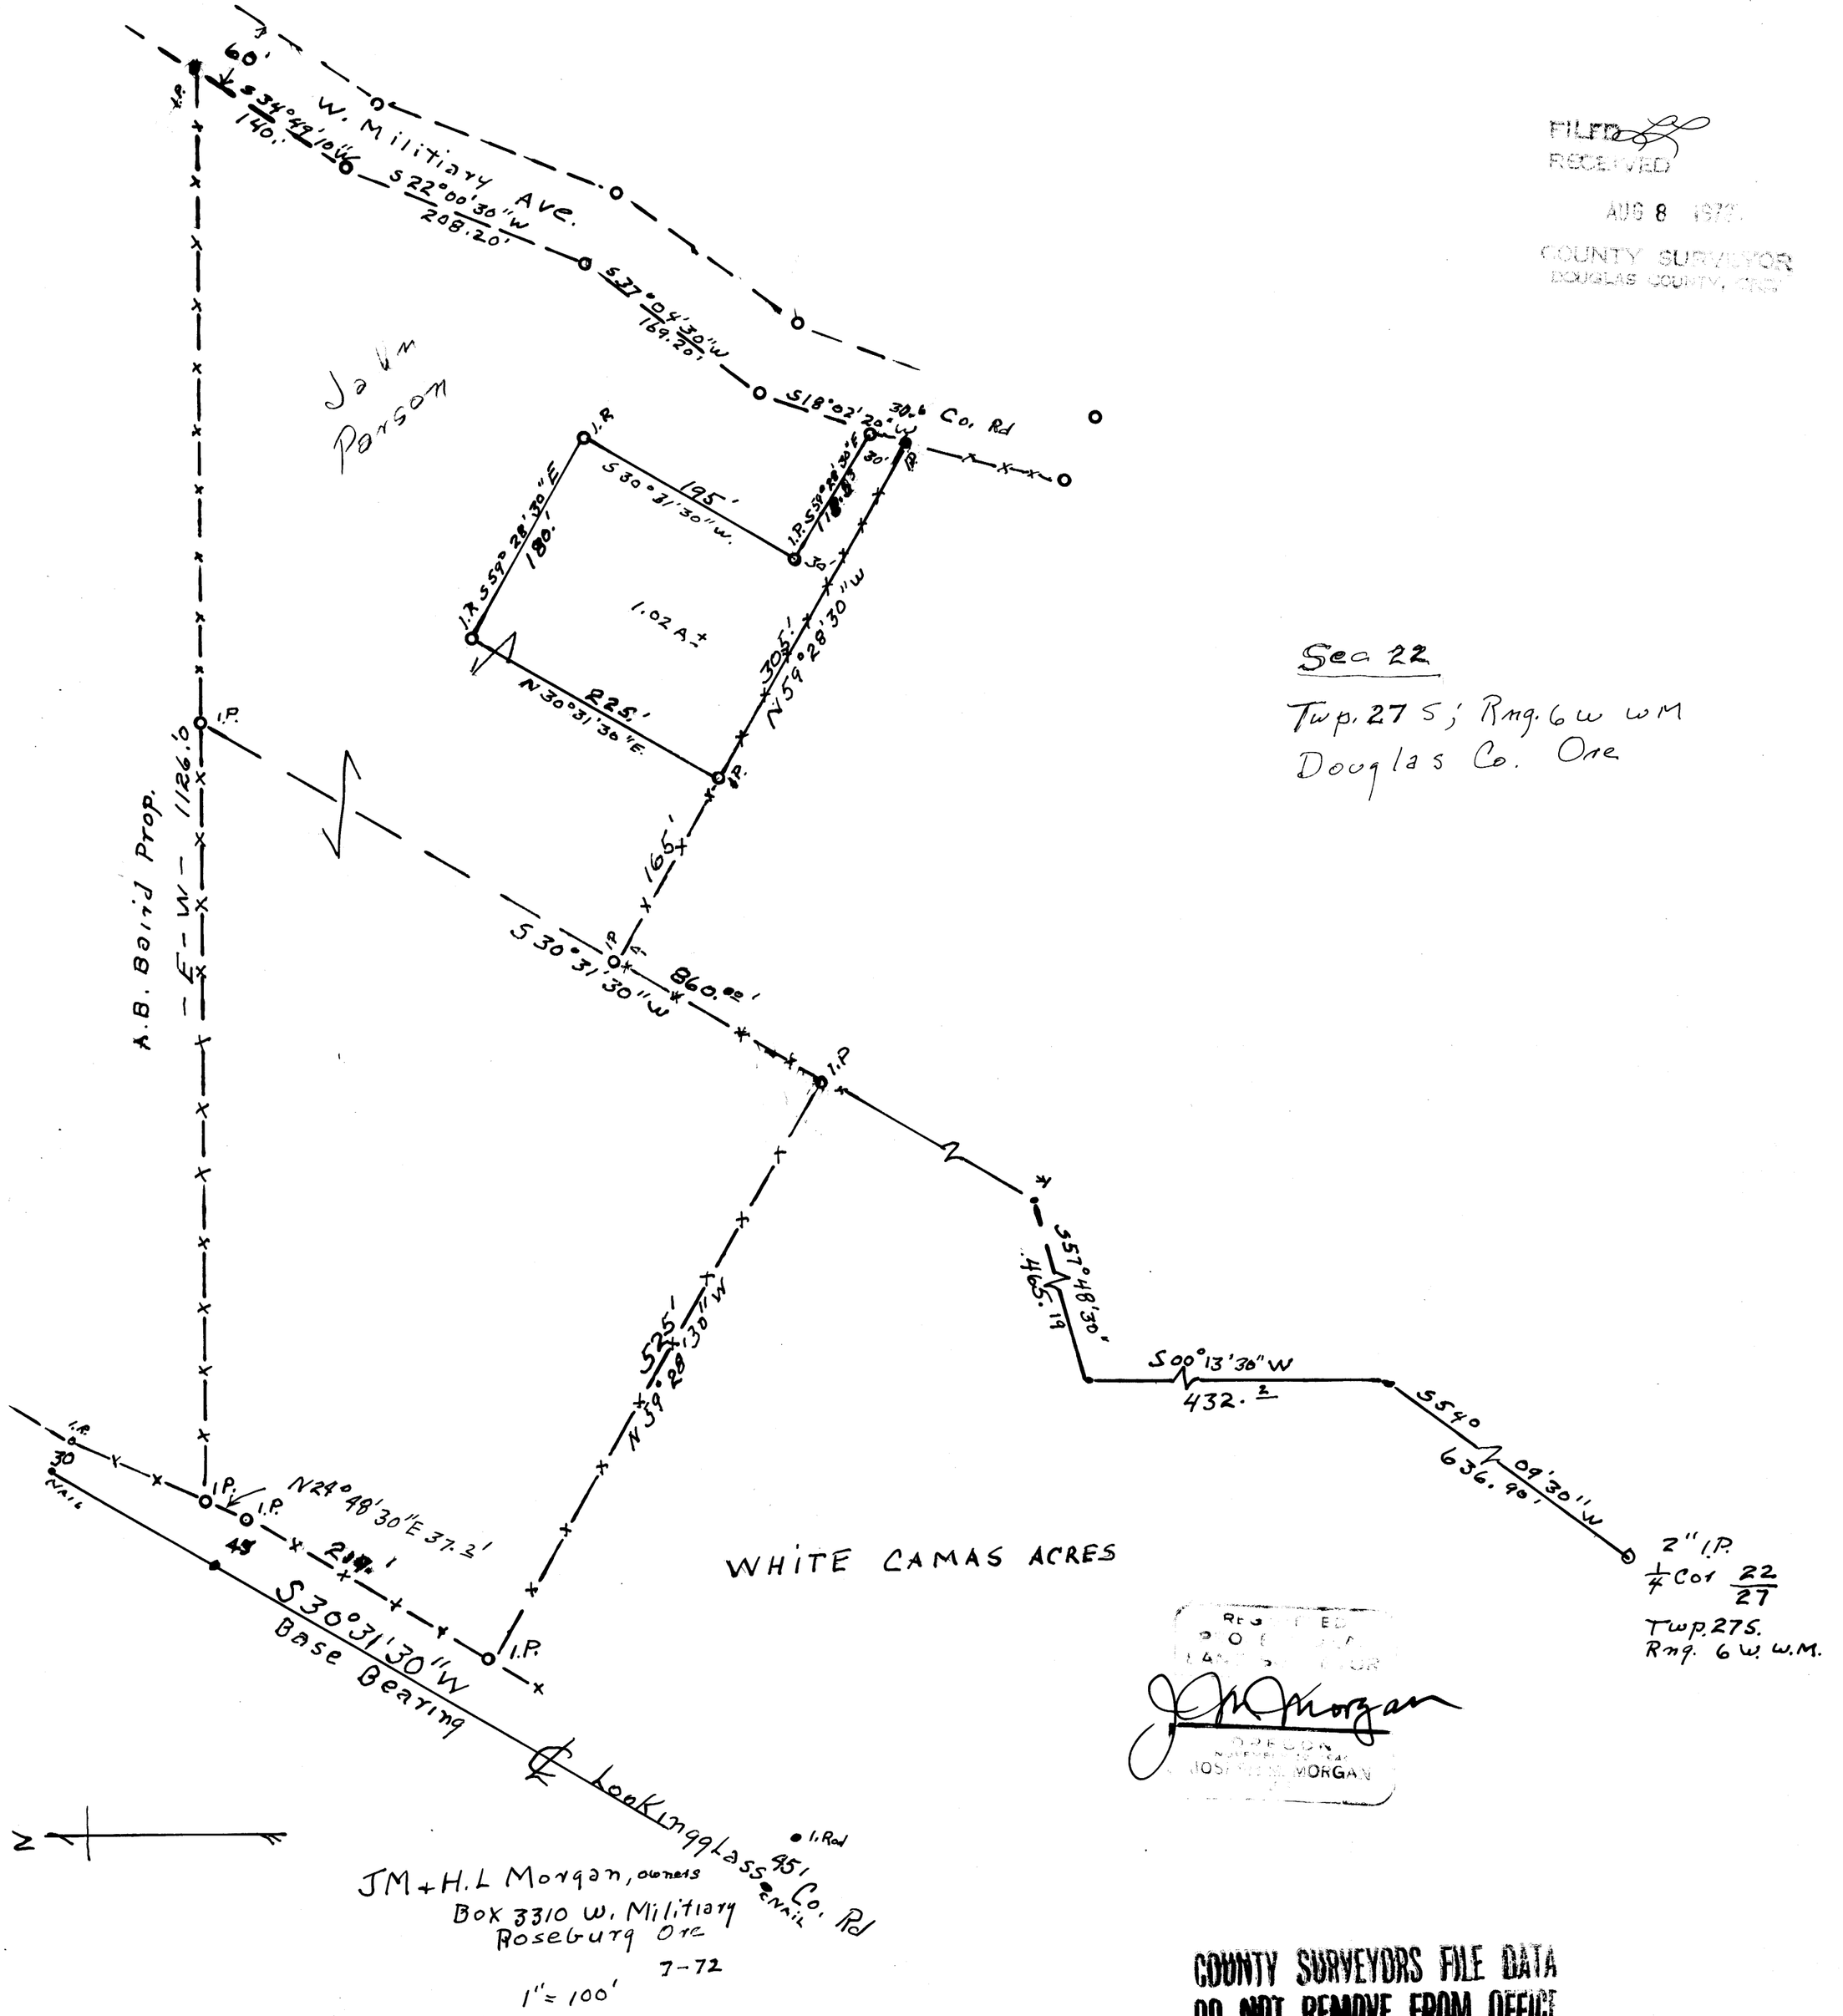

Sec 22

Twp. 27 S; Rng. 6 W WM
Douglas Co. Ore

JM + H.L Morgan, owners
Box 3310 W. Military
Roseburg Ore

7-72

1" = 100'

J M Morgan
OREGON
JOSEPH M. MORGAN

COUNTY SURVEYORS FILE DATA
DO NOT REMOVE FROM OFFICE

P. MAP FILE M 46 - 24