3z - 9M 4

SURVEY IN LOTS 26 & 29, PLAT "D", ROSEBURG HOME ORCHARD TRACTS IN THE N.W. ¼ SEC. 7, T26S, R5W, W.M.

Surveyed for Fred Phillips by Victor M. McLind

August 1972 Scale : 1" = 100'

Bearings Based on Solar Observation Aug. 7, 1972

o ~ Indicates Set ⅝" Iron Rod

COUNTY SURVEYORS FILE DATA
DO NOT REMOVE FROM OFFICE

COUNTY SURVEYOR
DOUGLAS COUNTY, ORE.

REGISTERED
PROFESSIONAL
LAND SURVEYOR
Victor M. McLind
OREGON

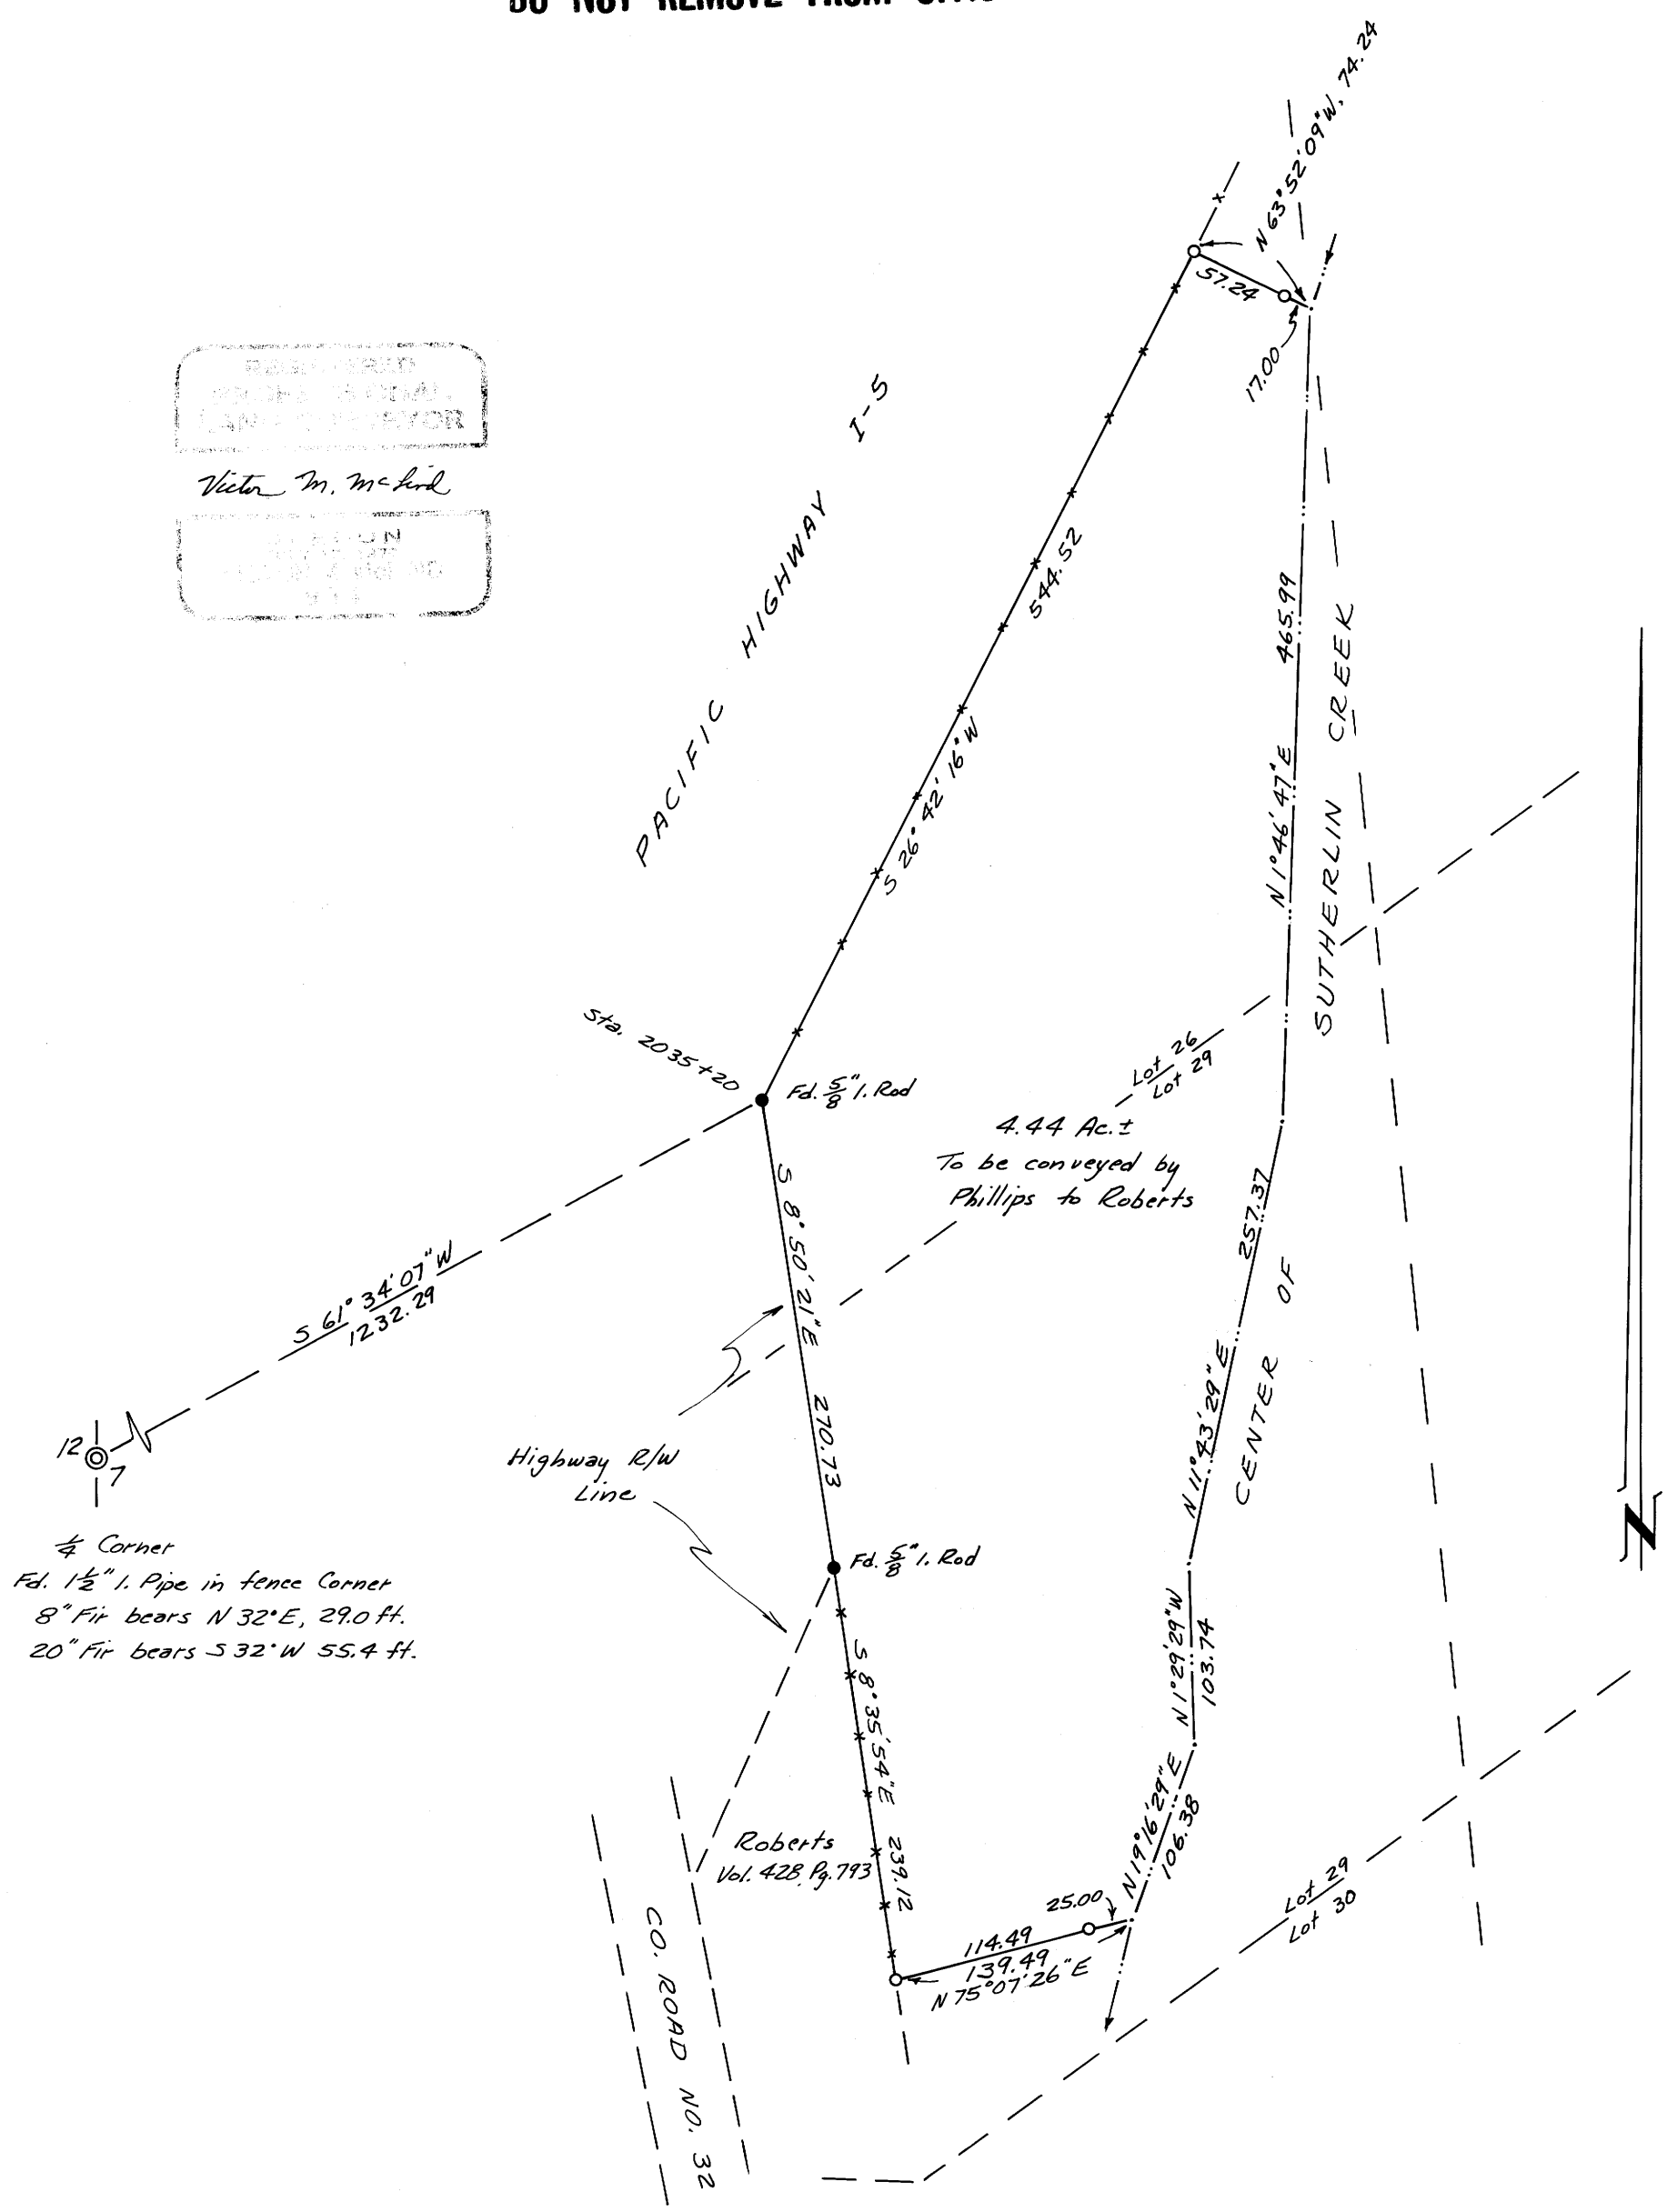

M 46 - 28