COUNTY SURVEYORS FILE DATA
DO NOT REMOVE FROM OFFICE

FILED
RECEIVED 2 4
1972
COUNTY SURVEYOR
DOUGLAS COUNTY, OREGON

M46-30

SURVEY IN SECTION 31, TOWNSHIP 27 SOUTH, RANGE 5 WEST, WILLAMETTE MERIDIAN
SURVEYED FOR BOB JENKINS BY DON E. GARRETT
JUNE 1972 SCALE 1" = 200'
●- Found 5/8" I. Rod
○- Set 5/8" I. Rod

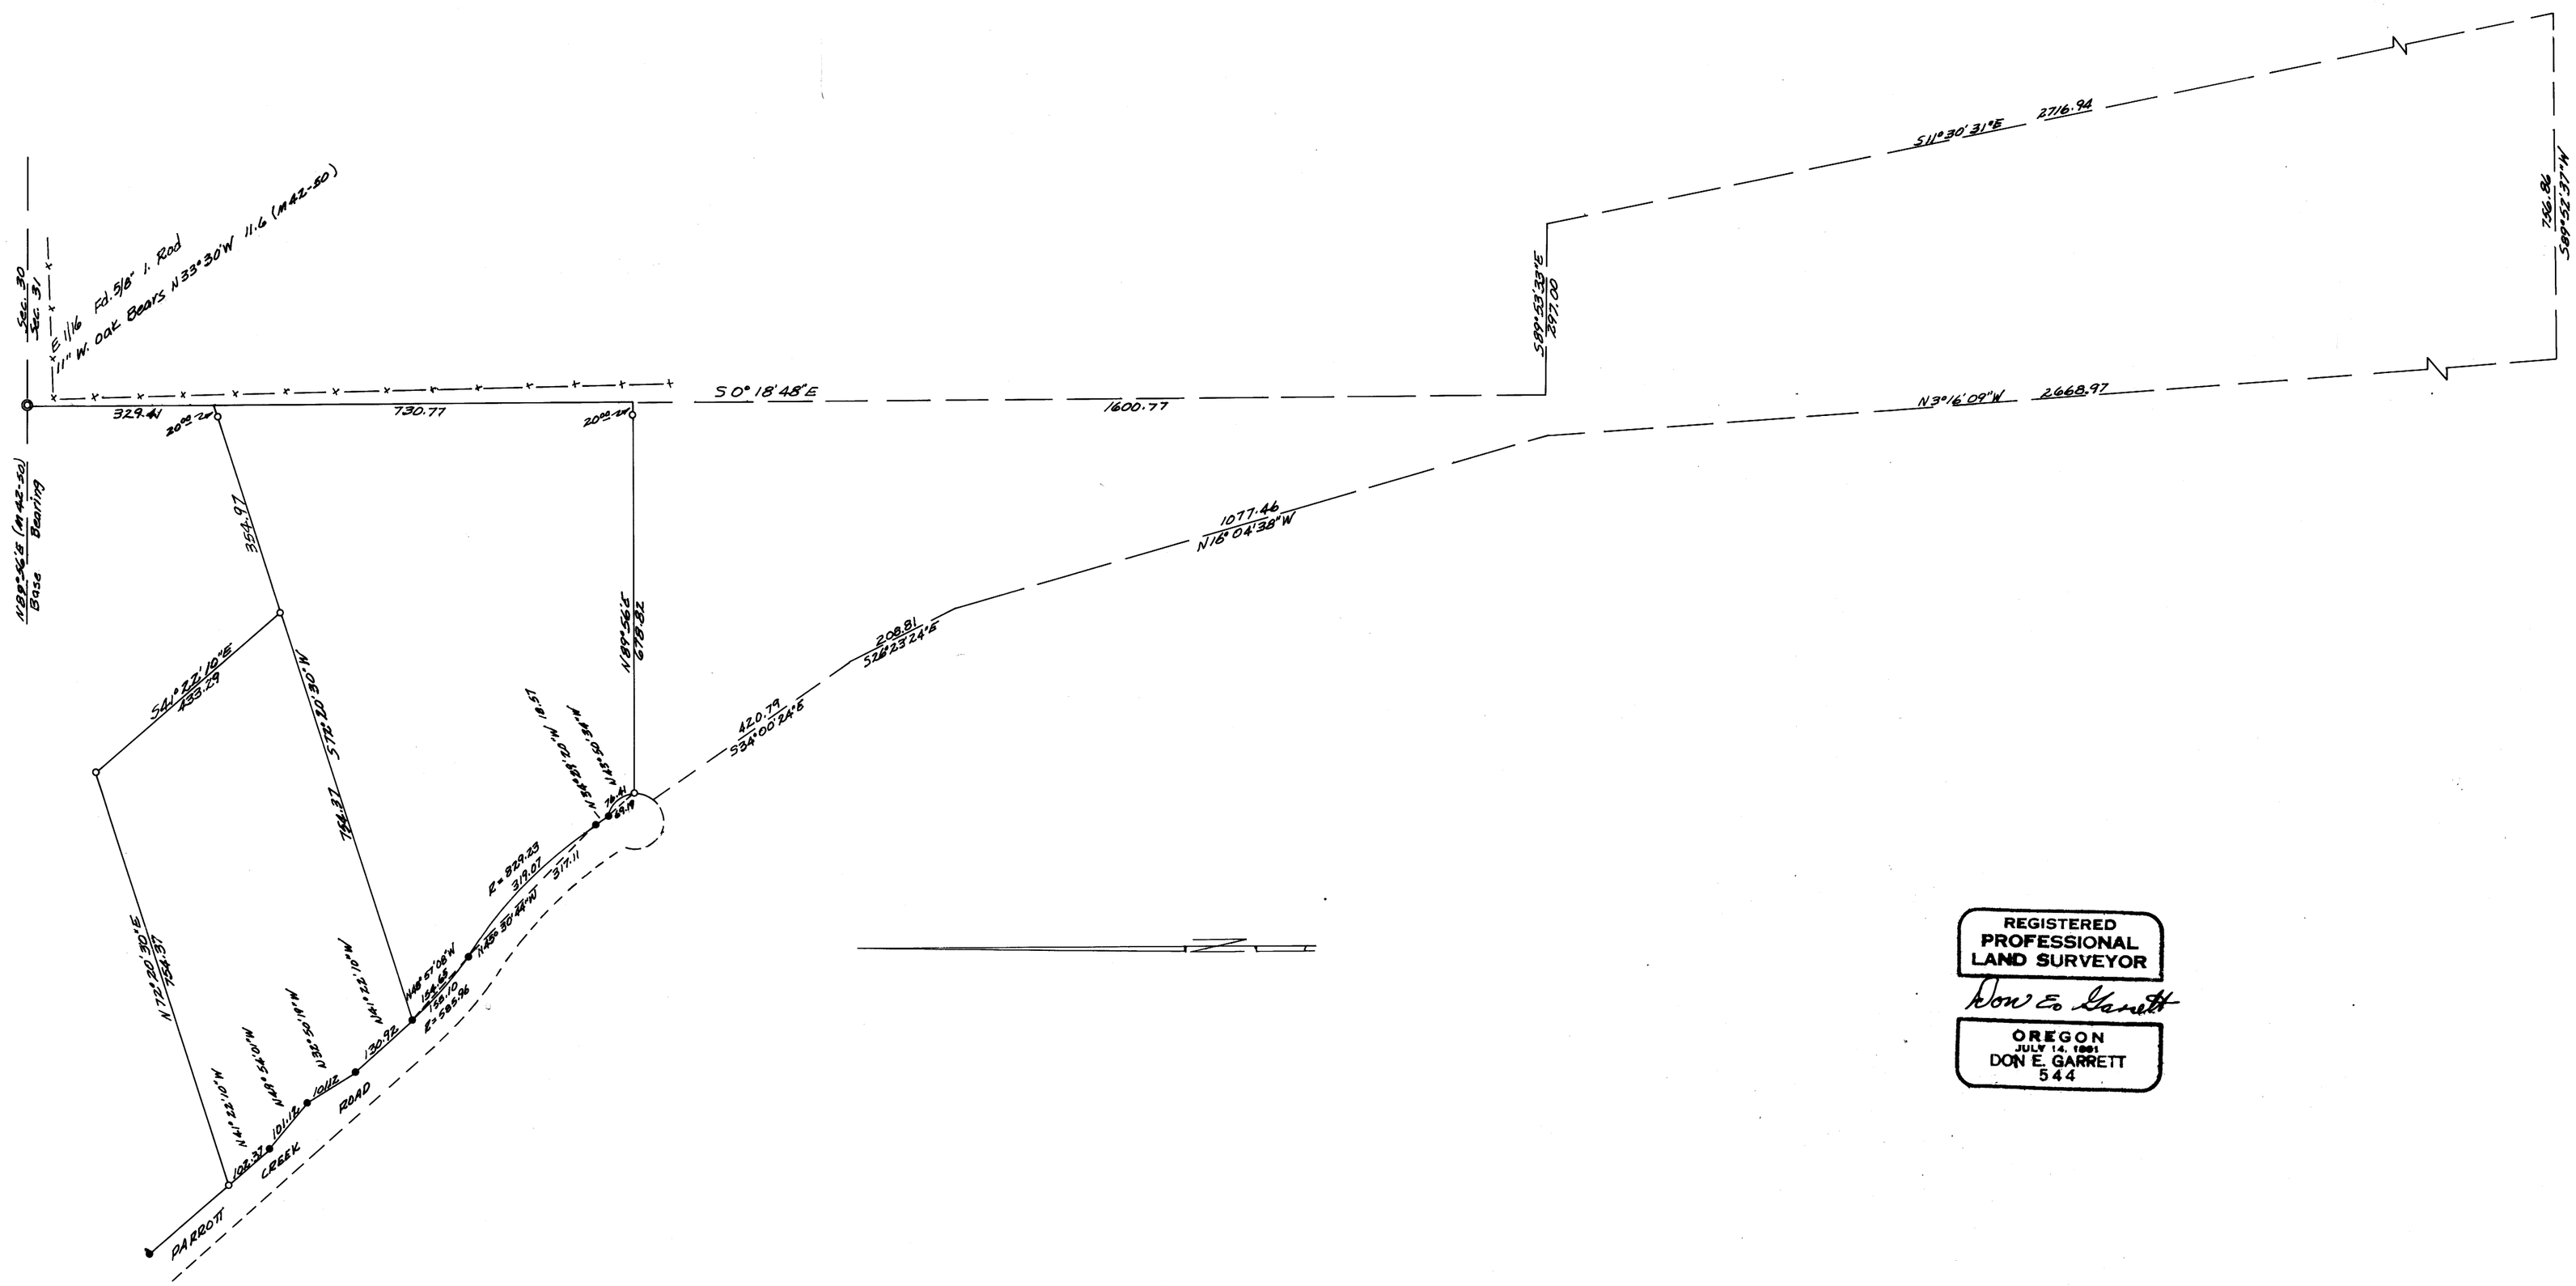
Sec. 30
Sec. 31
E 1/16 Fd. 5/8" I. Rod
11" W. Oak Bears N33°30'W 11.6 (M42-50)
N89°46'E (M42-50)
Basis Bearing
329.41
730.77
S 0° 18' 48" E
1600.77
S89°53'33"E
2697.00
S11°30'31"E 2716.94
S89°53'37"W
756.86
N3°16'09"W 2668.97
1077.46
N16°04'38"W
208.81
S28°23'24"E
420.79
S34°00'24"E
N89°56'19"W
678.82
S41°22'10"E
493.29
