M 46-44

SURVEY IN SECTION 22, T 25 S, R 5 W, W.M.

Surveyed For Hugh Wahl by Victor M. McLind

August 1972 Scale: 1" = 100'

FILED & RECEIVED
SEP 18 1972
COUNTY SURVEYOR
DOUGLAS COUNTY, ORE.

Bearings based on Solar Observation July 28, 1972

● ~ Fd. 5/8" Iron Rod on N. Line of Co. Road R/W
○ ~ Set 5/8" Iron Rod

COUNTY SURVEYORS FILE DATA
DO NOT REMOVE FROM OFFICE

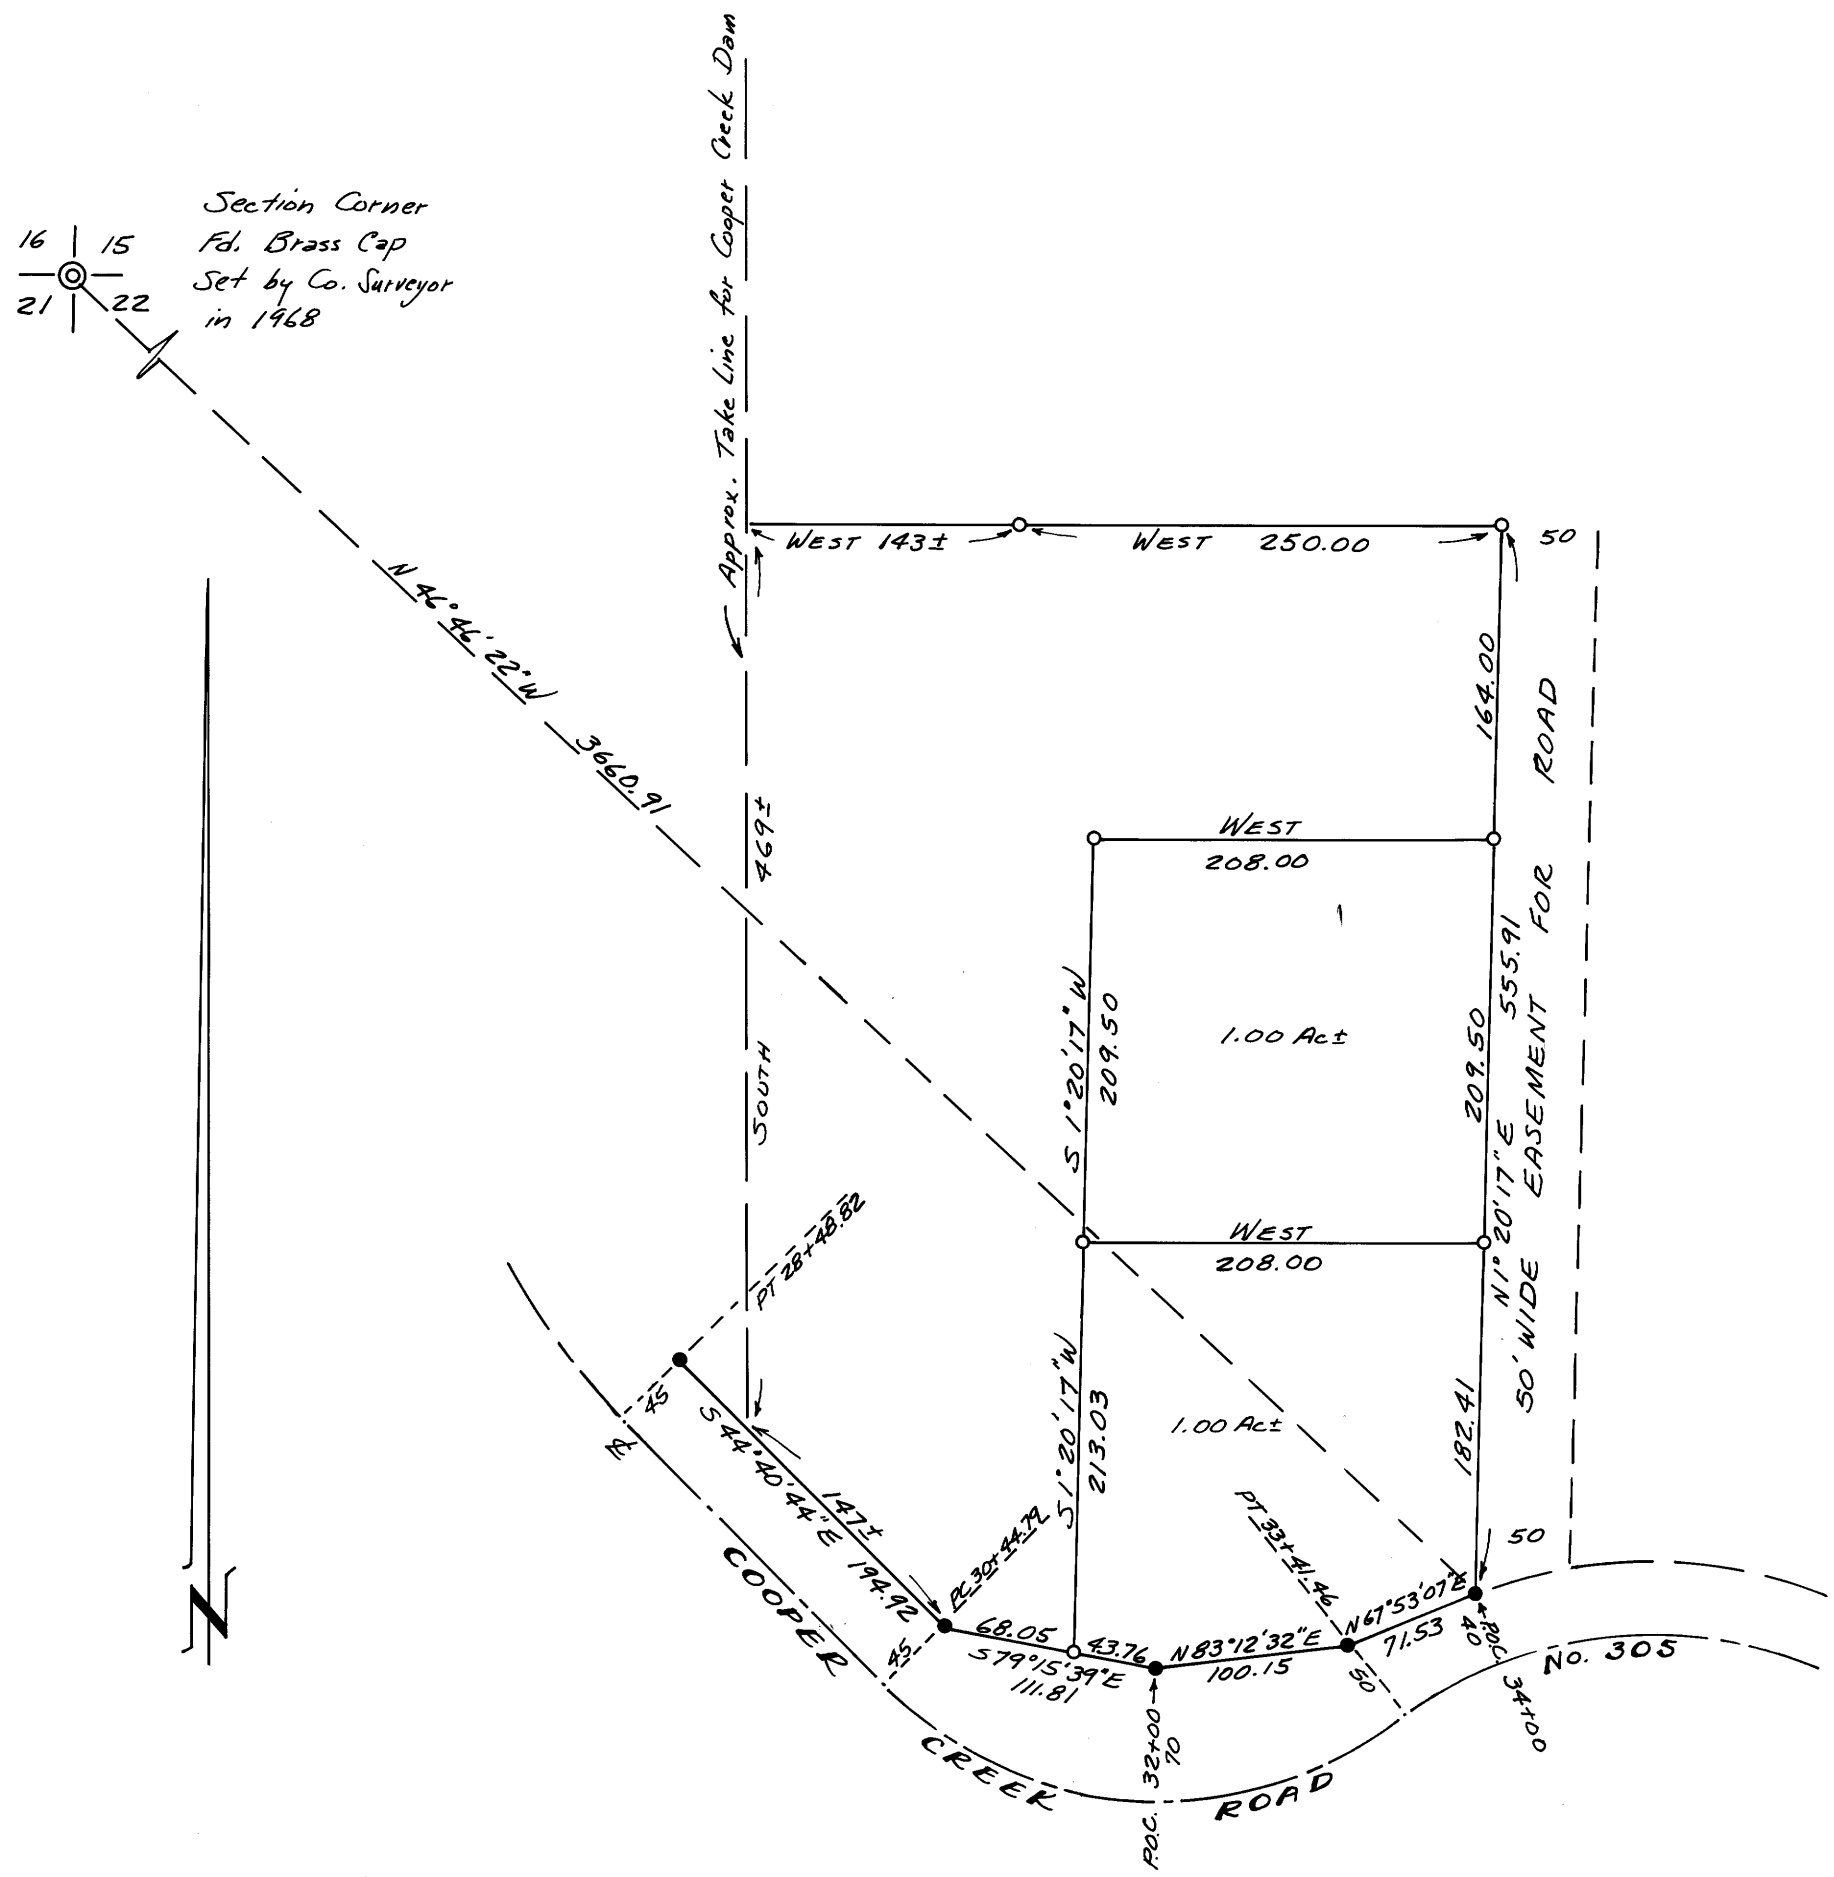

Victor M. McLind

M 46-44