MAP FILE M 46 - 57

COUNTY SURVEYORS FILE DATA
DO NOT REMOVE FROM OFFICE

FILED
RECEIVED
SEP 29 1972
COUNTY SURVEYOR
DOUGLAS COUNTY, ORE.

SURVEY FOR
U.S. DEPARTMENT OF THE INTERIOR
BUREAU OF LAND MANAGEMENT

SECTION 12, T20S, R9W.
DOUGLAS COUNTY

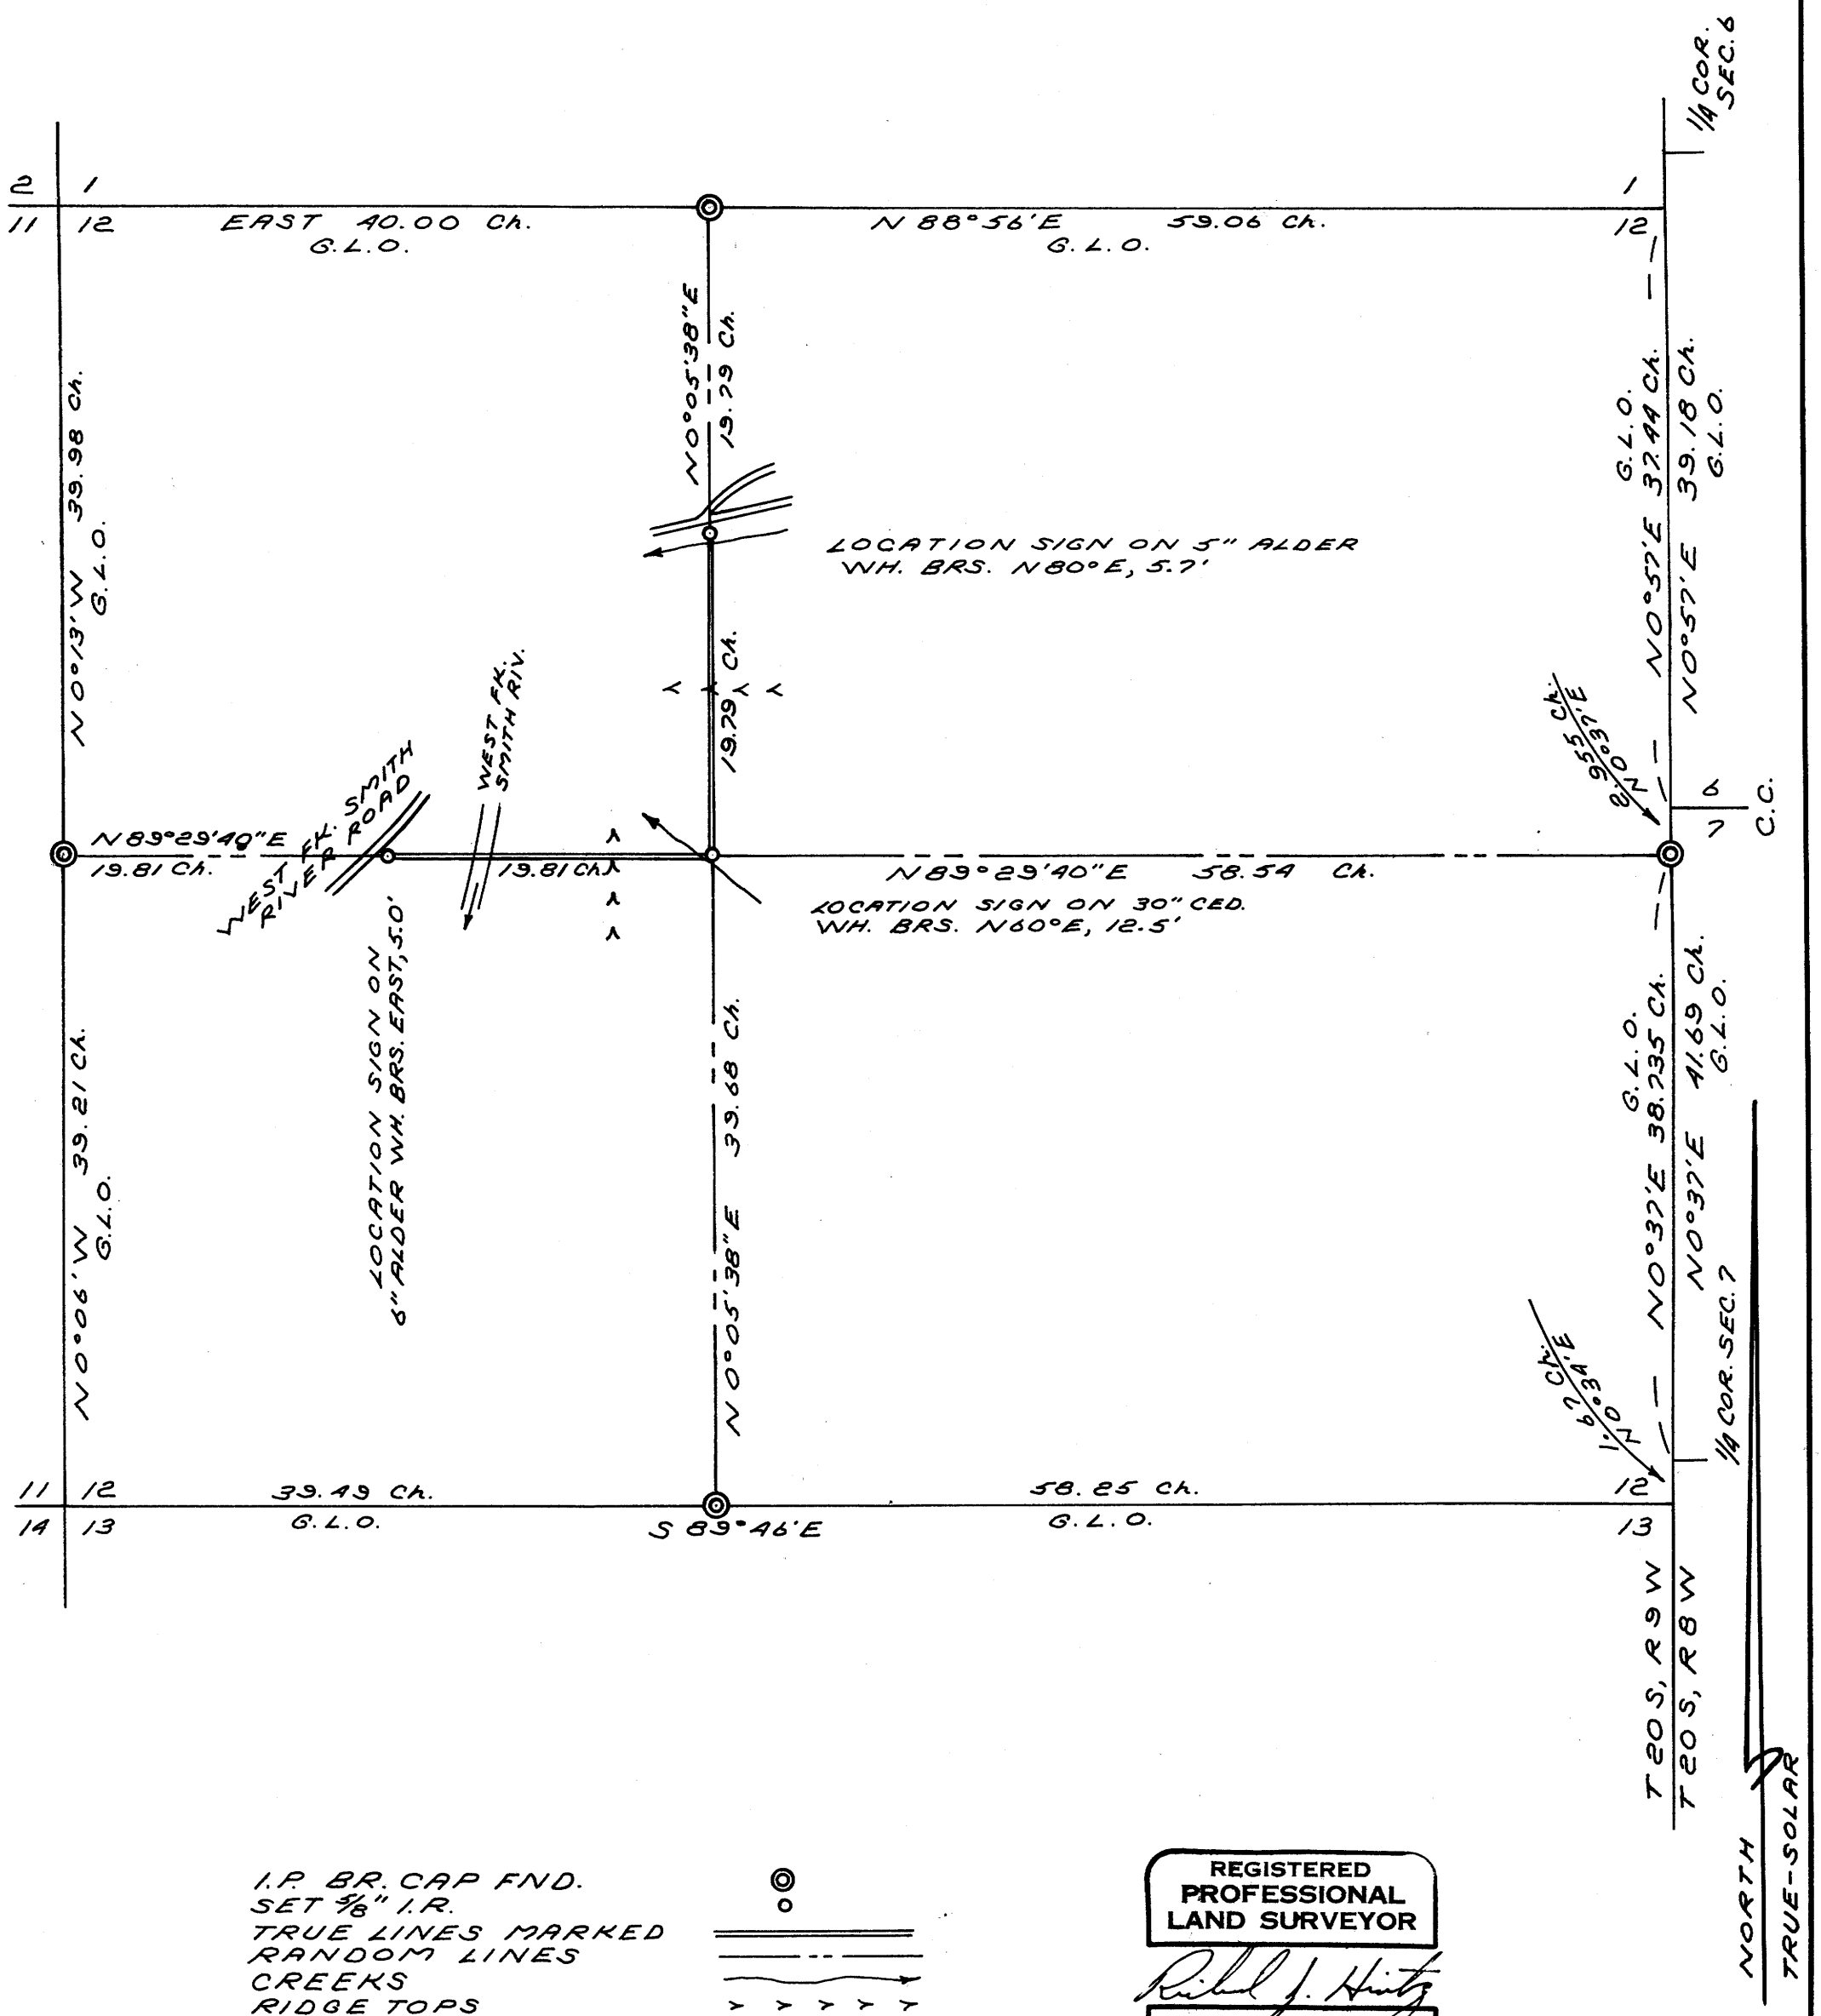

I.P. BR. CAP FND.
SET 5/8" I.R.
TRUE LINES MARKED
RANDOM LINES
CREEKS
RIDGE TOPS

SCALE: 1" = 660'
JULY 8, 1972

REGISTERED
PROFESSIONAL
LAND SURVEYOR
Richard J. Hintz
OREGON
MAY 13, 1960
RICHARD J. HINTZ
497

MAP FILE M 46 - 57