COUNTY SURVEYORS FILE DATA
DO NOT REMOVE FROM OFFICE

DAN ROTH

N½ Section 16, T.24S., R.7W.W.M.
Douglas County, Oregon
Scale 1" = 400' Sept 27, 1972
Bearings from Survey for D. Brownson by W.S. Barnes Filed Mar. 10, 1971

B. Osburn Shaw
O.L.S. #431

FILED
RECEIVED
OCT 2 1972
COUNTY SURVEYOR
DOUGLAS COUNTY, ORE.

REGISTERED
PROFESSIONAL
LAND SURVEYOR
B. Osburn Shaw
OREGON
OCTOBER 4, 1957
B. OSBURN SHAW
431

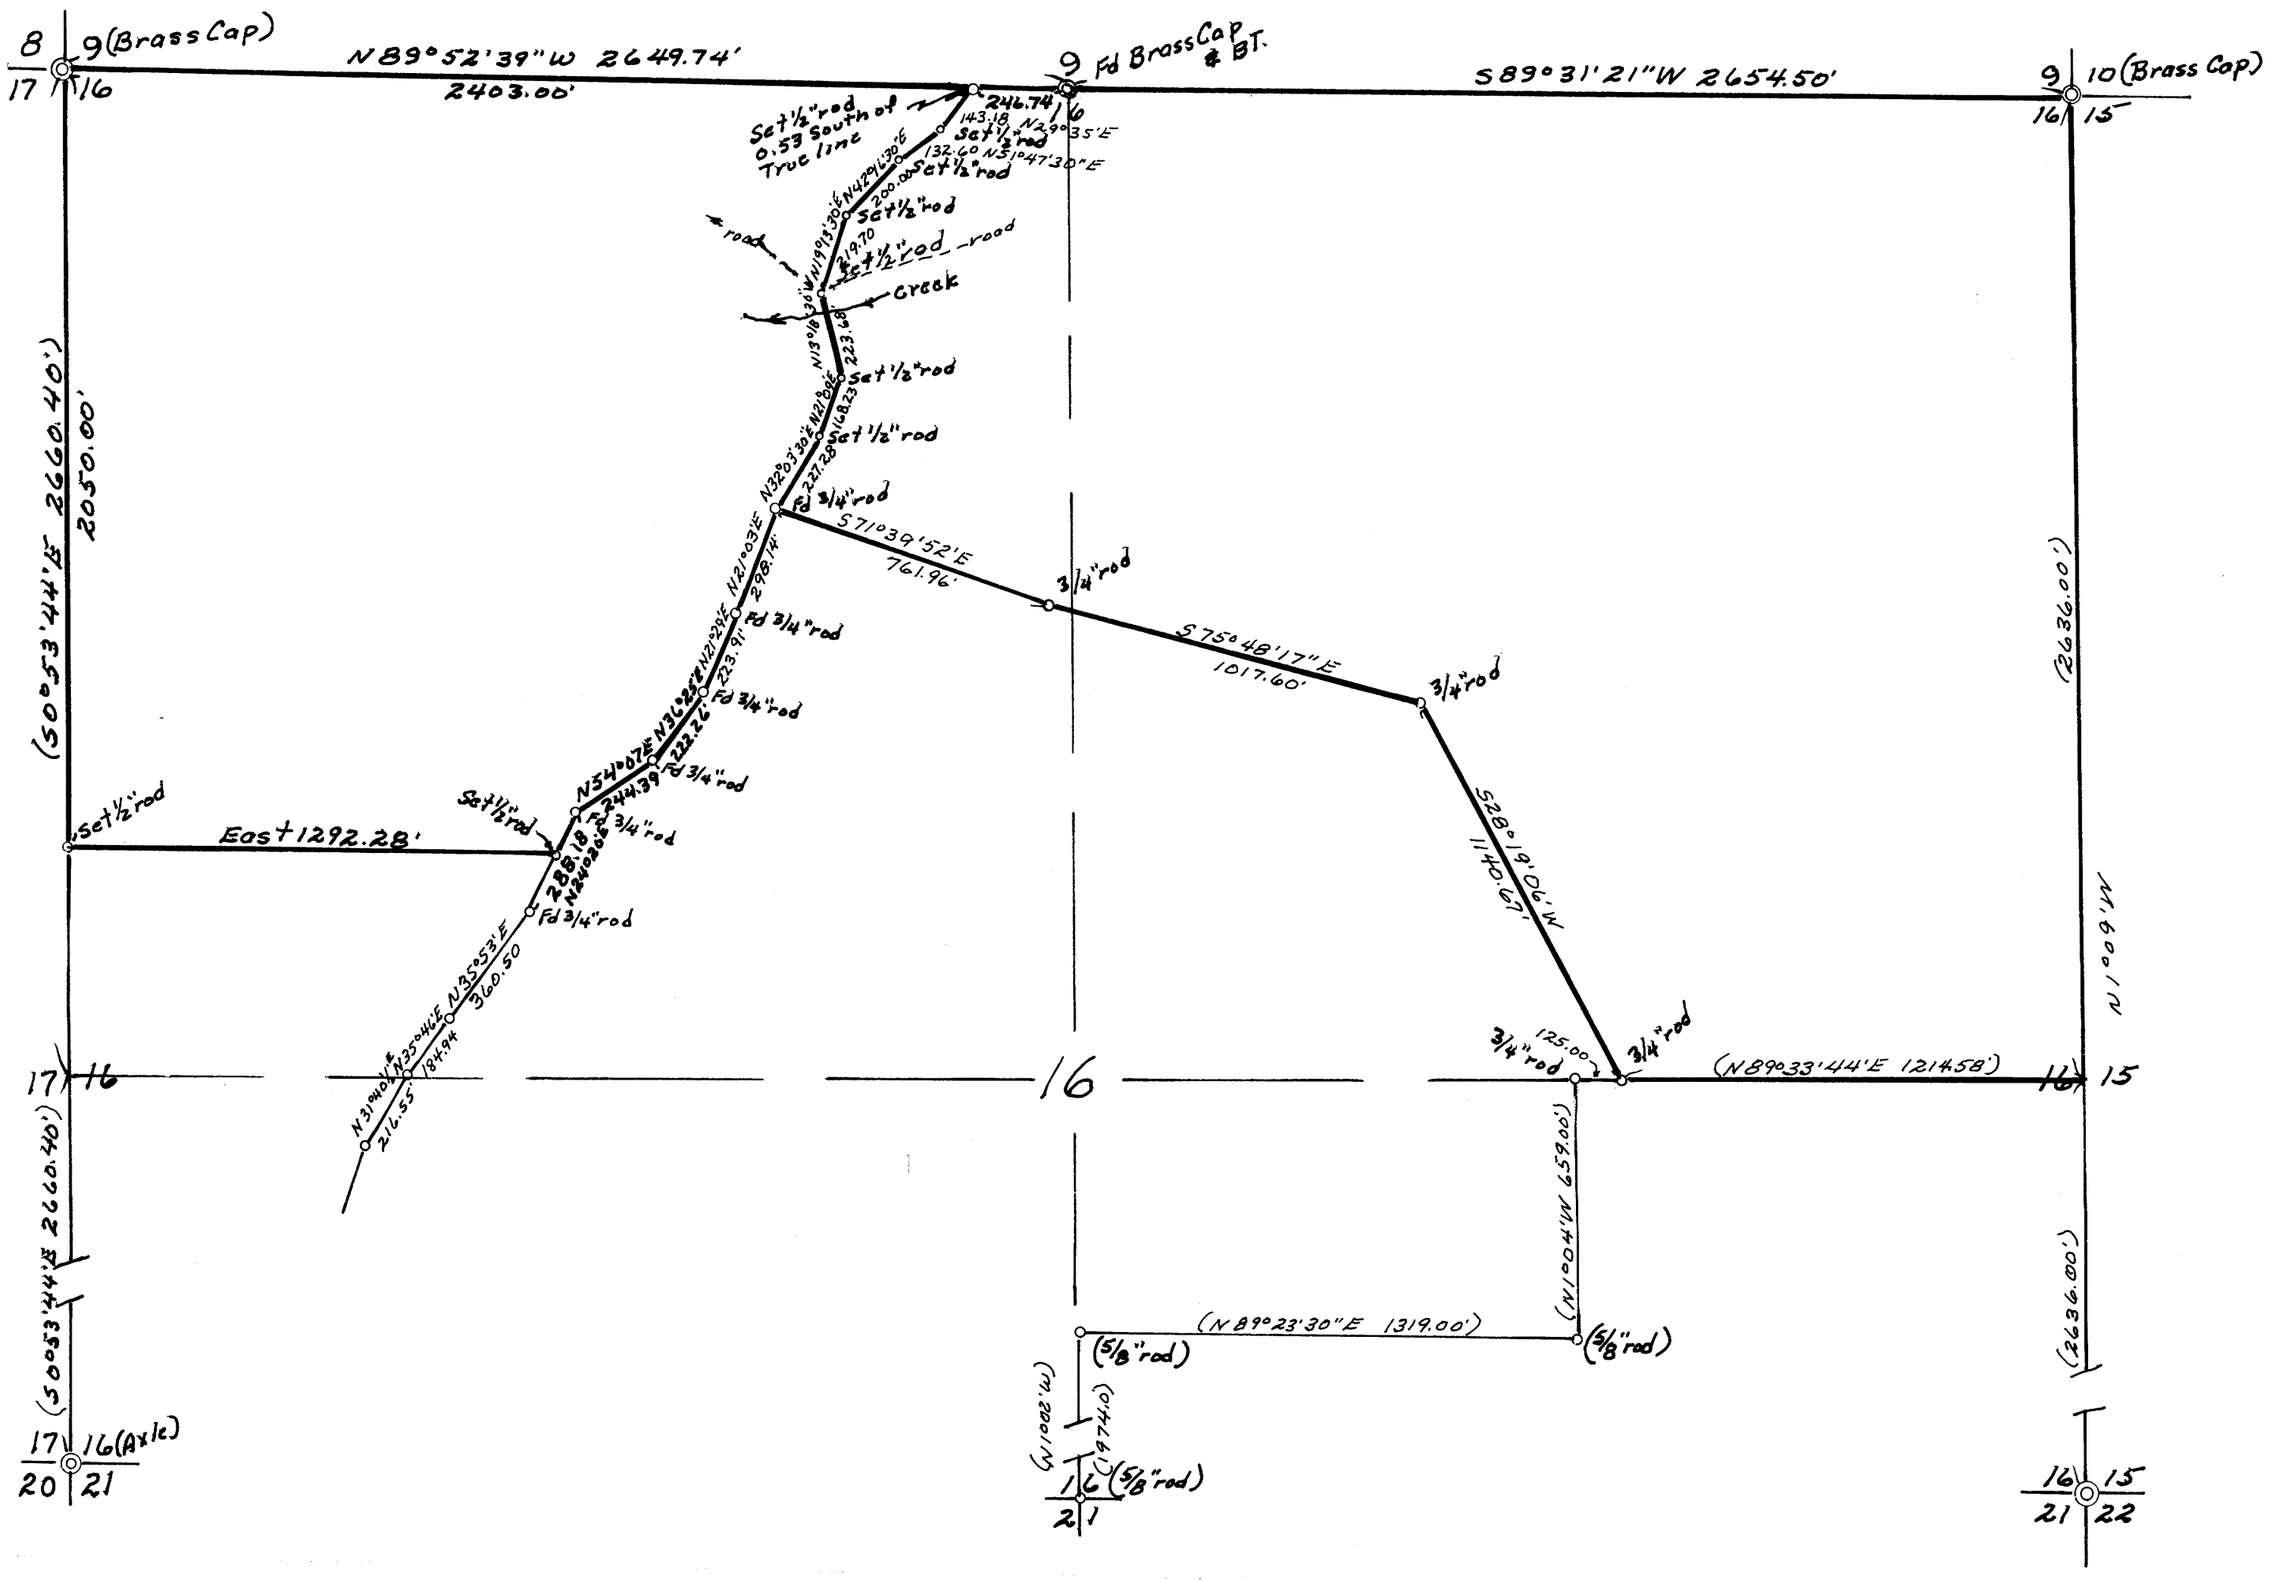

MAP FILE M 46-60
MAP FILE M 46-60