COUNTY SURVEYORS FILE COPY
DO NOT REMOVE FROM OFFICE

SURVEY FOR WALTER W. WHITFORD
SEC. 22 & 23, T. 30 S, R. 2 W, W.M.

Surveyed for Douglas County
Surveyed by Douglas County Surveyor's Office
Francis L. Ingram — County Surveyor
Scale: 1" = 100' — Sept., 1972

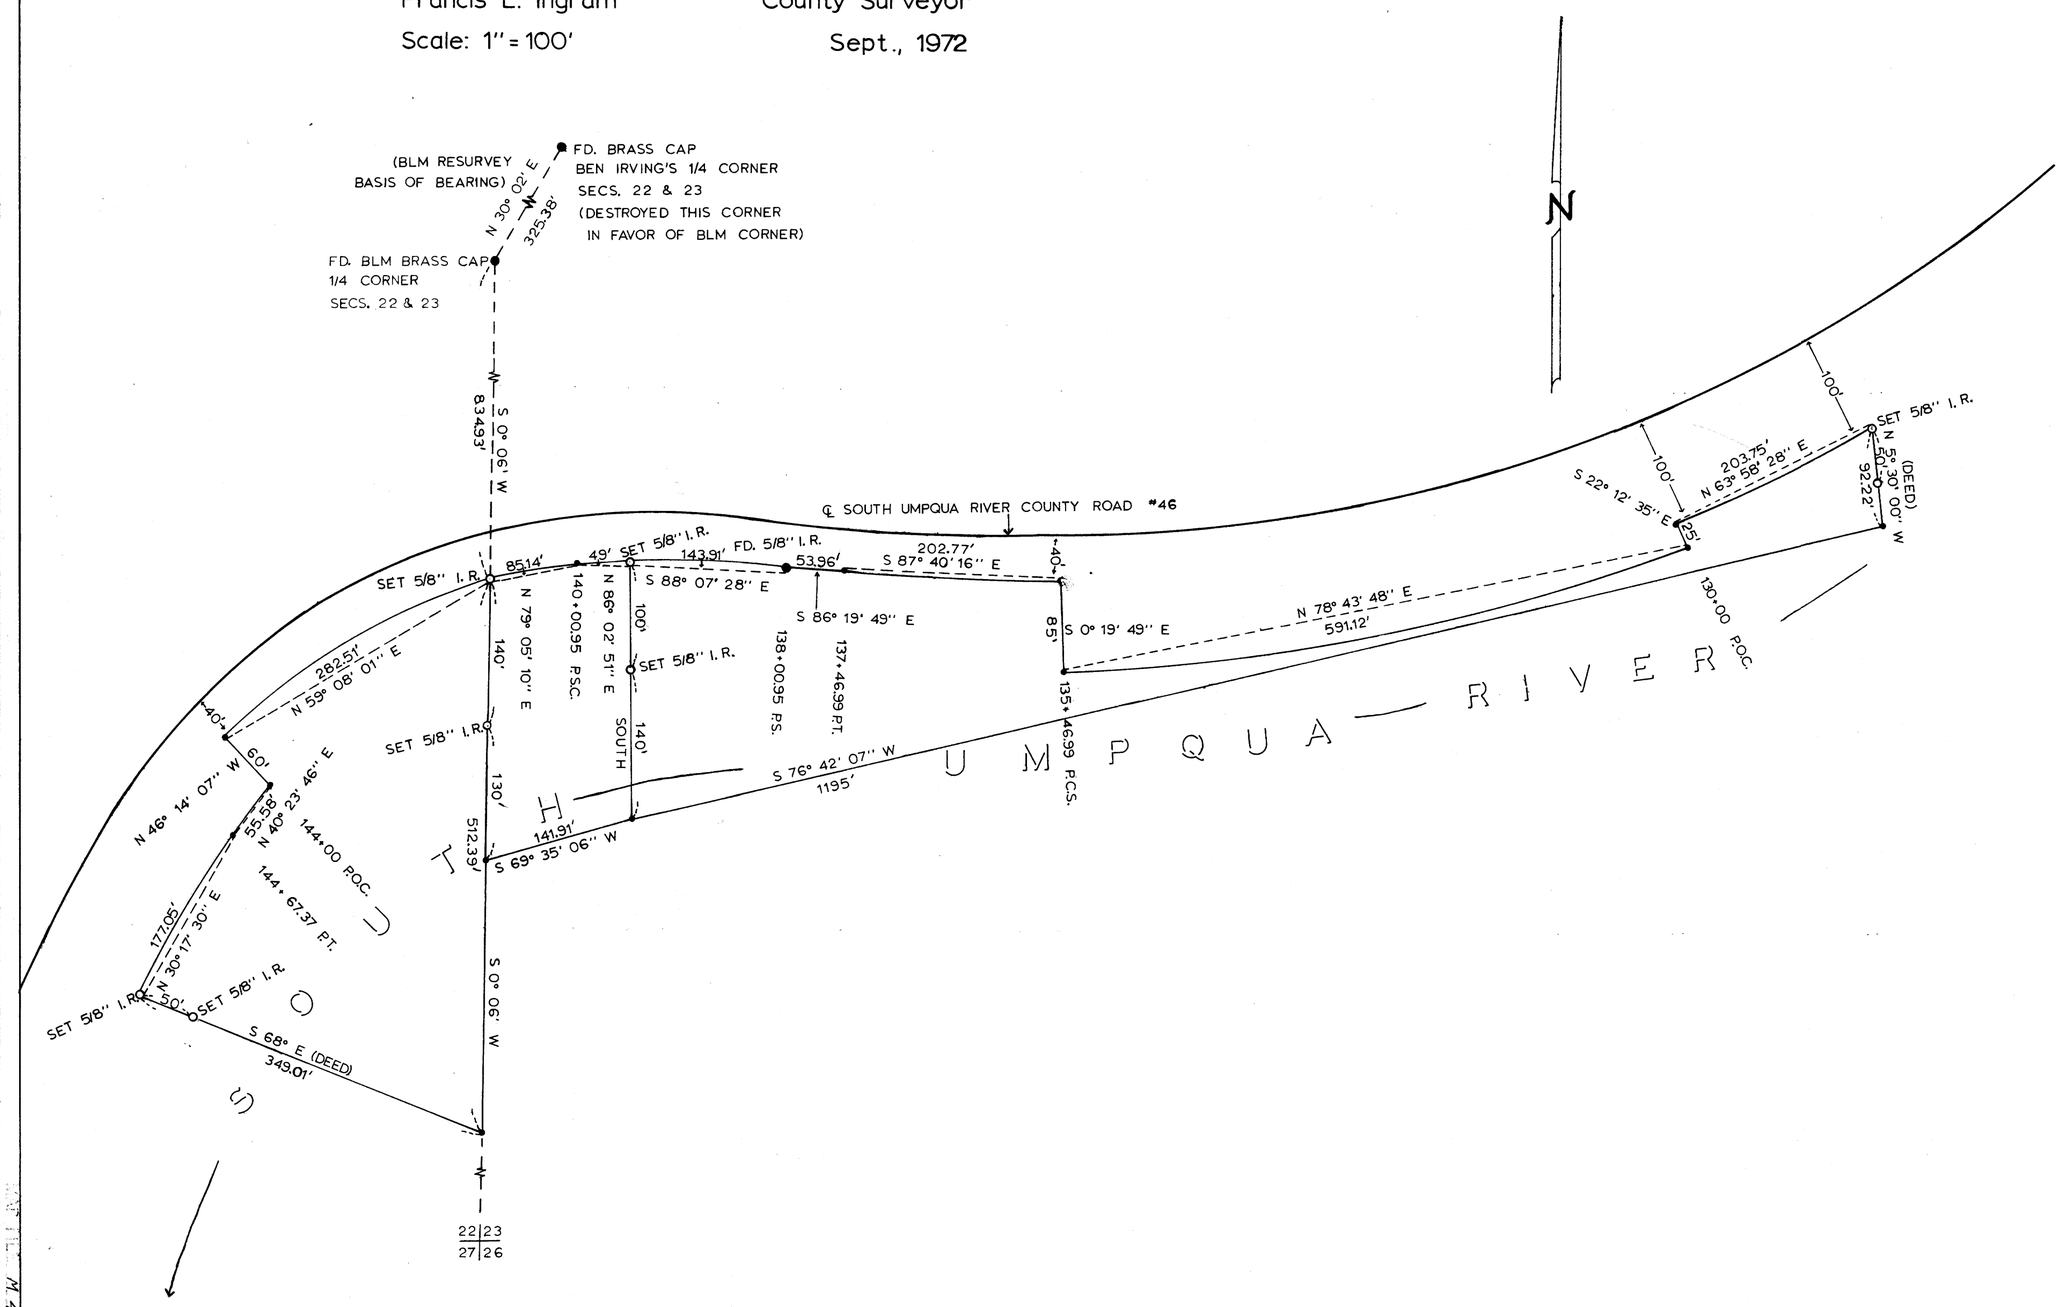

REGISTERED PROFESSIONAL LAND SURVEYOR
Francis L. Ingram
OREGON
JULY 11, 1969
FRANCIS L. INGRAM
902