SURVEY FOR DEED DESCRIPTION

IN LOT 7 DEER CREEK ORCHARDS PLAT "A" SEC. 14, T.27S., R.5 W.W.M.

FOR THE CONING CORP.

BY R.C. GRANT P.E.

o = 5/8" I.R. SET

SEPT. 1972

COUNTY SURVEYORS FILE DATA
DO NOT REMOVE FROM OFFICE

FILED
RECEIVED
OCT 24 1972
COUNTY SURVEYOR
DOUGLAS COUNTY, ORE.

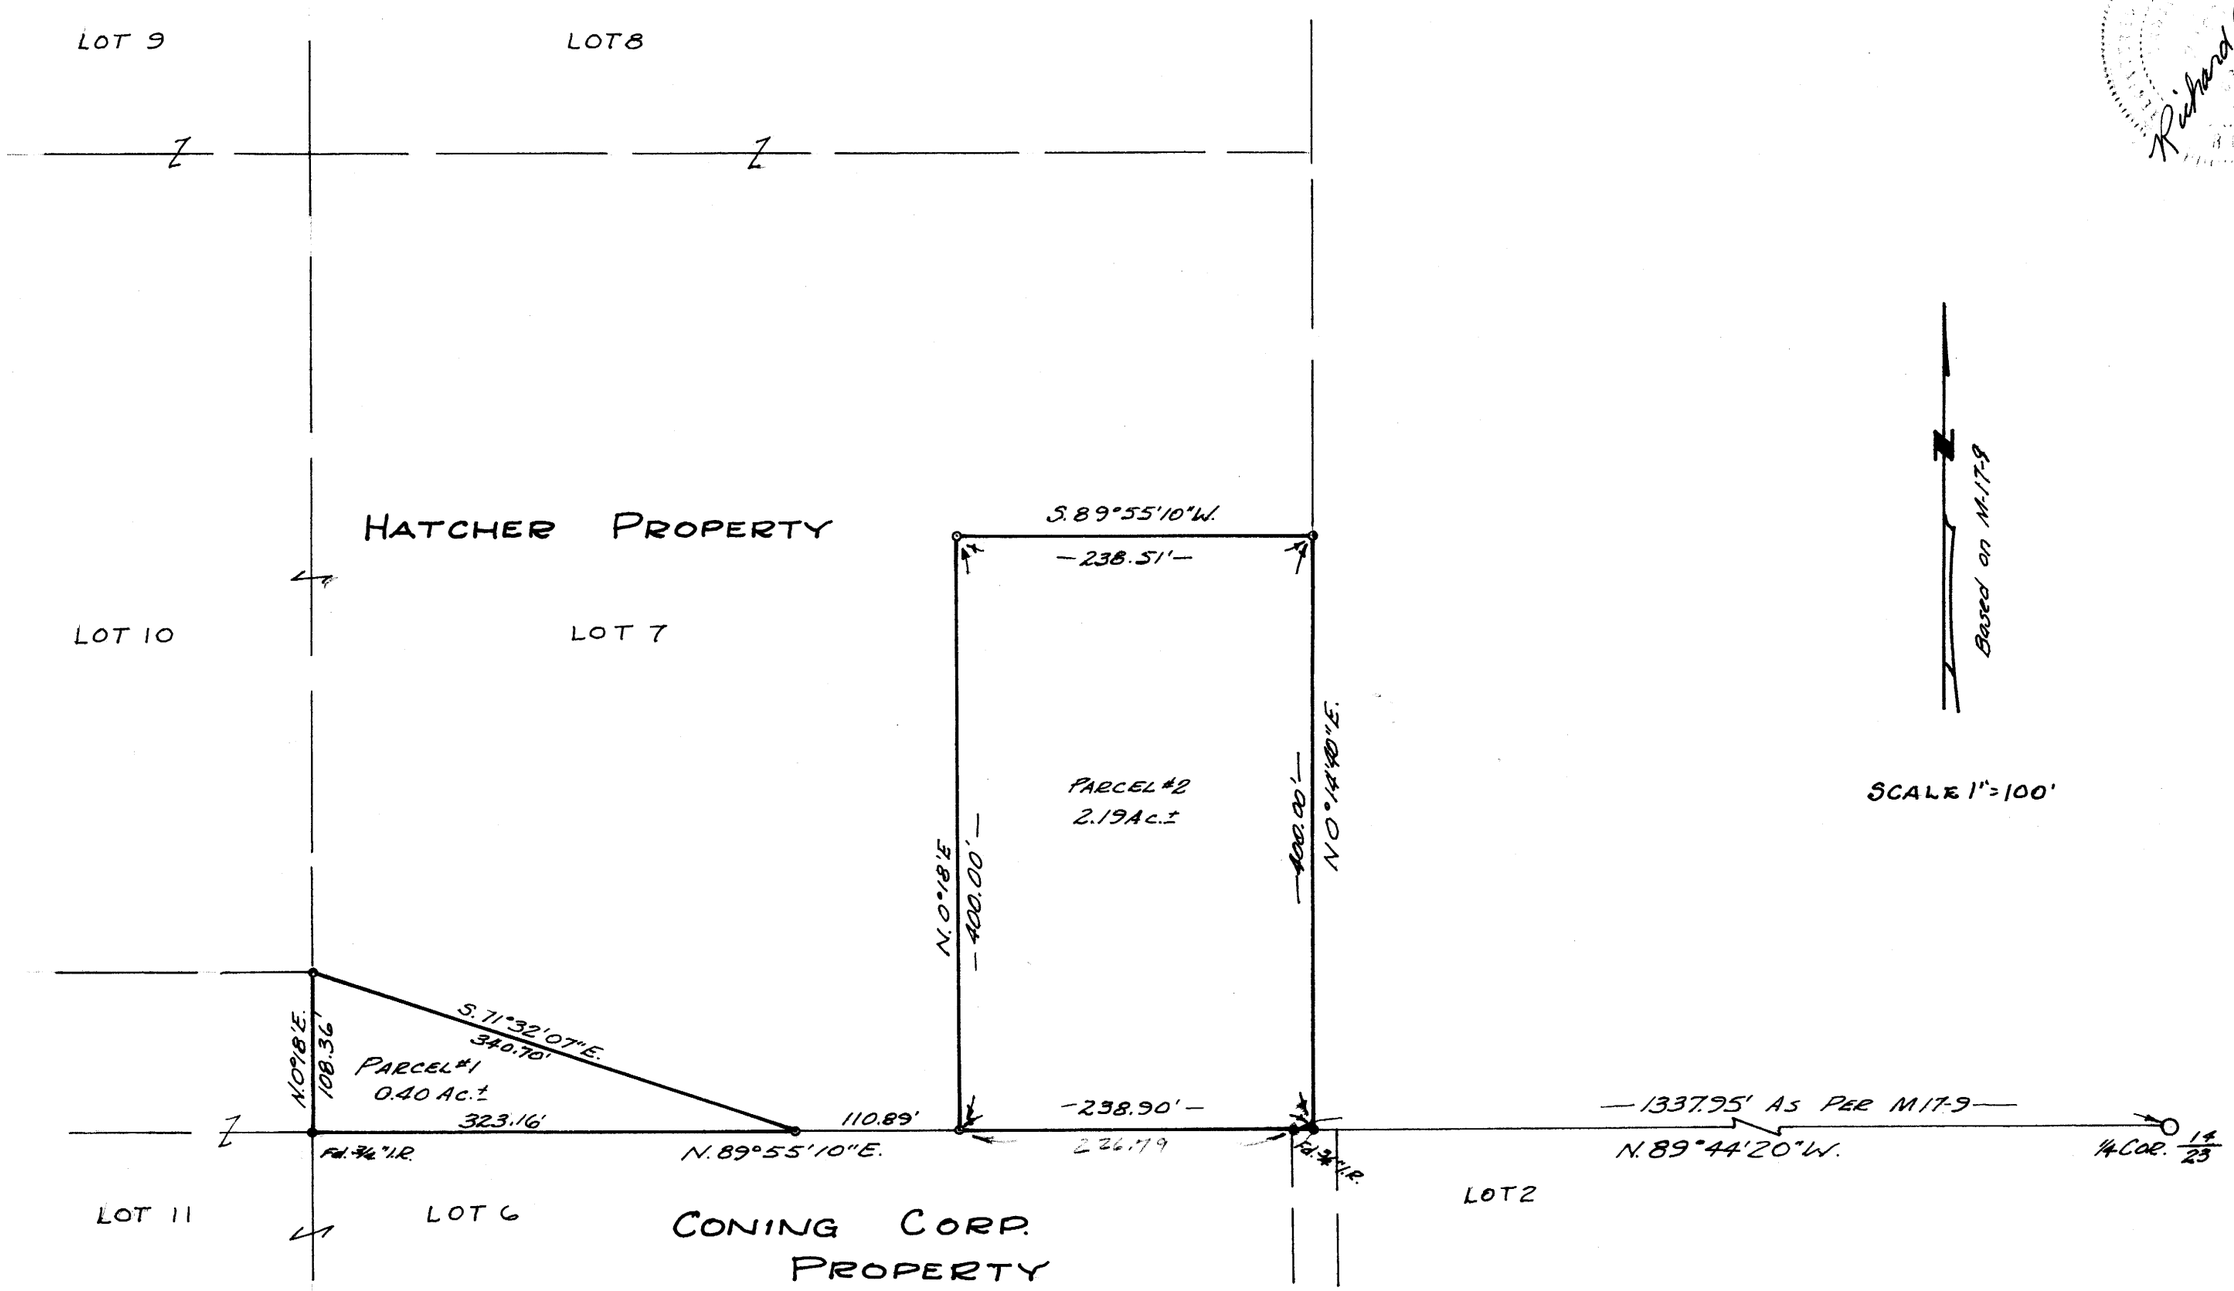

MAP FILE M 46 - 71

MAP FILE M 46 - 71