MAP FILE M46 - 72

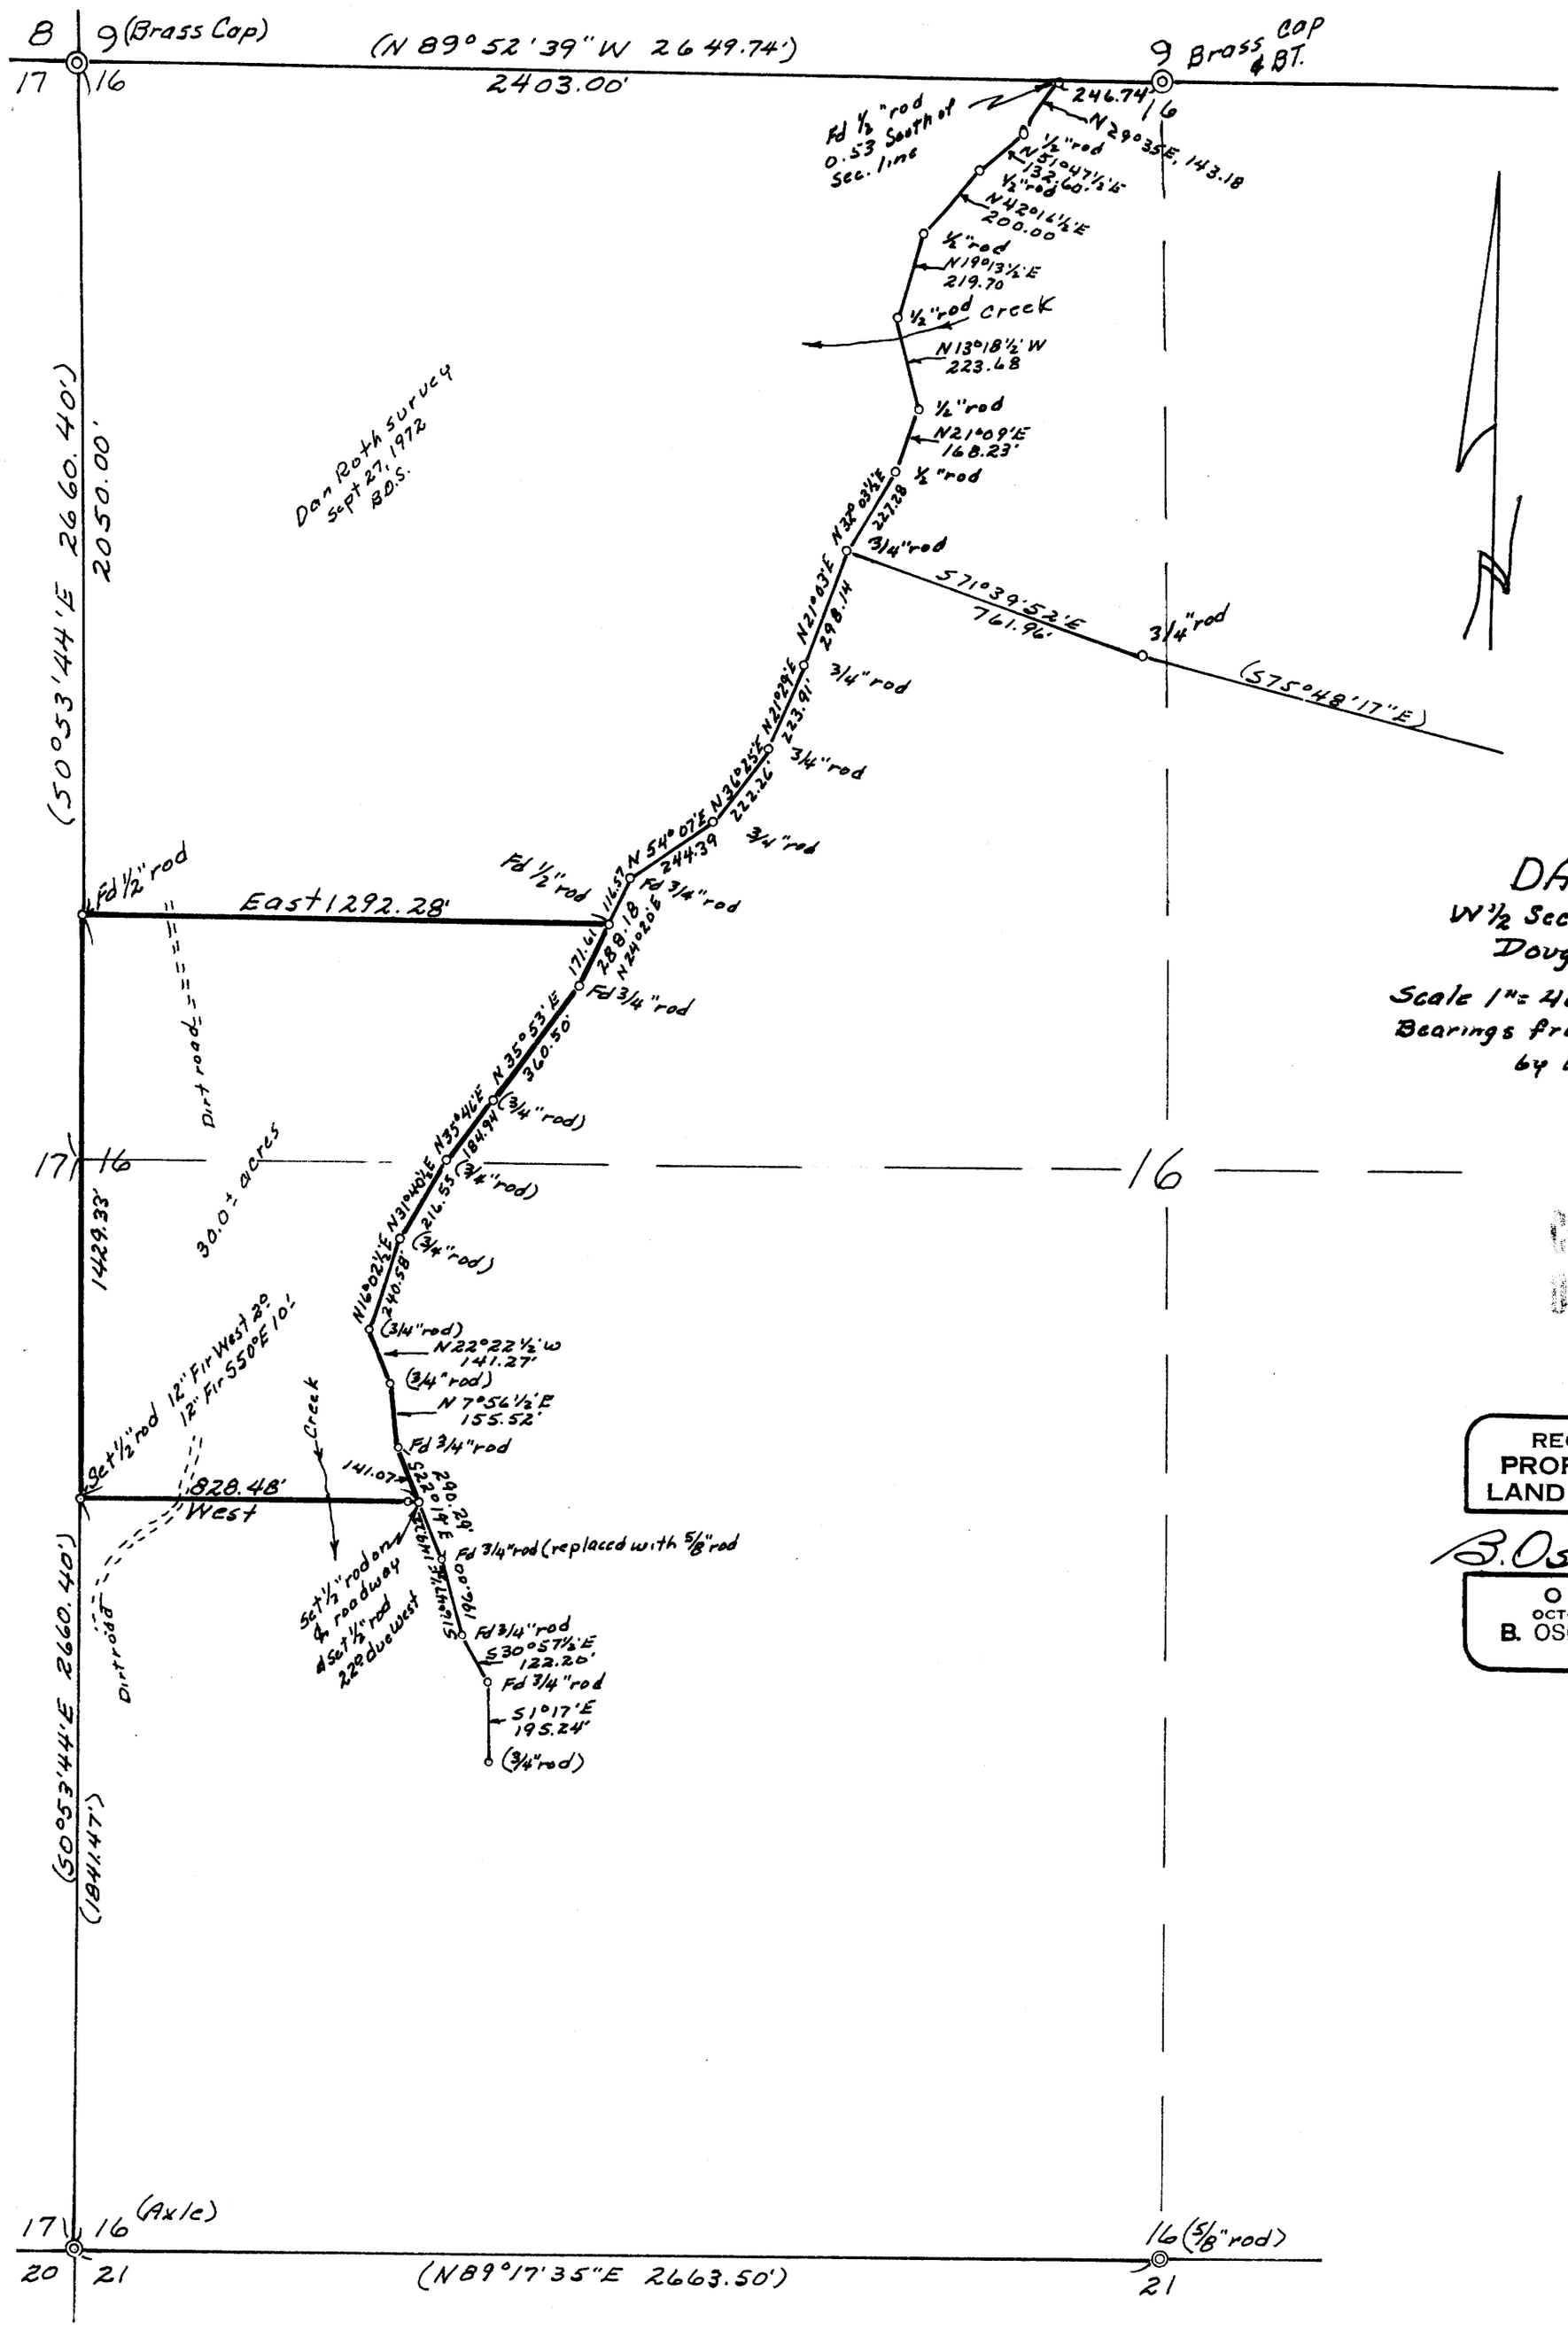

FILED
RECEIVED
OCT 25 1972
COUNTY SURVEYOR
DOUGLAS COUNTY, ORE.

DAN ROTH

W½ Sec 16, T.24S., R.7W. W.M.
Douglas County, Oregon

Scale 1" = 400' October 18, 1972
Bearings from Co. Survey for D. Brownson by W.S. Barnes (May 10, 1971)

B. Osburn Shaw
O.L.S. #431

COUNTY SURVEYORS FILE COPY
DO NOT REMOVE FROM OFFICE

REGISTERED
PROFESSIONAL
LAND SURVEYOR
B. Osburn Shaw
OREGON
OCTOBER 4, 1957
B. OSBURN SHAW
431

MAP FILE M46 - 72