MAP FILE M46-78

COUNTY SURVEYORS FILE DATA
DO NOT REMOVE FROM OFFICE

SURVEY OF PARCEL IN SECTION 6, T.29S., R.6W., W.M., DOUGLAS COUNTY, OREGON FOR ELZIE CLAYTON, KENT CREEK ROAD, DILLARD, ORE.

BY HERBERT L. NORTHCRAFT SCALE 1"=100 SEP. & OCT. 1972

FILED
RECEIVED
NOV 7 1972
COUNTY SURVEYOR
DOUGLAS COUNTY, ORE.

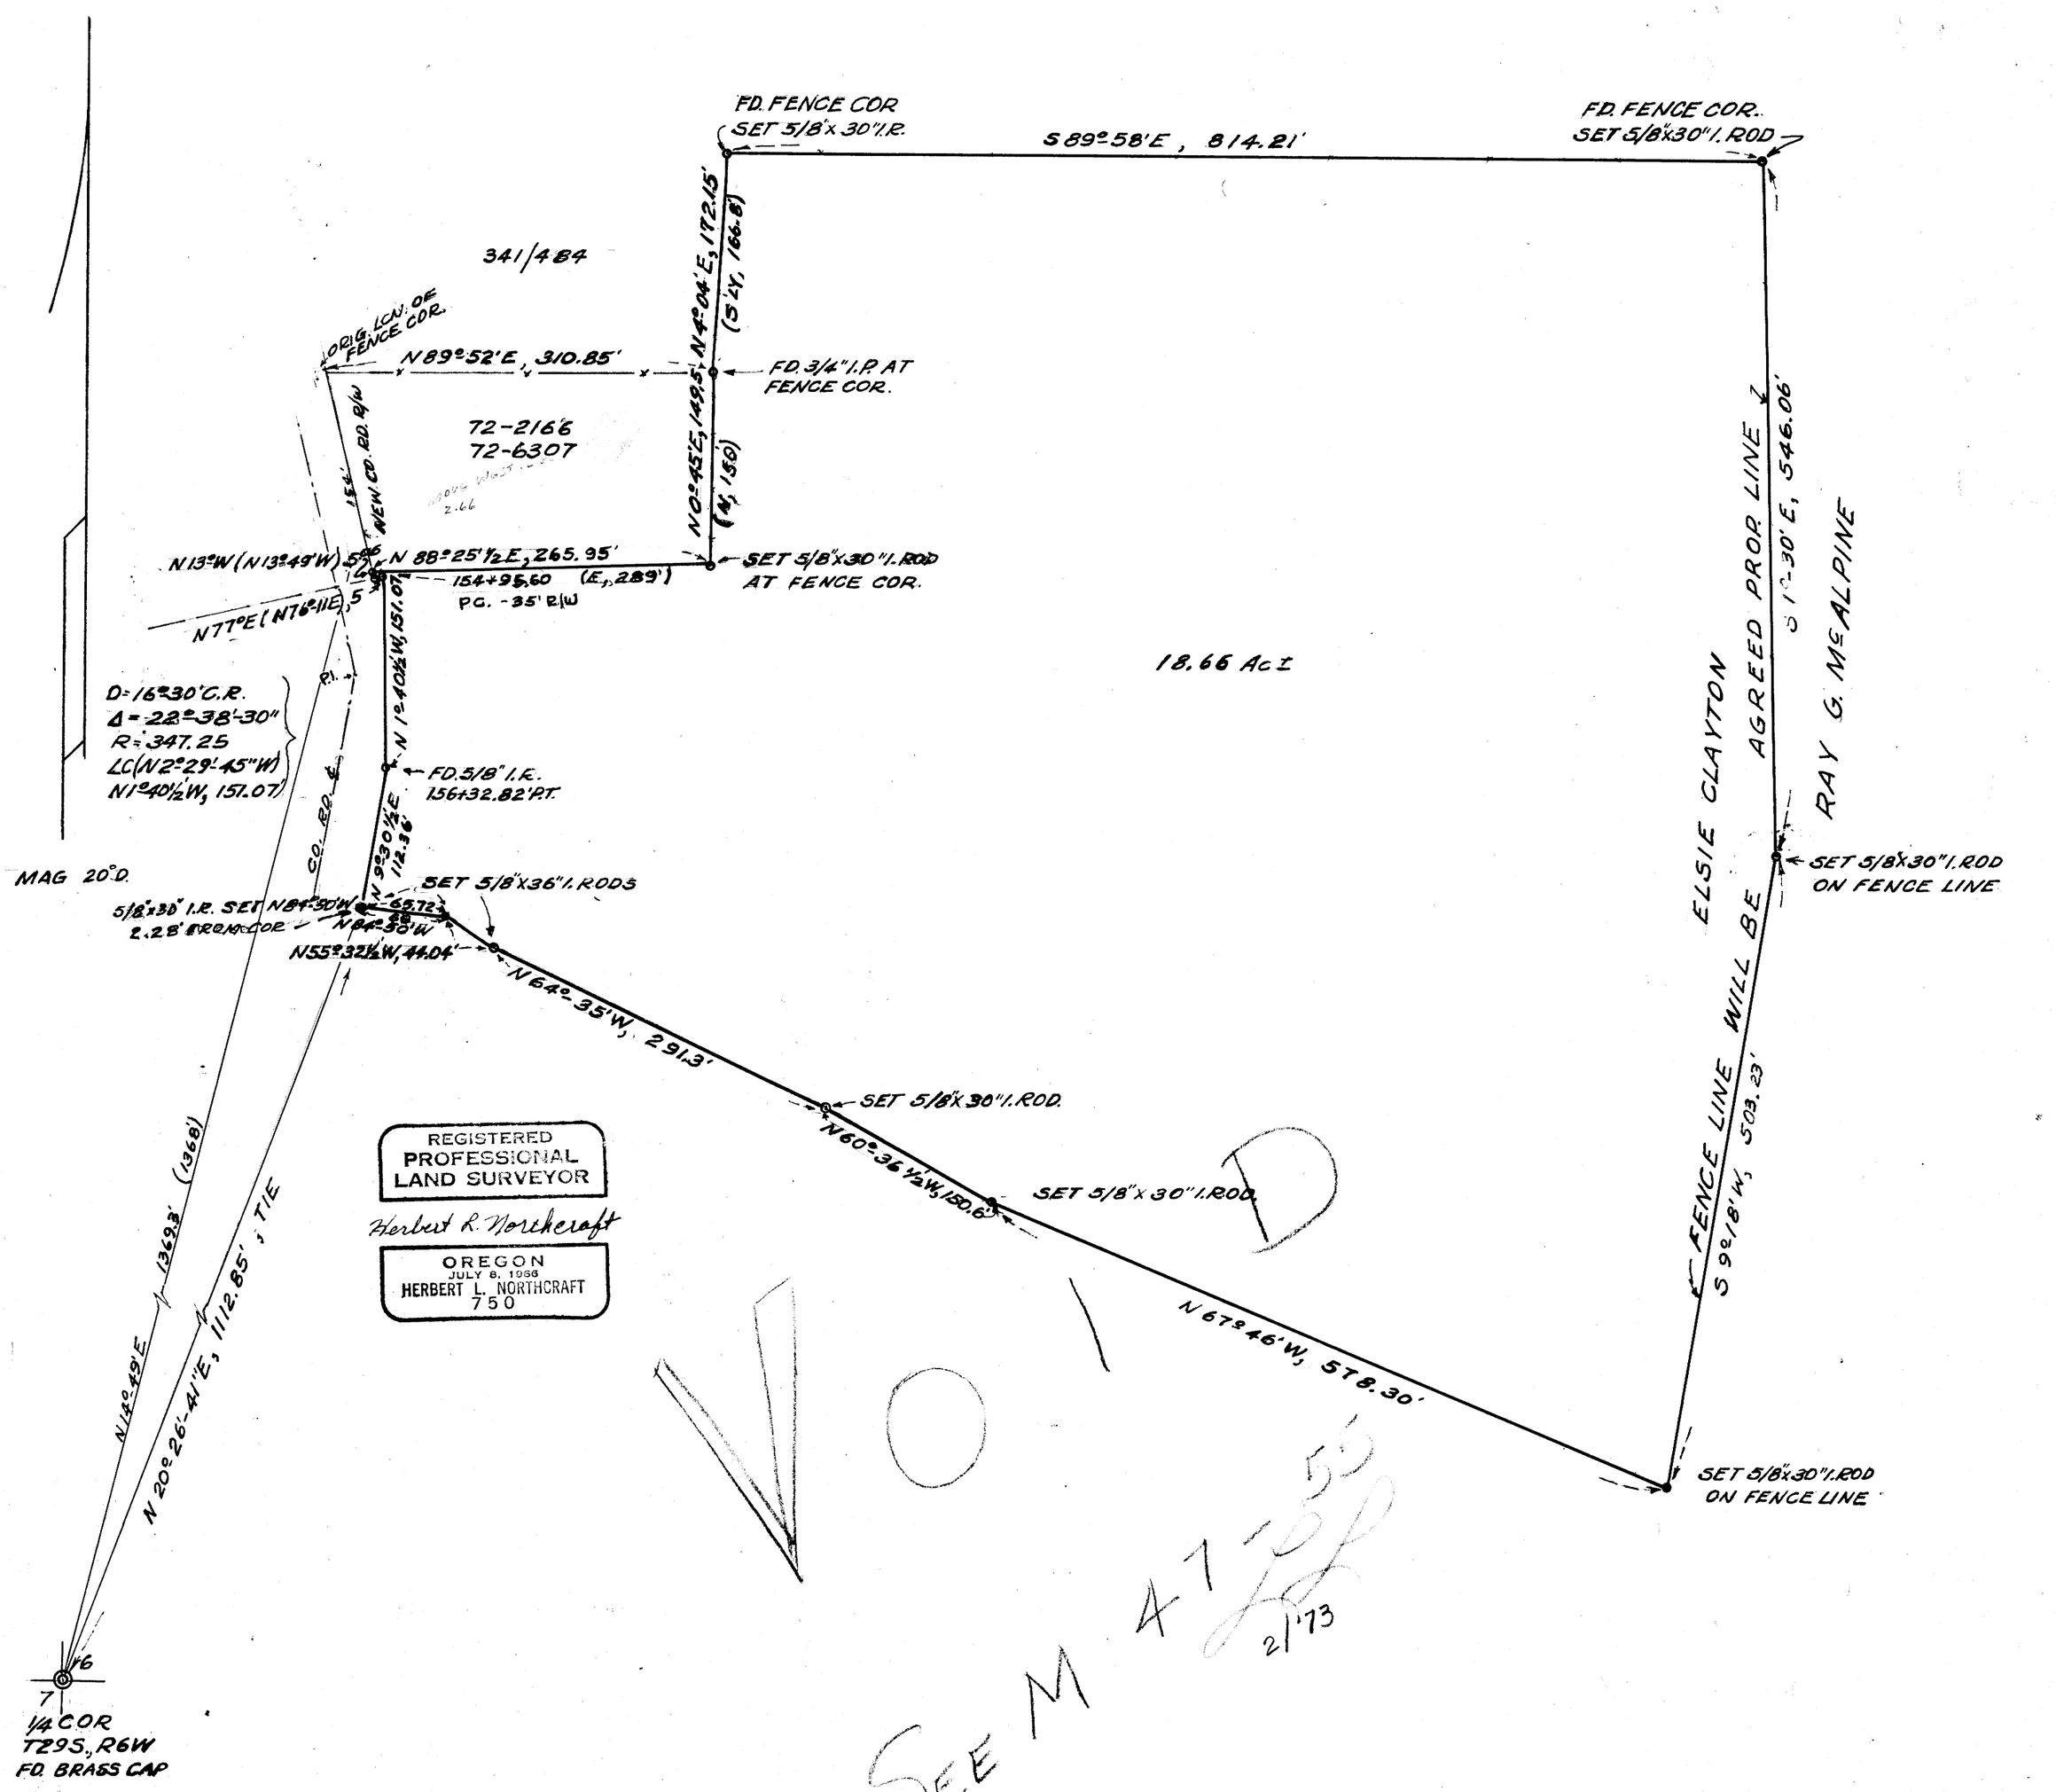

REGISTERED PROFESSIONAL LAND SURVEYOR
Herbert R. Northcraft
OREGON
JULY 8, 1966
HERBERT L. NORTHCRAFT
750

VOID

SEE MAP 47-55
2/'73

P MAP FILE M46-78