COUNTY SURVEYORS FILE DATA
DO NOT REMOVE FROM OFFICE

SURVEY TO LOCATE PROPERTIES IN SECTION 30
T. 30 S., R. 5 W., W.M., DOUGLAS COUNTY, OREGON A/C 409/388
FOR WESLEY W. LARSEN - MYRTLE CREEK, OREGON

BY HERBERT L. NORTHCRAFT SCALE 1" = 100' MAY & JUNE 1972

FILED
RECEIVED
JUL 13 1972
COUNTY SURVEYOR
DOUGLAS COUNTY, OREG.

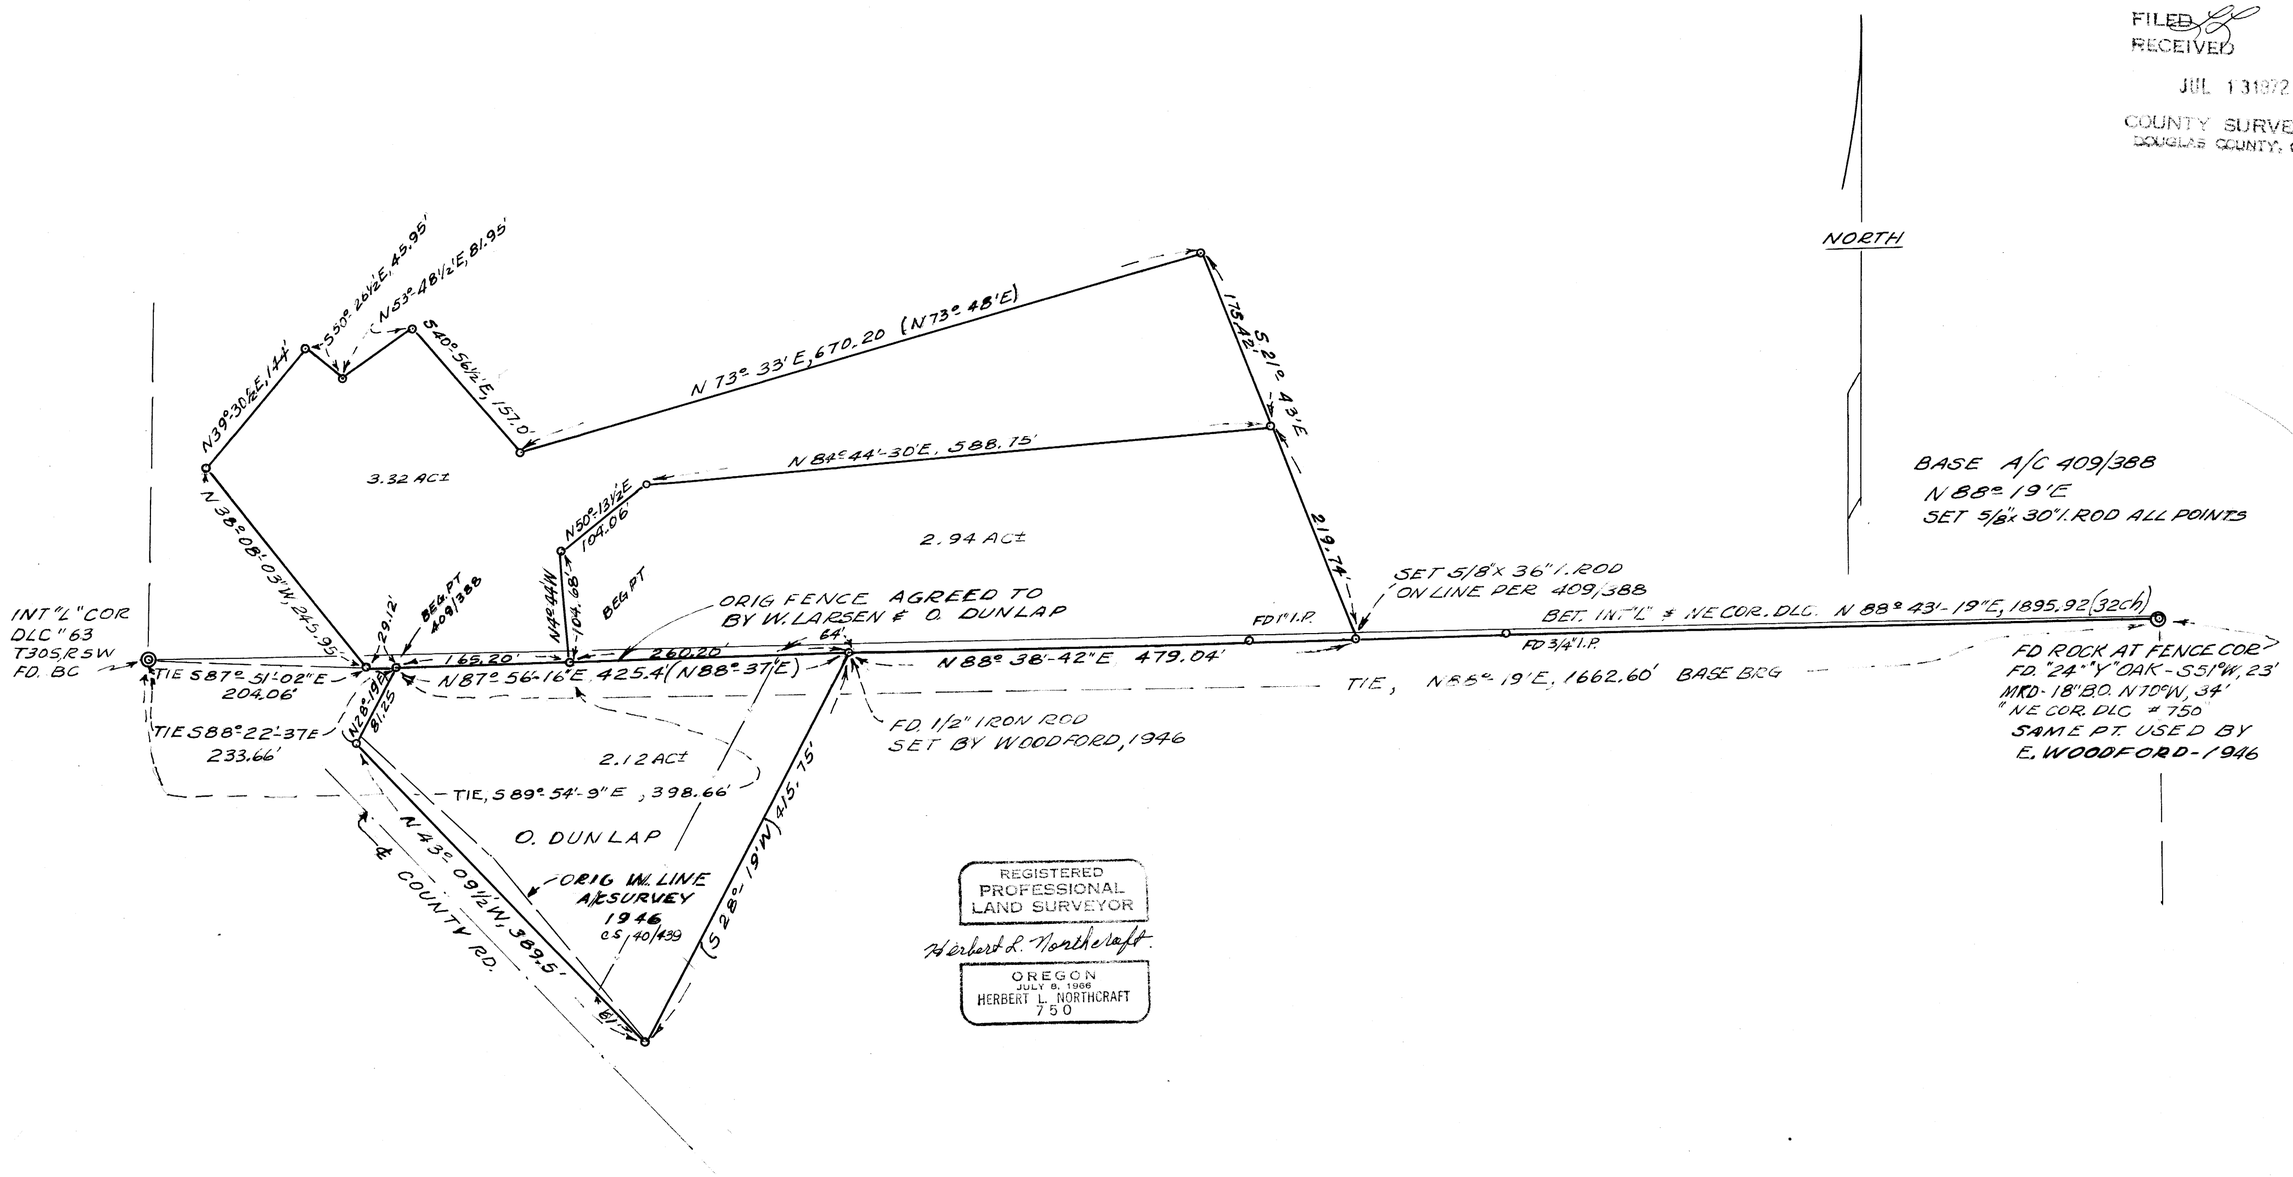

REGISTERED
PROFESSIONAL
LAND SURVEYOR
Herbert L. Northcraft
OREGON
JULY 8, 1966
HERBERT L. NORTHCRAFT
750

MAP FILE M 46 - 9

MAP FILE M 46 - 9