COUNTY SURVEYORS FILE DATA
DO NOT REMOVE FROM OFFICE

FILED
RECEIVED
NOV 10 1972.
COUNTY SURVEYOR
DOUGLAS COUNTY, ORE.

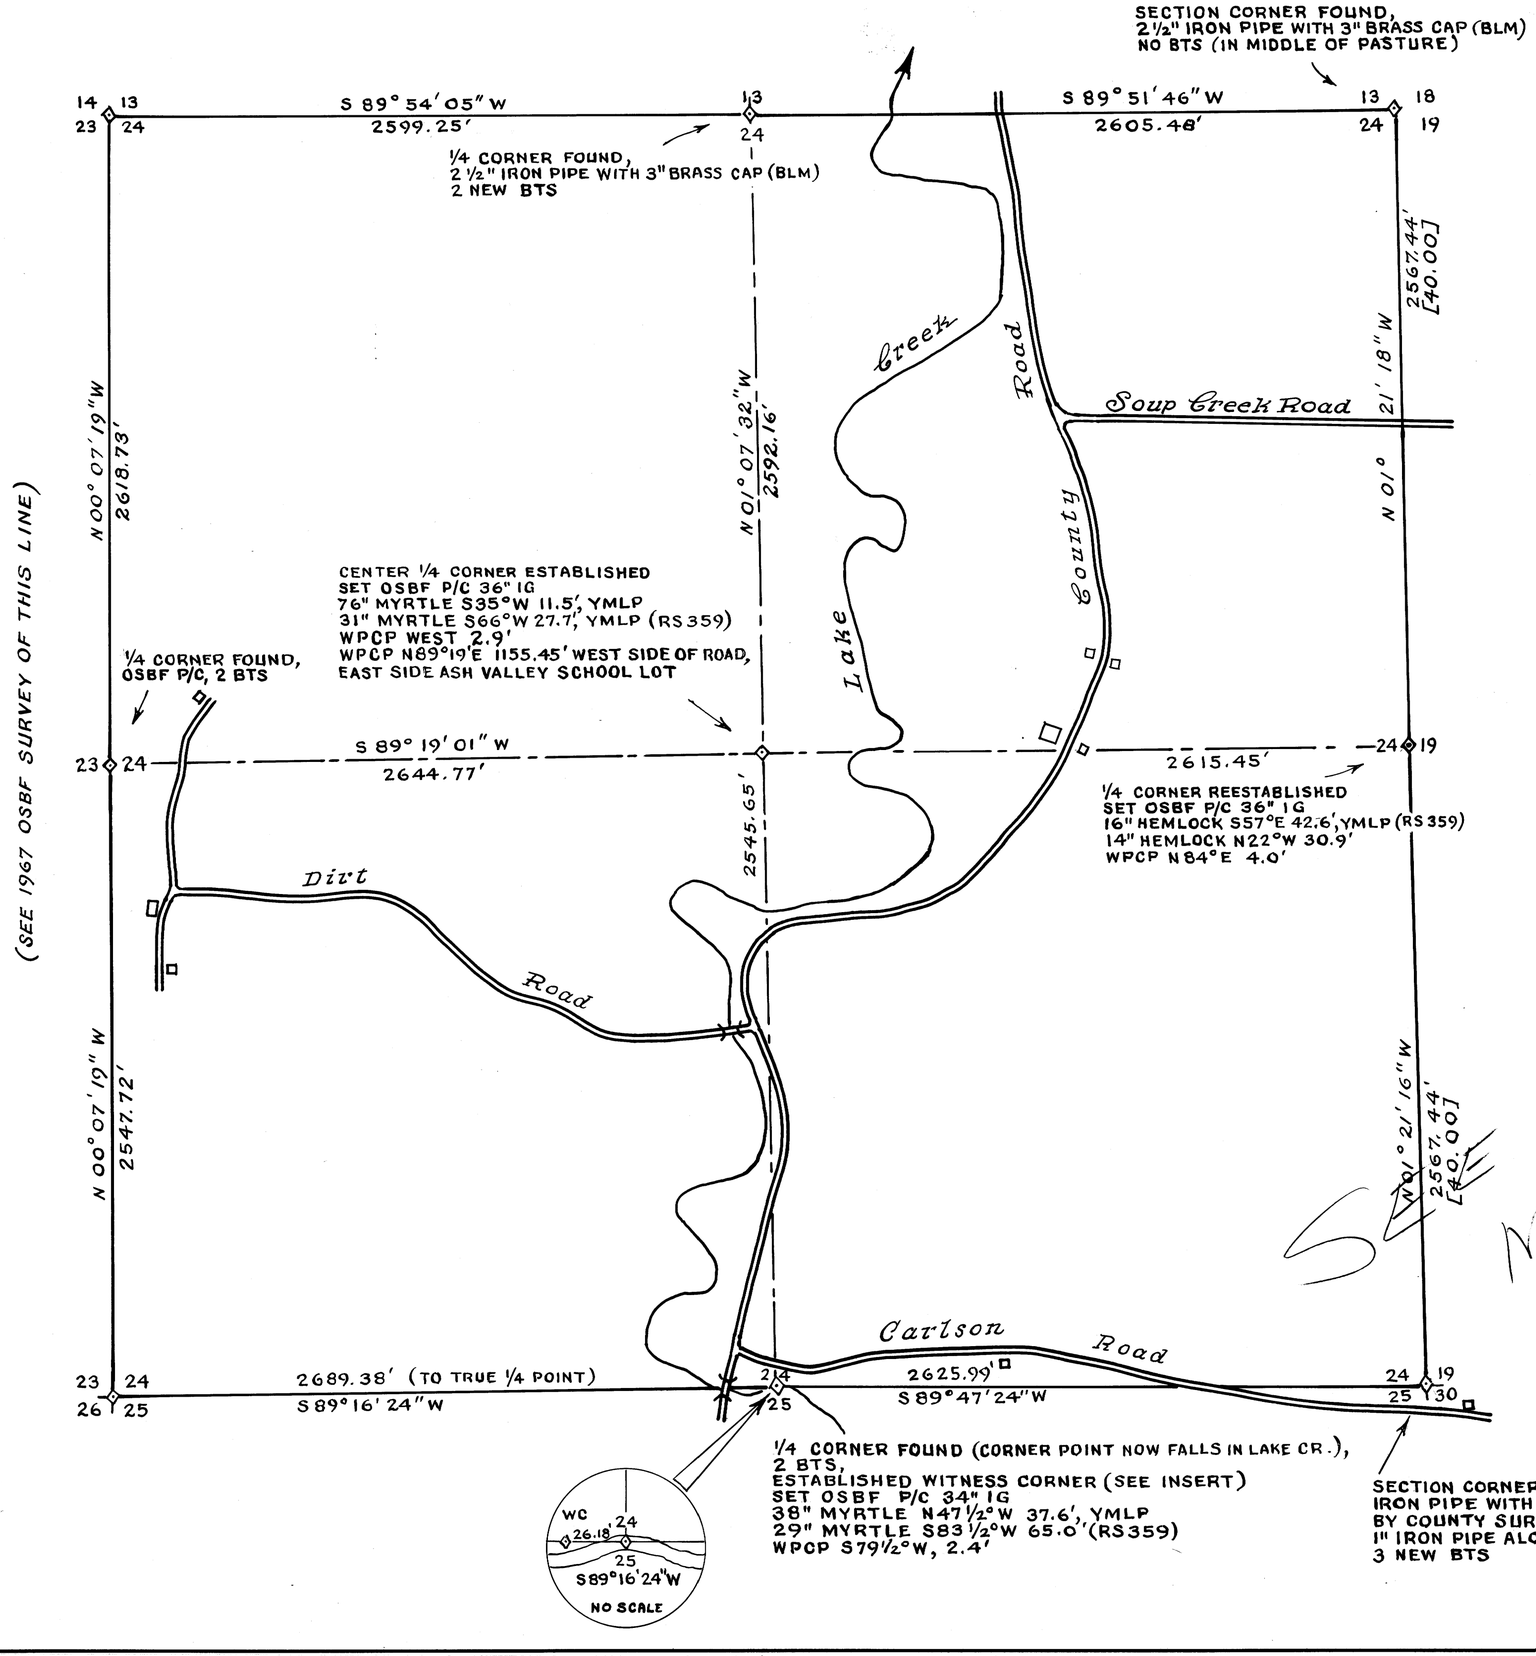

L E G E N D

OSBF P/C = OREGON STATE BOARD OF FORESTRY 1 1/2" x 36" GALVANIZED IRON PIPE WITH 3" BRASS CAP
WPCP = 4" x 4" x 72" WHITE PAINTED CEDAR POST
YMLP = YELLOW METAL LOCATION POSTER
I G = IN GROUND
BTS = BEARING TREES
[ ] = RECORD DISTANCE IN CHAINS

FOR DETAILED REPORT ON FOUND CORNERS SEE COUNTY RECORDS. NEW CORNERS AND ACCESSORIES MARKED ACCORDING TO THE "MANUAL OF INSTRUCTIONS FOR THE SURVEY OF THE PUBLIC LANDS OF THE U.S."

(_____) = OTHER MARKINGS AS INDICATED
DISTANCES TO FACES ON NEW BTS
ESTABLISHED = NEW CORNERS SET
REESTABLISHED = LOST GLO, CADASTRAL OR OTHER CORNER RESET BY PROPORTIONATE MEASUREMENT OR AS NOTED.

SOLAR OBSERVATION

AS TAKEN BY E. D. KUCERA FOR SECTION LINE 23 & 24, T23S, R10W, WM, OSBF SURVEY 1967

N

REGISTERED
PROFESSIONAL
LAND SURVEYOR
Arnold G. Gibson
OREGON
NOV. 4, 1955
ARNOLD G. GIBSON
359

REVISED MAP M 80-40

SURVEY FOR:
STATE OF OREGON — DEPARTMENT OF FORESTRY

SECTION 24, T23S, R10W, WM

DOUGLAS COUNTY, OREGON

TRANSIT & CHAIN SURVEY BY: R. SHEPARD, S. NICHLSON, D. REDDING, S. CONOVER & W. COOK
DRAWN BY: R. SHEPARD
JUNE 29, 1972
SCALE: 1" = 400'

B-91
8-18-72 H. HAYES

MAP FILE M 47-1