COUNTY SURVEYORS FILE DATA
DO NOT REMOVE FROM OFFICE

# ROAD CONTROL SURVEY
## Rice-Willis Creek County Road No. 43 + 88
## T. 28 & 29 S., R. 5 & 6 W., W.M.

FILED
RECEIVED
JAN 9 1973
COUNTY SURVEYOR
DOUGLAS COUNTY, ORE.

C. S. File No. 56/23 — MAP FILE M 47 - 25

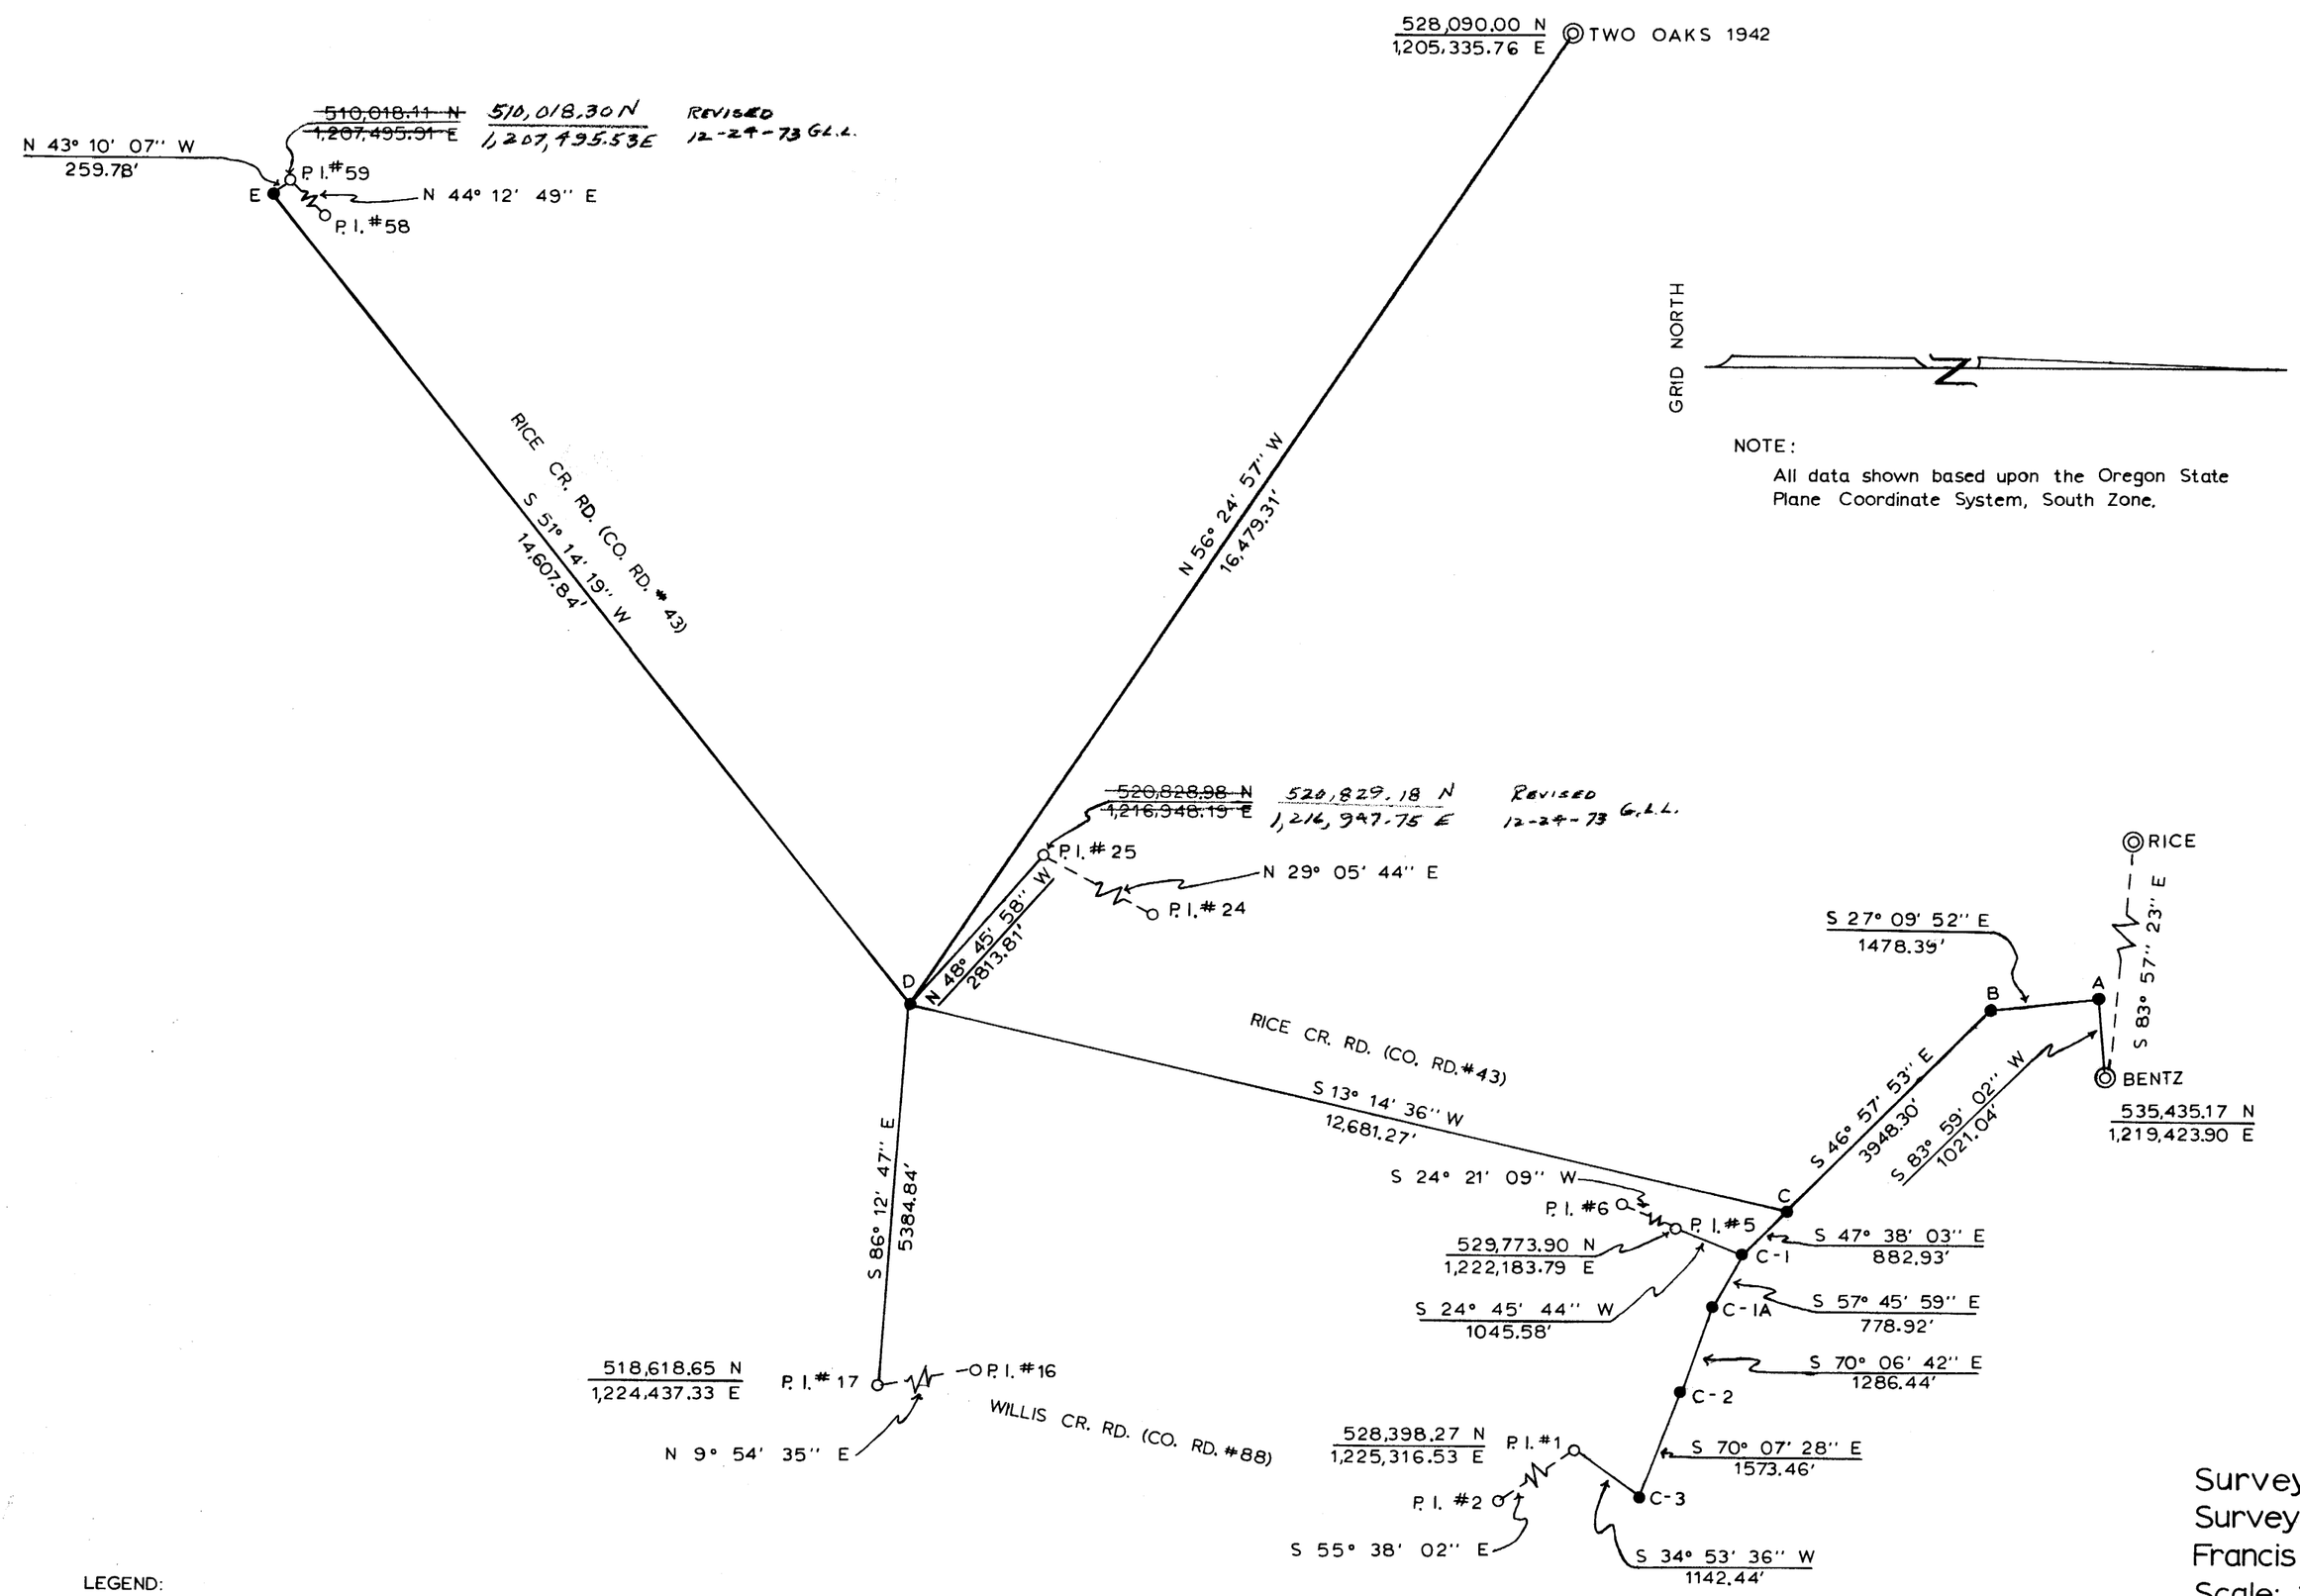


REGISTERED
PROFESSIONAL
LAND SURVEYOR
Francis L. Ingram
OREGON
JULY 11, 1969
FRANCIS L. INGRAM
902

LEGEND:

- ◎ Concrete monument found
- ○ Boat spike found
- ● ~~5/8" iron rod set~~ TRAVERSE POINTS

Surveyed for Douglas County
Surveyed by Douglas County Surveyor's Office
Francis L. Ingram — County Surveyor
Scale: 1" = 2000' — Dec., 1972

C. S. File No. 56/23 — MAP FILE M 47 - 25