SURVEY TO DESCRIBE A PORTION OF LOT 6, BLOCK 5, OF DILLARD BOTTOM SUBDIVISION IN SECTION 29, T. 28 S., R. 6 W., W.M., DOUGLAS, COUNTY, ORE.

FOR MRS. V.J. MICELLI, WASHINGTON ST., ROSEBURG, ORE.

BY HERBERT L. NORTHCRAFT

COUNTY SURVEYORS FILE COPY
DO NOT REMOVE FROM OFFICE

SCALE 1" = 40'

FEB. 1973

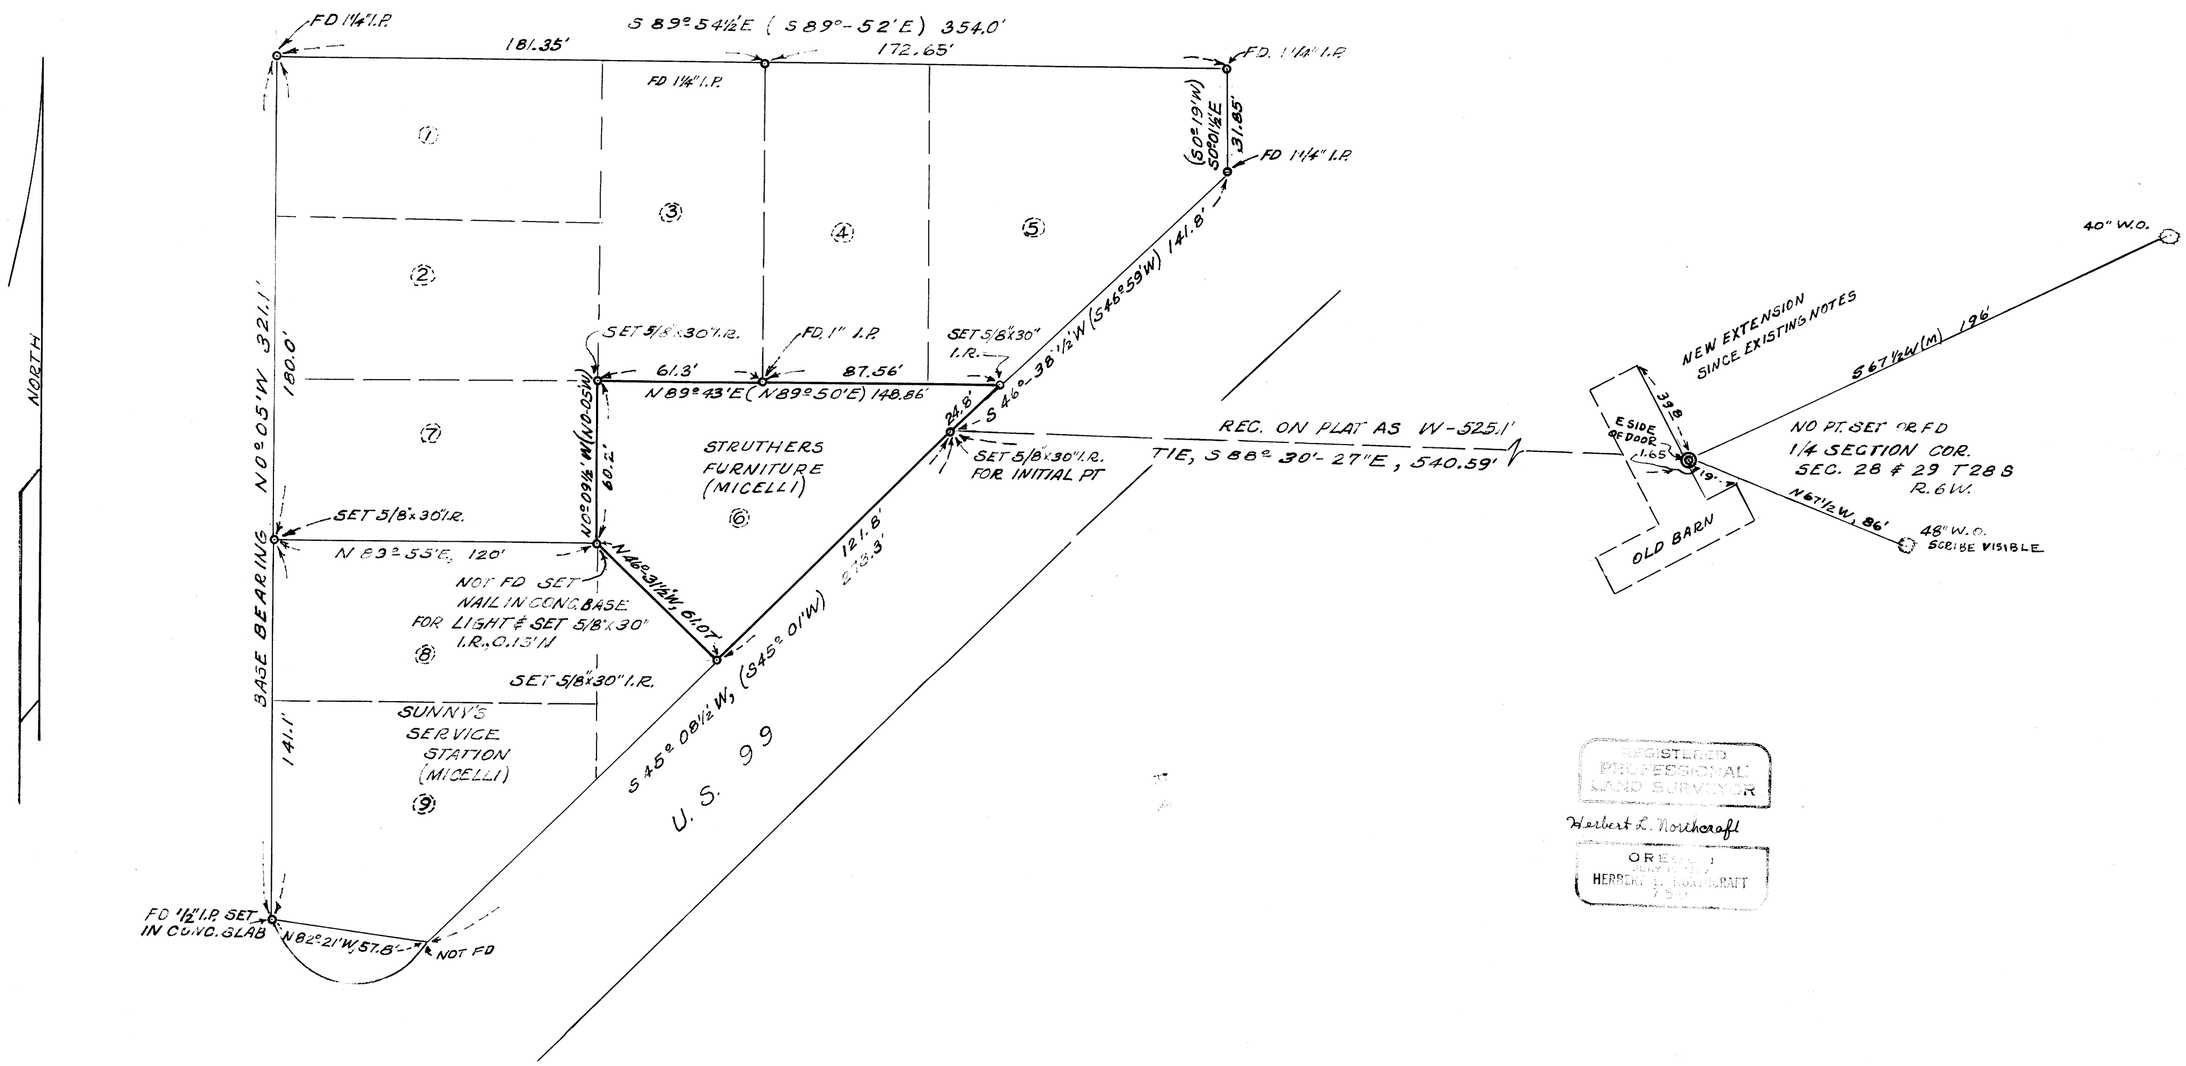

REGISTERED PROFESSIONAL LAND SURVEYOR

Herbert L. Northcraft

OREGON JULY 10, 1967 HERBERT L. NORTHCRAFT 750

M 47 - 54